IREDELL COUNTY HEALTH DEPARTMENT

STATESVILLE 704-878-5305 50.00 Paid MOORESVILLE 704-664-5281

IMPROVEMENT PERMIT / AUTHORIZATION TO CONSTRUCT / OPERATION PERMIT / EXISTING SYSTEM INSPECTION

PERMIT# 16228 092383 PIN# ~~4639-73-4457~~ (pt.) 4639444150.000 DATE 5/3/04

OWNER OR CONTRACTOR Charlotte Wirth PHONE: Business 704-662-8471 Home

ADDRESS 121 Birdie Ct. Mooresville, NC. 28117

LOCATION Perth N to Fern Hill to Wildwood Cove, 4th lot on (L)

SUBDIVISION Wildwood Cove BLOCK / SECTION LOT 4 LOT AREA 51,250 Ft² SITE CLASS. PS DESIGN FLOW 360 L.T.A.R. .3

Septic Tank: 1000 Gallons; STB 794 Date 2/04
Pump Tank: 1000 Gallons; PT 27 Date 2/04
Pump Make: Zoeller Model WEG-511H Serial No. D0459047
Nitrification Field: No Fields 1 Square Feet 900 Linear Feet 300±
No Lines 4 @ 75' Trench Width 3' Max Trench Bottom Depth 3' Gravel Depth No

[X] New System ☐ Repair System Type: I, II, (III), IV, V, VI
System Description: Pressure Manifold to 25% Reduced
Repair System Description: 16" PPBPS
Maintenance Agreement Required: ☐ Yes [X] No


[X] House/Mod. Home No. Bedrooms 3
☐ Mobile Home No. Bathrooms 3.5
☐ Business No. Employees
☐ Other
☐ Slab [X] Crawl Space ☐ Basement w/plumbing ☐ Basement wo/plumbing

Water Supply: [X] Individual ☐ Public ☐ Community


Comments:/Conditions: This permit Supercedes permit dated 2/13/01 Permit Redraw Required by heavy grading and filling in Original Drainfield Area.

Comments:/Conditions:

INITIAL SITE SKETCH

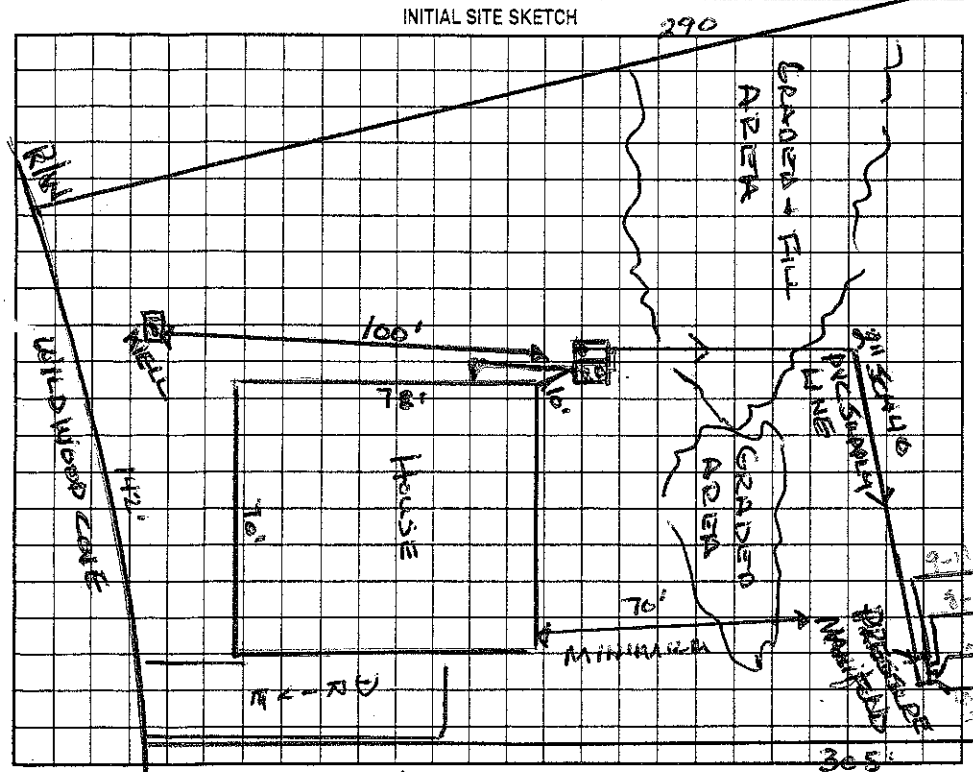

AS BUILT SKETCH

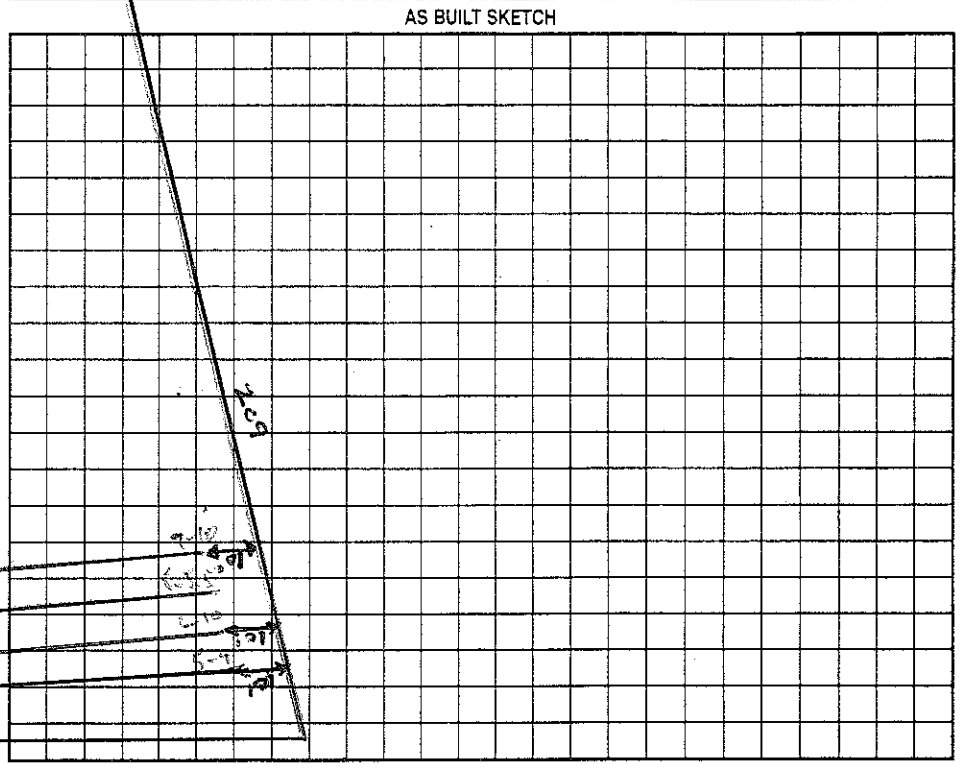

Permit can be suspended or revoked if any false information is supplied toward securing the permit/any unauthorized changes are made to the site/any unauthorized changes are made in the installation of the system. Improvement Permit with plat valid without expiration / Improvement Permit with site plan valid for sixty months. Authorization to Construct is valid for a period equal to that of Improvement Permit – not to exceed sixty months.

Signed: * date 5-4-04 Installed by: Orbison Const.

Improvement Permit by: Wesley Sparks RS. date 5/3/04 Operation Permit by: Wesley Sparks RS. date 6/30/04

Authorization to Construct by: Wesley Sparks RS. date 5/3/04 Existing System Inspection by: date

HEALTH DEPT. COPY: WHITE OWNER COPY (FINAL): YELLOW OWNER COPY (INITIAL): PINK