3:00

IREDELL COUNTY HEALTH DEPARTMENT

STATESVILLE 704-878-5305 MOORESVILLE 704-664-5281

IMPROVEMENT PERMIT / AUTHORIZATION TO CONSTRUCT / OPERATION PERMIT / EXISTING SYSTEM INSPECTION

PERMIT # 137062 PIN # 4639446502 DATE 6-22-2010

OWNER or APPLICANT James Reese PHONE: Business 704 743-8891 Home: 704 549-4241

OWNER or APPLICANT ADDRESS 4114 Armitage Dr Charlotte NC 28269

LOCATION / DIRECTIONS Perth Rd N TL Fern Hill TL Holton Ln 3rd on left

SUBDIVISION Northington Woods BLOCK / SECTION LOT # 3 LOT AREA .884Ac DESIGN FLOW 480gpd L.T.A.R. .3

Septic Tank 1000 Gallons: STB 312 Date 5-3-10

Pump Tank Gallons: P T Date

Pump Make Model Serial #

Nitrification Field No Fields 1 No Lines 5 Linear Feet 400'

Trench Width 36" Max. Trench Bottom Depth 36" Gravel Depth N/A

☒ New System ☐ Repair ☐ Expansion System Type I II III IV V VI

System Description: Gravity -25% Reduction

Repair System Description: LPP PPBPS

Maintenance Agreement Required ☐ YES ☒ NO Not initially

☒ GRAVITY ☐ PRESSURE

☒ Residence No. Bedrooms 4

☐ Business No. Persons

☐ Other No. Employees

☐ Slab ☐ Crawl Space


☐ Basement w/plumbing ☐ Basement w/o plumbing

Water Supply: ☒ Private ☐ Public ☐ Community

Comments / Conditions: Keep Septic Drainfield 100ft from Well & ST > 50ft from well

Comments / Conditions: ★Keep foundation drain 10ft from Septic. This permit replaces previous permits 52, 62, 107, 117, 67

INITIAL SITE SKETCH

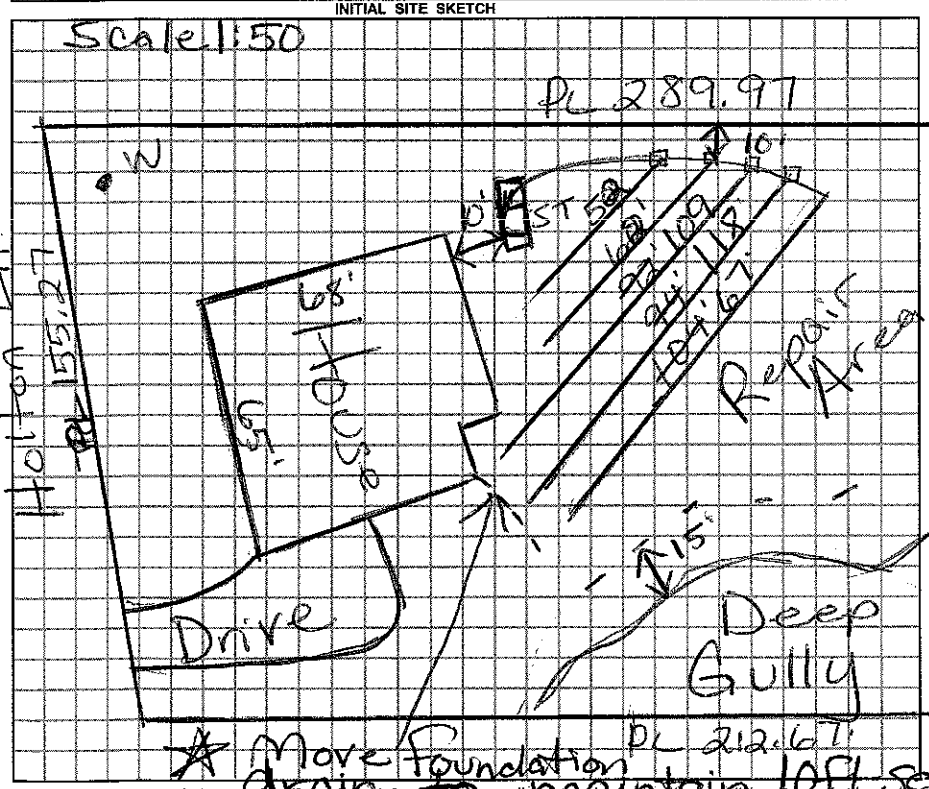

AS BUILT SKETCH

Install Arc 36 in 5 lines essentially As shown.

Lot 73A

Septic Easement

PL 160.58'

Permit can be suspended or revoked if any false information is supplied toward securing the permit, any unauthorized changes are made to the site / any unauthorized changes are made in the installation of the system.

☐ *IMPROVEMENT PERMIT w / plat valid without expiration.* ☐ *IMPROVEMENT PERMIT w / site plan valid for 60 mos.* ☐ *AUTHORIZATION TO CONSTRUCT valid for period equal to IMPROVEMENT PERMIT-not to exceed 60 mo.*

Owner / Applicant Signature: James Reese Date 6/23/2010 Installed by: Larry Henkle REHS

Improvement Permit by: Marian H. Dobson RS Date 6/22/2010 Operation Permit by: Marian H. Dobson Date: 7/1/2010

Authorzation to Construct by: Marian H. Dobson RS Date 6/22/2010 Existing System Inspected by: Date:

YOU SHOULD CONTACT A LOCATOR SERVICE PRIOR TO ANY EXCAVATION.

WHITE COPY Environmental Health YELLOW COPY (Final) Owner / Applicant PINK COPY (Initial) Owner / Applicant