IREDELL COUNTY HEALTH DEPARTMENT

STATESVILLE 704-878-5305 MOORESVILLE 704-664-5281

12:30

IMPROVEMENT PERMIT / AUTHORIZATION TO CONSTRUCT / OPERATION PERMIT / EXISTING SYSTEM INSPECTION

PERMIT # 131222 PIN # 4639 45 1405 DATE 10-5-09

OWNER or APPLICANT Jagruti Thakkar/KeareyBld PHONE: Business 704 883-9811 Home: Builder 336 940-1600

OWNER or APPLICANT ADDRESS 1210 Davie Statesville, NC 28677

LOCATION / DIRECTIONS 150W TR Perth TL Fern Hill TR Nautical Pt at end

SUBDIVISION Nautical Pt BLOCK / SECTION LOT # 6 LOT AREA 4.2Acre DESIGN FLOW 600 L.T.A.R. .3

Septic Tank 1500 Gallons: STB 1014 Date >30days

Pump Tank 1500 Gallons: PT 46 Date >30days

Pump Make Zoeller Model [illegible] Serial # [illegible]

Nitrification Field No Fields 1 No Lines 7 Linear Feet 340'

Trench Width min. 24" Max. Trench Bottom Depth 36" Gravel Depth N/A

☒ New System ☐ Repair ☐ Expansion System Type I II III IV V VI

System Description: Pump-LP Panel Black

Repair System Description: Same

Maintenance Agreement Required ☒ YES ☐ NO

☐ GRAVITY ☒ PRESSURE

☒ Residence No. Bedrooms 5

☐ Business No. Persons

☐ Other No. Employees

☐ Slab ☐ Crawl Space

☒ Basement w/plumbing ☐ Basement w/o plumbing

Water Supply: ☒ Private ☐ Public ☐ Community


Comments / Conditions: Install 6 lines @ 50ft & 1 line @ 40ft Keep Supply line at least 50ft from well Drain Fields must be 15ft from Road/Driveway bank (Cut 2Ft or greater setback = 15Ft)

Comments / Conditions: This permit replaces previous permit From 9-2-68


4/29/10 Checked lines

4/7/10 Tanks Checked by BA

INITIAL SITE SKETCH

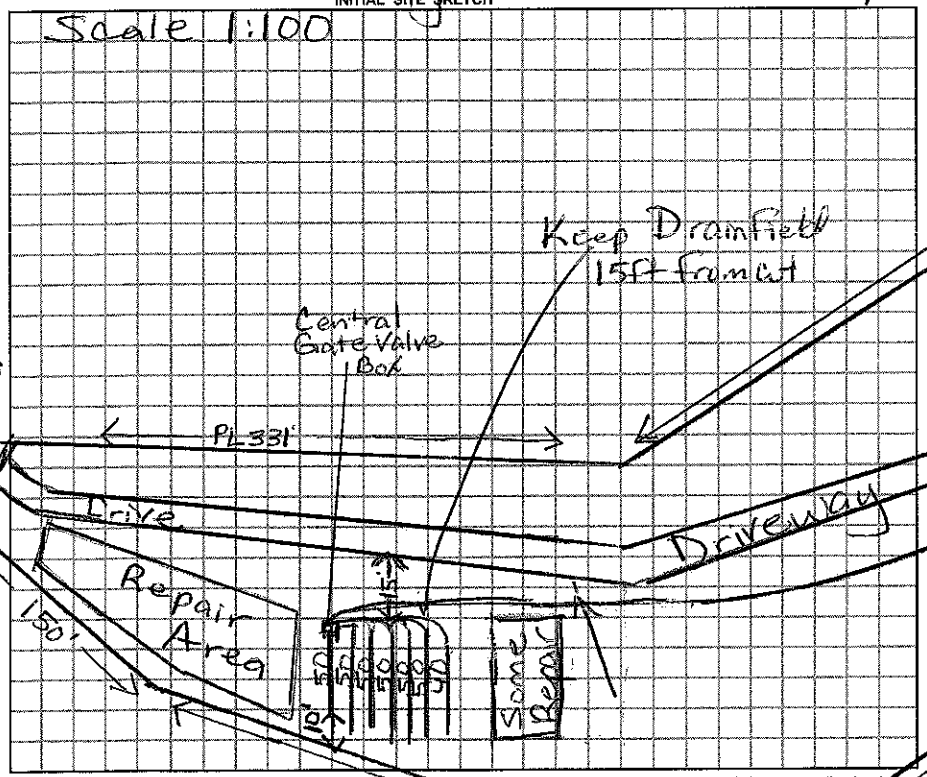

AS BUILT SKETCH

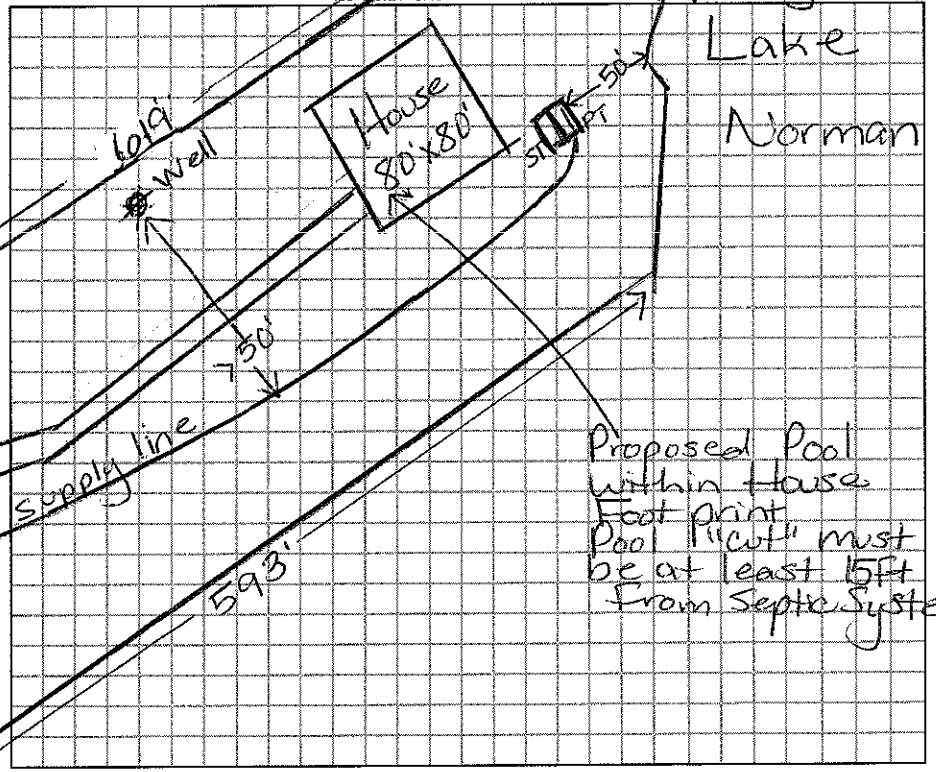

Permit can be suspended or revoked if any false information is supplied toward securing the permit / any unauthorized changes are made to the site / any unauthorized changes are made in the installation of the system.

☐ *IMPROVEMENT PERMIT w / plat valid without expiration.* ☐ *IMPROVEMENT PERMIT w / site plan valid for 60 mos.* ☐ *AUTHORIZATION TO CONSTRUCT valid for period equal to IMPROVEMENT PERMIT-not to exceed 60 mo.*

Owner / Applicant Signature: Maita Kearey Date 10/7/09

Improvement Permit by: Maria H. Dotson Date 10/7/09

Authorization to Construct by: Maria H. Dotson RS Date 10/7/09

Installed by: Rowan Septic RS

Operation Permit by: Maria H. Dotson Date: 6-9-10

Existing System Inspected by: Date:

YOU SHOULD CONTACT A LOCATOR SERVICE PRIOR TO ANY EXCAVATION.

WHITE COPY Environmental Health YELLOW COPY (Final) Owner / Applicant PINK COPY (Initial) Owner / Applicant