IREDELL COUNTY HEALTH DEPARTMENT

Statesville Office (704) 878-5305 Mooresville Office (704) 660-3625 PERMIT # 207703

IMPROVEMENT PERMIT / AUTHORIZATION TO CONSTRUCT / OPERATION PERMIT / EXISTING SYSTEM

PIN # 4659-45-5442

APPLICANT: LARRY HEPNER APPLICANT ADDRESS: 199 PECAN HILLS DR. MOORESVILLE

SITE ADDRESS: 117 HAWK'S NEST LN. PHONE: 704-453-4549 ALT. PHONE:

SITE DIRECTIONS: PERTH, TL FERN HILL, TR HAWK'S NEST LN.

SUBDIVISION: WOODSTREAM ESTATES SECTION: LOT # 4 LOT AREA: ~1AC DESIGN FLOW: 600 L.T.A.R.: .3

Septic Tank 1500 (gal) STB 1014 Date 6-21-15
Pump Tank (gal) PT Date
Pump Make Model Serial #
Nitrification Fields 1 # Lines 8 Linear Ft: 500'
Trench Width 36" Max. Trench Bottom Depth 24"-36" Gravel Depth —

☒ New System ☐ Repair ☐ Expansion System Type: I II ⓘ IV V VI
System Description: 25% REDUCTION
Repair System Description: PANEL BLOCK
Maintenance Agreement Required: ☐ YES ☒ NO
☒ GRAVITY ☐ PRESSURE

☒ Residence ☐ Business ☐ Other ☐ Slab ☒ Basement w/plumbing
No. Bedrooms 5 No. Persons No. Employees ☐ Crawl Space ☐ Basement w/o plumbing

Water Supply: ☒ Private ☐ Public ☐ Community

Comments / Conditions:

Used Quick 4 for Drainfield, Installed essentially as drawn

INITIAL SITE SKETCH

SEE PLAN FROM MICHAEL ATHANAS & ASSOCIATES

AS BUILT SKETCH

Permit can be suspended or revoked if any false information is supplied toward securing the permit / any unauthorized changes are made to the site / any unauthorized changes are made in the installation of the system. **CONTACT A LOCATOR SERVICE PRIOR TO ANY EXCAVATION**

☐ **IMPROVEMENT PERMIT** *with plat valid without expiration.* ☐ **IMPROVEMENT PERMIT** *with site plan valid for 60 mos.* ☒ **AUTHORIZATION TO CONSTRUCT** *valid for period equal to IMPROVEMENT PERMIT--not to exceed 60 mo.*

Owner / Applicant Signature: Larry Hepner Date: 2-16-15 Installed by: Rowan Septic


IMPROVEMENT PERMIT by: APPROVED Date: FEB 16 2015 OPERATION PERMIT by: Date: 8/16/15

AUTHORIZATION TO CONSTRUCT by: APPROVED Date: FEB 16 2015 Existing System Inspected by: Date:

Health Dept. Copy - WHITE Applicant (Final Approval) - YELLOW Applicant (Conditional Approval) - PINK

117 Hawksnest Ln
Mooresville NC

APPROVED FEB 16 2015

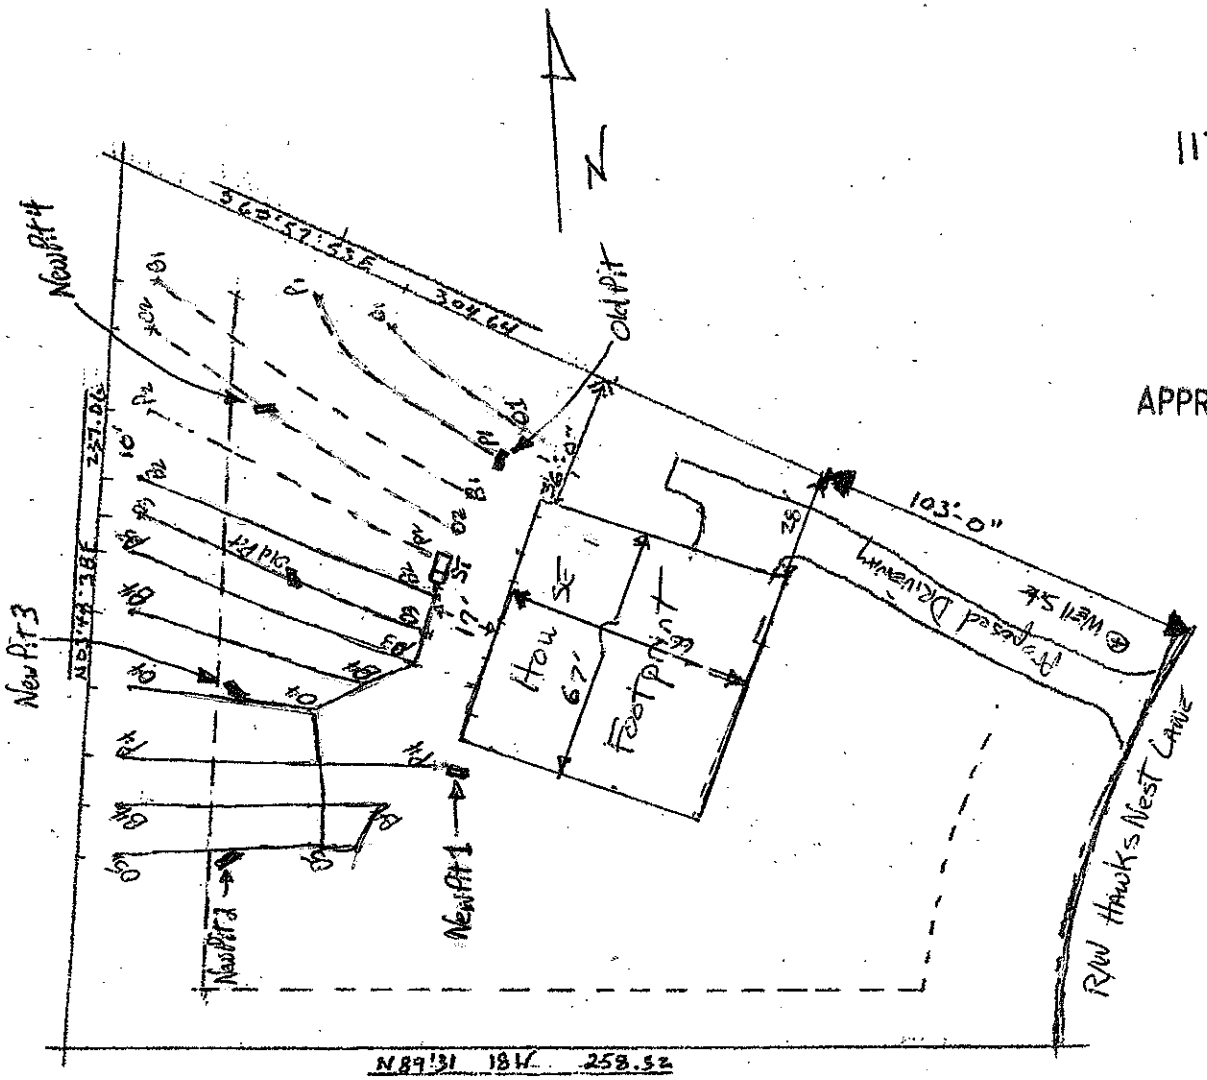

SITE PLAN

1" = 50'