IREDELL COUNTY HEALTH DEPARTMENT

STATESVILLE 704-878-5305 MOORESVILLE 704-664-5281

IMPROVEMENT PERMIT / AUTHORIZATION TO CONSTRUCT / OPERATION PERMIT / EXISTING SYSTEM INSPECTION

PERMIT # 143705 PIN # 4639-45-6720 DATE 5-7-10

OWNER or APPLICANT Dave Liberatore PHONE: Business 417-291-1383 Home: 585-594-0221

OWNER or APPLICANT ADDRESS 58 Hutchins Rd

LOCATION / DIRECTIONS Perth, TL Fern Hill, TR Hawksnest, 125

SUBDIVISION Woodstream Estates BLOCK / SECTION 1 LOT # 6 LOT AREA 1.63 Ac DESIGN FLOW 480 GPD L.T.A.R. .3-.35

Septic Tank 1000 Gallons: STB 794 Date 8-28-10
Pump Tank Gallons: P T Date
Pump Make Model Serial #
Nitrification Field No Fields 1 No Lines 6 Linear Feet 400'
Trench Width 36" Max. Trench Bottom Depth 36" Gravel Depth —

☒ New System ☐ Repair ☐ Expansion System Type I (II) III IV V VI
System Description: Gravity 25% Reduction
Repair System Description: Same
Maintenance Agreement Required ☐ YES ☒ NO
☒ GRAVITY ☐ PRESSURE

☒ Residence No. Bedrooms 4
☐ Business No. Persons
☐ Other No. Employees
☐ Slab ☐ Crawl Space
☒ Basement w/plumbing ☐ Basement w/o plumbing

Water Supply: ☒ Private ☐ Public ☐ Community

Comments / Conditions 1) Tank Must Be 15' From Basement 2) Use Drop Box Distribution (If Chambers Are Used, End Caps Can Replace Drop Boxs)

Comments / Conditions

Arc 36


Location of the proposed Inground Swimming Pool **addition does not appear to impact the existing on-site septic system.**NOTE:** Must keep Pool "cut" at least 15 Ft from Septic System & Repair

Marcia Kotzer REHS

Date: 12/6/13

ICHD-Environmental Health Division

AS BUILT SKETCH

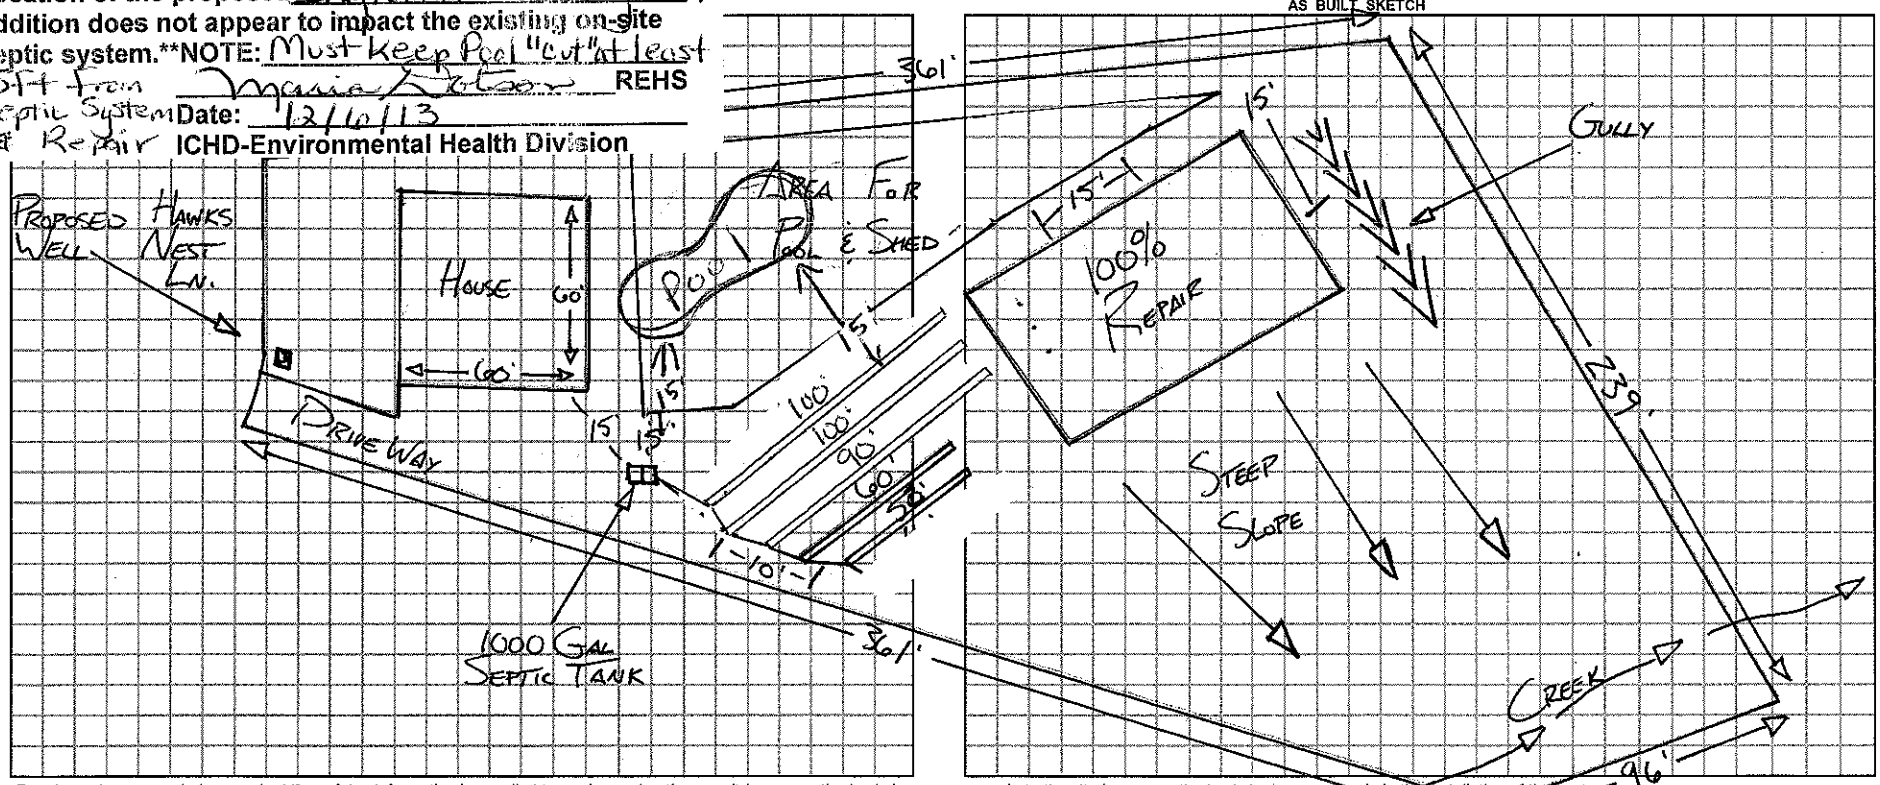

Permit can be suspended or revoked if any false information is supplied toward securing the permit / any unauthorized changes are made to the site / any unauthorized changes are made in the installation of the system.

☐ *IMPROVEMENT PERMIT w/ plat valid without expiration.* ☒ *IMPROVEMENT PERMIT w / site plan valid for 60 mos.* ☐ *AUTHORIZATION TO CONSTRUCT valid for period equal to IMPROVEMENT PERMIT-not to exceed 60 mo.*

Owner / Applicant Signature: Dave Liberatore Date 5/20/10

Improvement Permit by: REHS Date 5-11-10

Authorzation to Construct by: REHS Date 5-20-10

YOU SHOULD CONTACT A LOCATOR SERVICE PRIOR TO ANY EXCAVATION.

Installed by: Larry Beam

Operation Permit by: REHS Date: 10-7-10

Existing System Inspected by: Date:

WHITE COPY Environmental Health YELLOW COPY (Final) Owner / Applicant PINK COPY (Initial) Owner / Applicant