IREDELL COUNTY HEALTH DEPARTMENT

STATESVILLE 704-878-5305 130.00 Paid MOORESVILLE 704-664-5281

IMPROVEMENT PERMIT / AUTHORIZATION TO CONSTRUCT / OPERATION PERMIT / EXISTING SYSTEM INSPECTION

PERMIT# 126 700 20 PIN# 4639 46 4207.040 4639-46-4216 DATE 7/11/05

OWNER OR CONTRACTOR Northwood Group LLC/MAINSTREAM CONSTRUCTION Phone: Business 704-663-4050 Home

ADDRESS 109-C Williamson Rd. Mooresville, NC 28117

LOCATION Perth N, TL Fern Hill TR Tennessee Circle on (L) before "Y"

SUBDIVISION Northwood BLOCK / SECTION LOT 40 LOT AREA 2.48Ac SITE CLASS: PS DESIGN FLOW 480 L.T.A.R. .3

Septic Tank: 1000 Gallons: STB 312 Date 5-22-06
Pump Tank: 1000 Gallons: PT 283 Date 6-27-06
Pump Make Gravels Model WF-0312M Serial No.
Nitrification Field: No Fields 1 Square Feet 1200 Linear Feet 400
No Lines 4@100' Trench Width 3' Max Trench Bottom Depth 3' Gravel Depth N/A

[X] New System [ ] Repair System Type: I, II, (III), IV, V, VI
System Description: PressMan → 25% Reduced
Repair System Description: Same Type
Maintenance Agreement Required: [ ] Yes [ ] No

[X] House/Mod. Home No. Bedrooms 4
[ ] Mobile Home No. Bathrooms 4
[ ] Business No. Employees
[ ] Other
[ ] Slab [ ] Crawl Space [X] Basement w/plumbing [ ] Basement wo/plumbing

Water Supply: [X] Individual [ ] Public [ ] Community


Comments:/Conditions: Well must be 100' minimum from all parts of Septic Tank System.

Note: elect line had to be moved to put in Drainfield


Comments:/Conditions: Tanks checked 8/1/06 MD
8/9/06 Installed E-Z Flow as Drawn

1"=50'

INITIAL SITE SKETCH

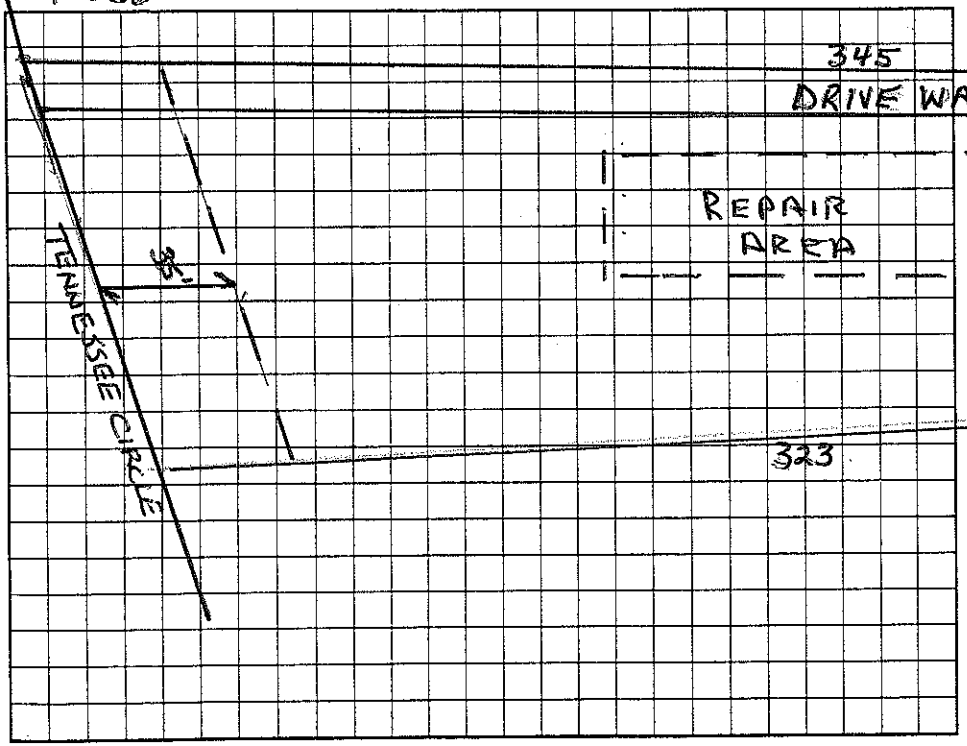

AS BUILT SKETCH

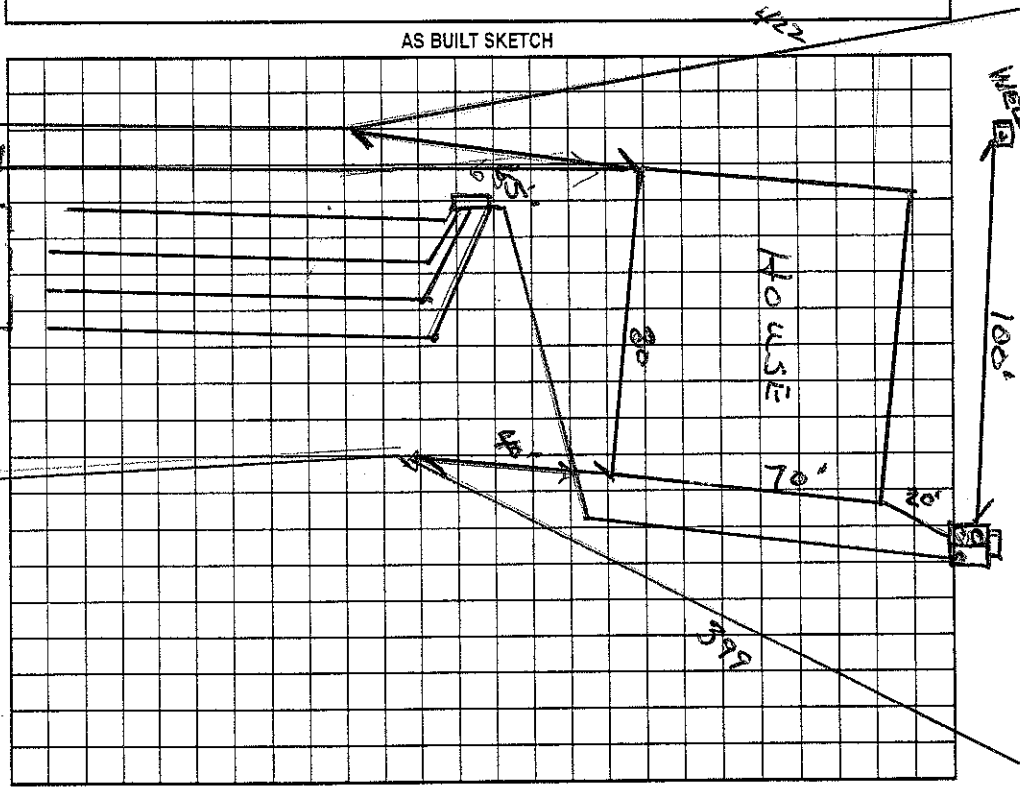

Permit can be suspended or revoked if any false information is supplied toward securing the permit/any unauthorized changes are made to the site/any unauthorized changes are made in the installation of the system. Improvement Permit with plat valid without expiration. Improvement Permit with site plan valid for sixty months. Authorization to Construct is valid for a period equal to that of Improvement Permit – not to exceed sixty months.

Signed: X Thomas Brooks date 7-13-05

Improvement Permit by: Wesley Sparks RS. date 7/11/05

Authorization to Construct by: Wesley Sparks RS. date 10/19/05

Installed by: R&H Dotson RS.

Operation Permit by: Maria H Dotson date 10/16/06

Existing System Inspection by: date

HEALTH DEPT. COPY: WHITE OWNER COPY (FINAL): YELLOW OWNER COPY (INITIAL): PINK