IREDELL COUNTY HEALTH DEPARTMENT

STATESVILLE 704-878-5305 100.00 MOORESVILLE 704-664-5281

IMPROVEMENT PERMIT / AUTHORIZATION TO CONSTRUCT / OPERATION PERMIT / EXISTING SYSTEM INSPECTION

PERMIT# 186 701 PIN# 4639 46 5146 DATE 10/7/06

OWNER OR APPLICANT JIM CALLARD PHONE: Business 704 737 3367 Home

ADDRESS 810 KEMP RD. MOORESVILLE, NC 28115

LOCATION 150 W TR PERTH RD. TL FERN HILL TR TENNESSEE CIR, ON (L) B4 "Y"

SUBDIVISION NORTHWOOD BLOCK / SECTION 5 LOT 41 LOT AREA ~2.9 Ac SITE CLASS. PS DESIGN FLOW 600 L.T.A.R. .3

Septic Tank: 1500 Gallons; STB @11 Date 7/9/06

Pump Tank: Gallons; PT Date

Pump Make: Model Serial No.

Nitrification Field: No Fields 1 Square Feet 1500 Linear Feet 500

No Lines 4@125 Trench Width 3' Max Trench Bottom Depth 3' Gravel Depth NO

☒ New System ☐ Repair ☐ Expansion System Type: I II III IV V VI

System Description: GRAVITY - 2570 REDUCED

Repair System Description LP - 16" PPBPS

Maintenance Agreement Required: ☐ Yes ☒ No

☒ House/Mod. Home ☐ Mobile Home ☐ Business ☐ Other

No. Bedrooms 3 No. Persons No. Employees

Water Supply: ☒ Individual ☐ Public ☐ Community


☐ Gravity ☐ Pressure ☐ Slab ☐ Crawl Space ☒ Basement w/plumbing ☐ Basement wo/plumbing

Comments:/Conditions:


Comments:/Conditions:

1" = 100'

INITIAL SITE SKETCH

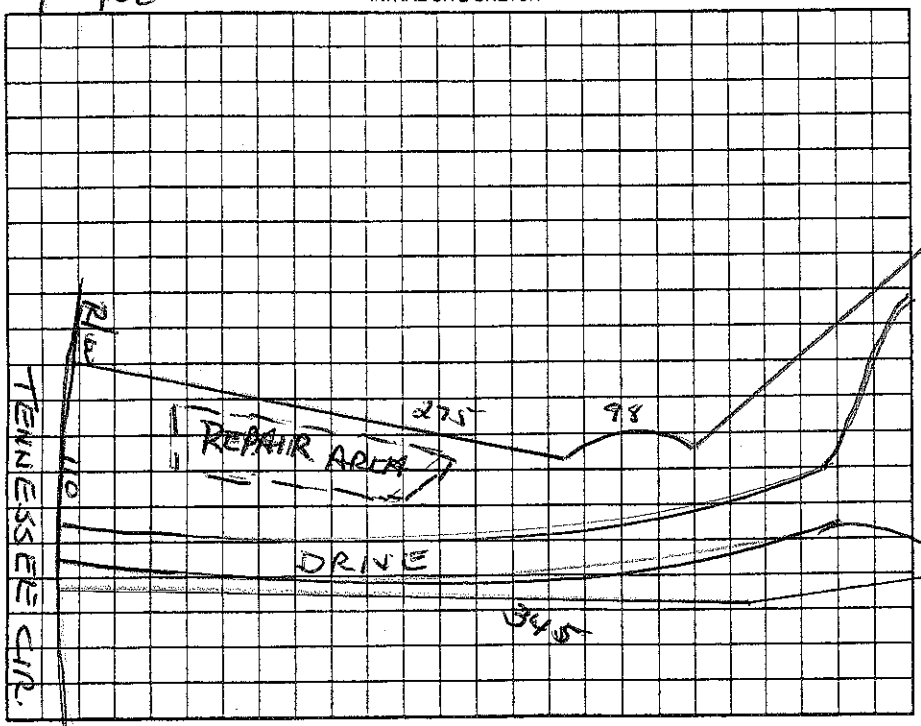

AS BUILT SKETCH

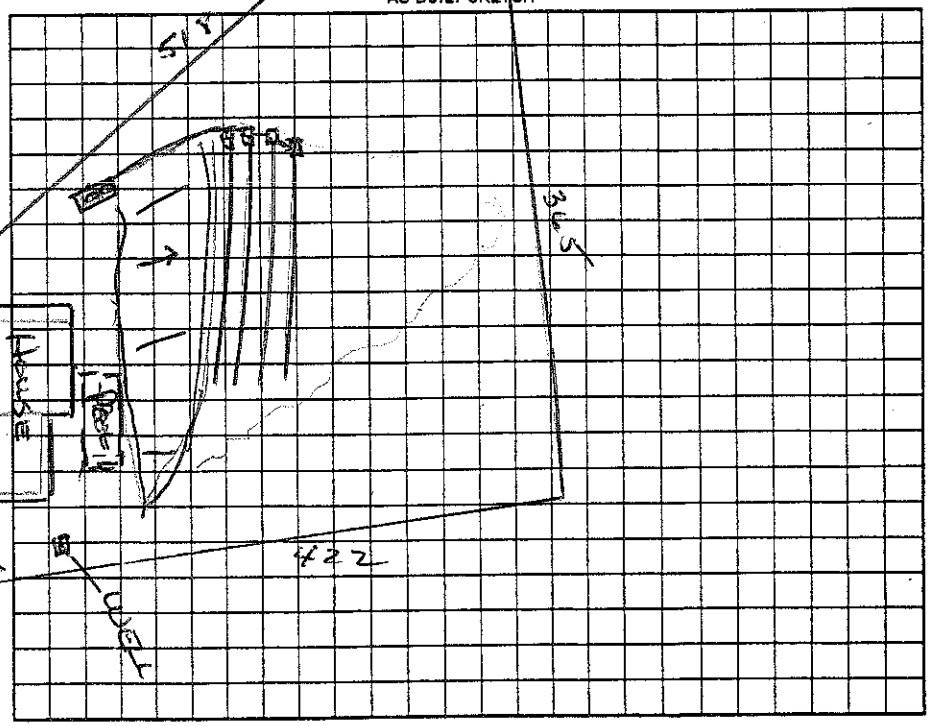

Permit can be suspended or revoked if any false information is supplied toward securing the permit/any unauthorized changes are made to the site/any unauthorized changes are made in the installation of the system. Improvement Permit with plat valid without expiration ☐ Improvement Permit with site plan valid for sixty months ☐ Authorization to Construct is valid for a period equal to that of Improvement Permit – not to exceed sixty months.

Signed: [signature] date 10-13-06 Installed by: [signature]

Improvement Permit by: Wesley Sparks RS date 10/7/06 Operation Permit by: Wesley Sparks RS date 11/3/06

Authorization to Construct by: Wesley Sparks RS date 10/7/06 Existing System Inspection by: date

HEALTH DEPT. COPY: WHITE OWNER COPY (FINAL): YELLOW OWNER COPY (INITIAL): PINK