IREDELL COUNTY HEALTH DEPARTMENT

STATESVILLE 704-878-5305 / MOORESVILLE 704-664-5281

IMPROVEMENT PERMIT / AUTHORIZATION TO CONSTRUCT / OPERATION PERMIT / EXISTING SYSTEM INSPECTION

PERMIT# 105835 PIN# 4639 - 46 - 6492 DATE 5/22/03

OWNER OR CONTRACTOR Jeff Rogers PHONE: Business 704-634-9856 Home

ADDRESS 2020 Perth Rd, Mooresville NC 28117

LOCATION Perth, TL Fern Hill, TR Tennessee Cir on Lt.

SUBDIVISION Northwood BLOCK / SECTION 5 LOT 35 LOT AREA 1.06 AC SITE CLASS PS DESIGN FLOW 480 L.T.A.R. 0.35

Septic Tank: 1000 Gallons; STB 794 Date 4/13/03

Pump Tank: _____ Gallons; PT _____ Date _____

Pump Make: _____ Model _____ Serial No. _____

Nitrification Field: No Fields 1 Square Feet 1032 Linear Feet 344

No Lines 4@86' Trench Width 36" Max Trench Bottom Depth 36" Gravel Depth —

☒ New System ☐ Repair System Type: I, II, (III), IV, V, VI

System Description: Gravity 25% Reduct.

Repair System Description: Panel Block

Maintenance Agreement Required: ☐ Yes ☒ No

☒ House/Mod. Home ☐ Mobile Home ☐ Business ☐ Other

No. Bedrooms 4 No. Bathrooms 2½ No. Employees ____

☐ Slab ☒ Crawl Space ☐ Basement w/plumbing ☐ Basement wo/plumbing


Water Supply: ☒ Individual ☐ Public ☐ Community

Comments/Conditions:


1"=50'

Neighbor's well

INITIAL SITE SKETCH

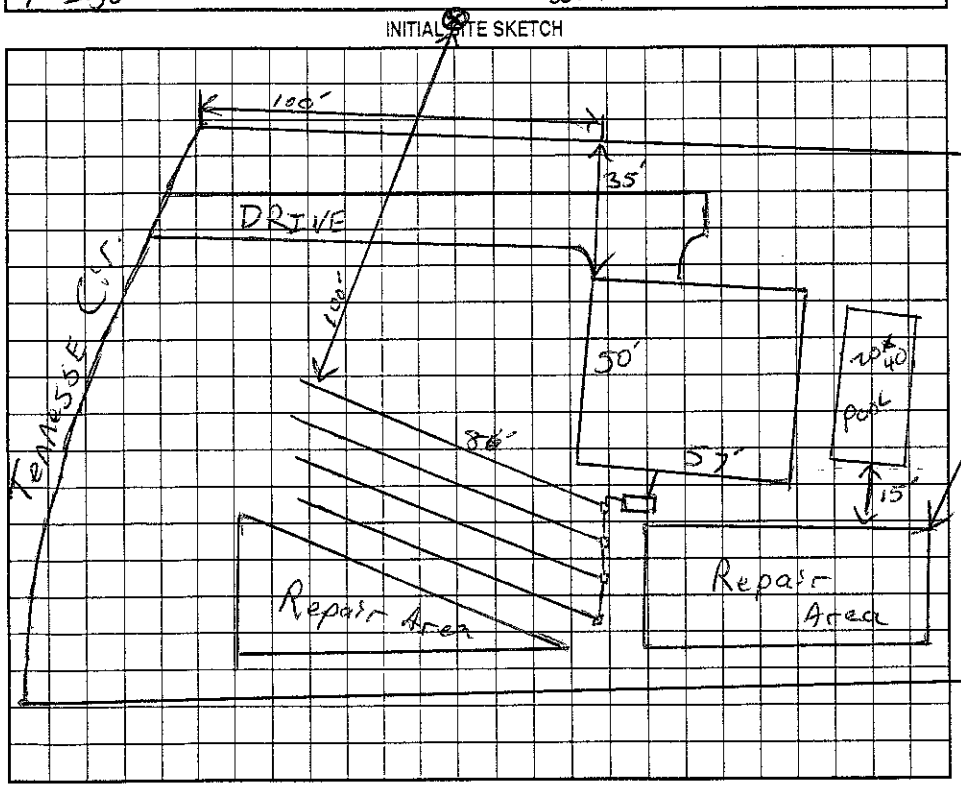

AS BUILT SKETCH

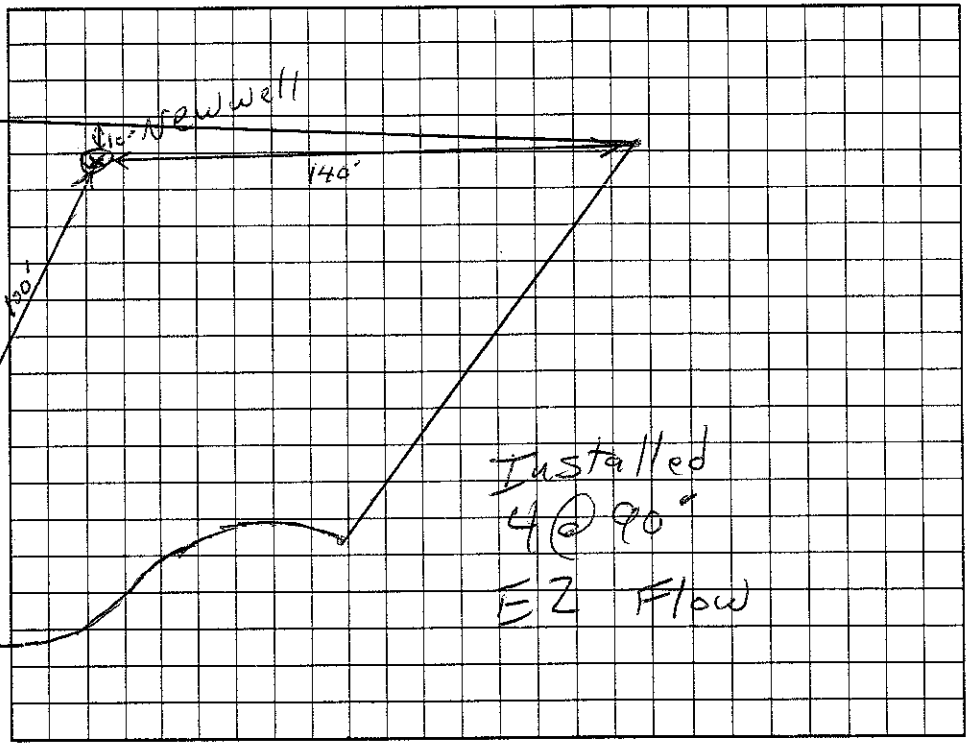

Permit can be suspended or revoked if any false information is supplied toward securing the permit/any unauthorized changes are made to the site/any unauthorized changes are made in the installation of the system. Improvement Permit with plat valid without expiration. Improvement Permit with site plan valid for sixty months. Authorization to Construct is valid for a period equal to that of Improvement Permit – not to exceed sixty months.

Signed: _____ date 5/22/03 Installed by: Thomas Grading

Improvement Permit by: _____ RS date 5/22/03 Operation Permit by: _____ RS date 7/30/03

Authorization to Construct by: _____ RS date 5/22/03 Existing System Inspection by: _____ date _____

HEALTH DEPT. COPY: WHITE OWNER COPY (FINAL): YELLOW OWNER COPY (INITIAL): PINK