IREDELL COUNTY HEALTH DEPARTMENT

STATESVILLE 704-878-5305 / 300 Pg. 1 MOORESVILLE 704-664-5281

IMPROVEMENT PERMIT / AUTHORIZATION TO CONSTRUCT / OPERATION PERMIT / EXISTING SYSTEM INSPECTION

PERMIT# 105910 PIN# 4639-46-7299 DATE 3/24/03

OWNER OR CONTRACTOR John + Marcy Clark PHONE: Business _____ Home 704-875-0142

ADDRESS 104 Maxwell St. Huntersville NC 28078

LOCATION Perth TL Fern Hill, TR Tennesse Cir on LT

SUBDIVISION Northwood BLOCK / SECTION 5 LOT 34 LOT AREA 1.30 AC SITE CLASS. PS DESIGN FLOW 360 L.T.A.R. 0.5

Septic Tank: 1000 Gallons; STB 794 Date 2/20/03
Pump Tank: _____ Gallons; PT _____ Date _____
Pump Make: _____ Model _____ Serial No. _____
Nitrification Field: No Fields 1 Square Feet 900 Linear Feet 300
No Lines 6 @ 50' Trench Width 36" Max Trench Bottom Depth 36" Gravel Depth —

☒ New System ☐ Repair System Type: I, II, (III), IV, V, VI
System Description: Gravity 25% Reduct.
Repair System Description: same
Maintenance Agreement Required: ☐ Yes ☒ No

☒ House/Mod. Home No. Bedrooms 3
☐ Mobile Home No. Bathrooms 3
☐ Business No. Employees _____
☐ Other _____

☐ Slab ☒ Crawl Space ☐ Basement w/plumbing ☐ Basement wo/plumbing


Water Supply: ☒ Individual ☐ Public ☐ Community

Comments:/Conditions:


Comments:/Conditions:

Infiltrator Installed

INITIAL SITE SKETCH

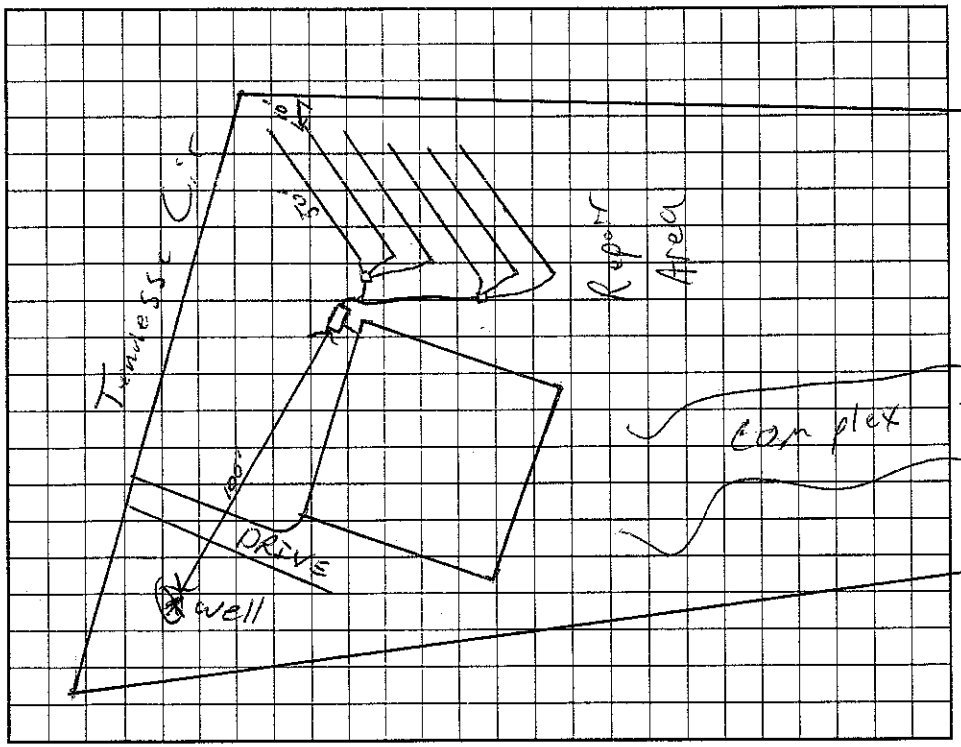

AS BUILT SKETCH

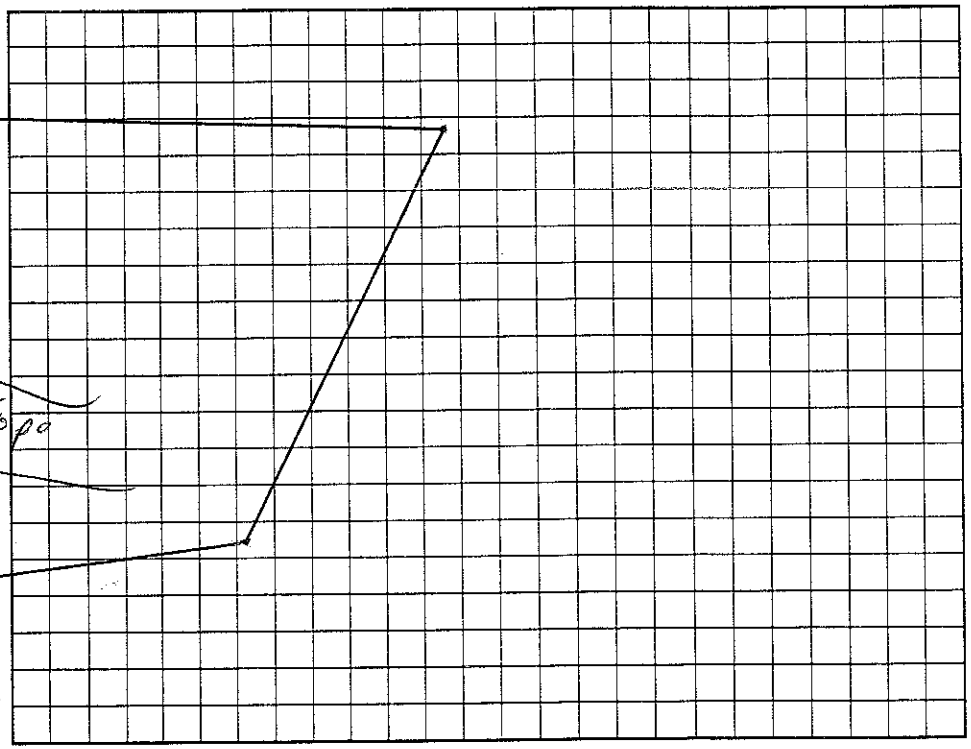

Permit can be suspended or revoked if any false information is supplied toward securing the permit/any unauthorized changes are made to the site/any unauthorized changes are made in the installation of the system. Improvement Permit with plat valid without expiration. Improvement Permit with site plan valid for sixty months. Authorization to Construct is valid for a period equal to that of Improvement Permit – not to exceed sixty months.

Signed: _____ date 3-24-03 Installed by: Orbison

Improvement Permit by: _____ RS date 3/24/03 Operation Permit by: _____ RS date 3/25/03

Authorization to Construct by: _____ RS date 3/24/03 Existing System Inspection by: _____ date _____

HEALTH DEPT. COPY: WHITE OWNER COPY (FINAL): YELLOW OWNER COPY (INITIAL): PINK