IREDELL COUNTY HEALTH DEPARTMENT

TESVILLE 704-878-5305 MOORESVILLE 704-664-5281

IMPROVEMENT PERMIT / AUTHORIZATION TO CONS CT / OPERATION PERMIT / EXISTING SYSTEM INSPECTION

PERMIT# 105834 PIN# 4639-46-8133 DATE 1/22/03

OWNER OR CONTRACTOR T. Whelan Homes PHONE: Business 704-400-8932 Home

ADDRESS PO Box 4419 Mooresville NC 28117

LOCATION Perth, TL Fern H. 11, TR Tennessee Cir, 1st Lt

SUBDIVISION North Wood BLOCK / SECTION 5 LOT 33 LOT AREA 1.46 AC SITE CLASS. PS DESIGN FLOW 460 L.T.A.R. 0.3

Septic Tank: 1000 Gallons; STB 312 Date 4/7/03

Pump Tank: _____ Gallons; PT _____ Date _____

Pump Make: _____ Model _____ Serial No. _____

Nitrification Field: No Fields 1 Square Feet 1600 Linear Feet 533

No Lines 4 @ 133' Trench Width 36" Max Trench Bottom Depth 36" Gravel Depth 12"

☒ New System ☐ Repair System Type: I, II, III, IV, V, VI

System Description: Gravity Conventional

Repair System Description: Same

Maintenance Agreement Required: ☐ Yes ☒ No

☒ House/Mod. Home No. Bedrooms 4

☐ Mobile Home No. Bathrooms 3½

☐ Business No. Employees _____

☐ Other _____


Water Supply: ☒ Individual ☐ Public ☐ Community

☐ Slab ☒ Crawl Space ☐ Basement w/plumbing ☐ Basement wo/plumbing


Comments:/Conditions:

Comments:/Conditions:

INITIAL SITE SKETCH

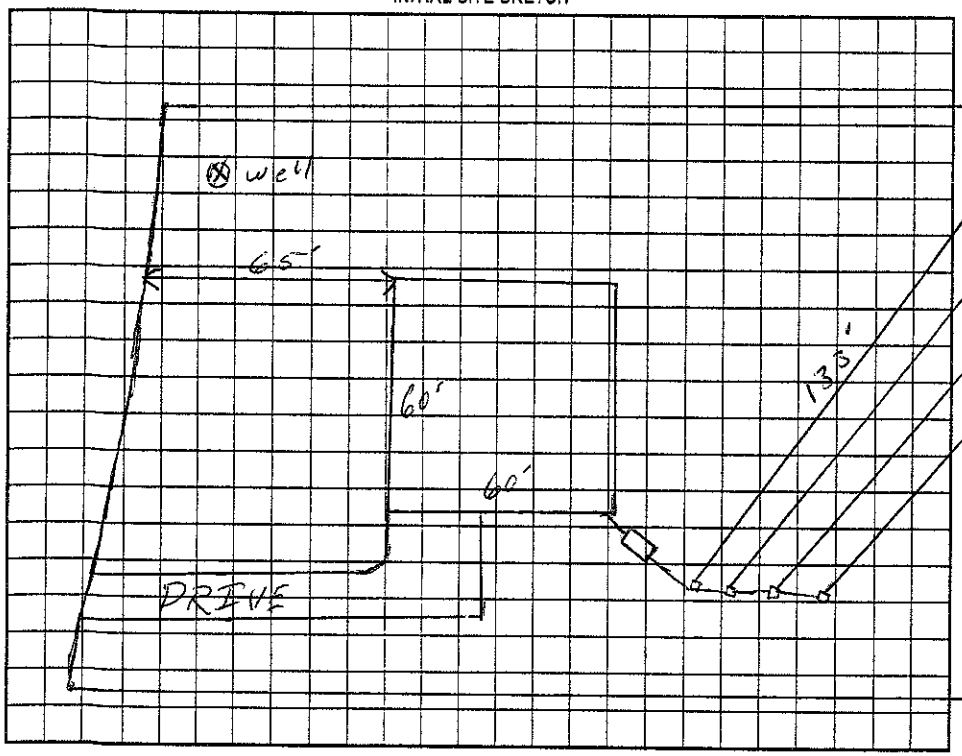

AS BUILT SKETCH

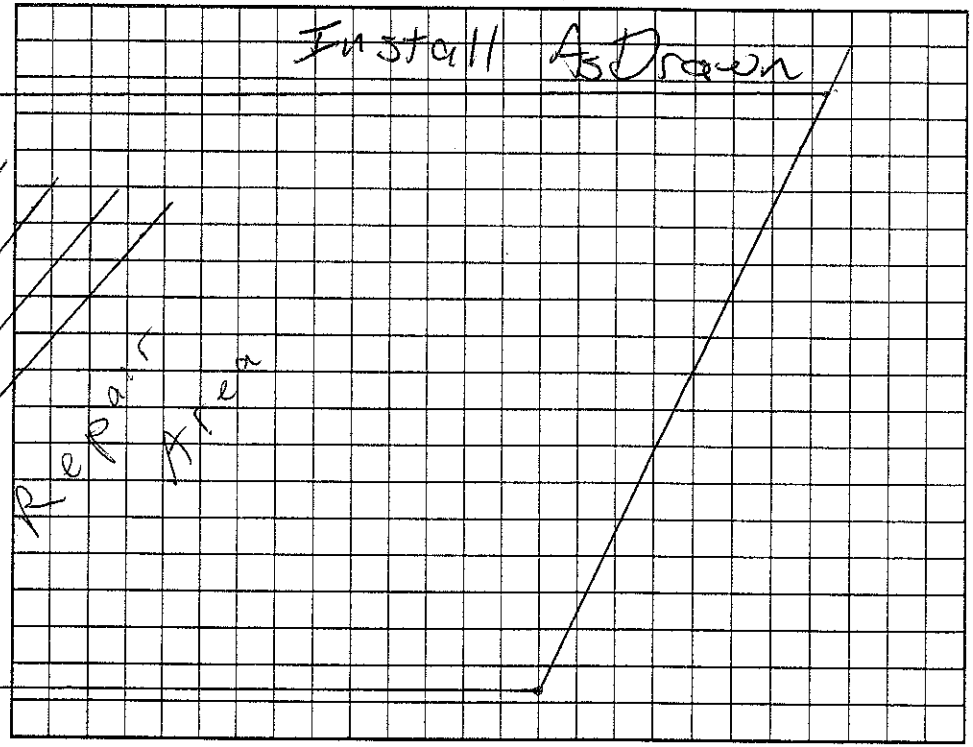

Permit can be suspended or revoked if any false information is supplied toward securing the permit/any unauthorized changes are made to the site/any unauthorized changes are made in the installation of the system. Improvement Permit with plat valid without expiration. Improvement Permit with site plan valid for sixty months. Authorization to Construct is valid for a period equal to that of Improvement Permit – not to exceed sixty months.

Signed: _____ date 2-11-03 Installed by: Larry Beam

Improvement Permit by: _____ RS date 1/22/03 Operation Permit by: _____ RS date 5/9/03

Authorization to Construct by: _____ RS date 1/22/03 Existing System Inspection by: _____ date _____

HEALTH DEPT. COPY: WHITE OWNER COPY (FINAL): YELLOW OWNER COPY (INITIAL): PINK