IREDELL COUNTY HEALTH DEPARTMENT

STATESVILLE 704-878-5305 MOORESVILLE 704-664-5281

IMPROVEMENT PERMIT / AUTHORIZATION TO CONSTRUCT / OPERATION PERMIT / EXISTING SYSTEM INSPECTION

PERMIT# 078763 PIN# 4639472156 (pt) 4639471229 DATE October 29, '99

OWNER OR CONTRACTOR Quiet Waters Christian Fellowship PHONE: Business 892-4111 Home

ADDRESS 858 Southwest Dr. Davidson / 28036

LOCATION Northwood Path Rd. N. TL Fern Hill Rd. TR Tennessee Circle on Right at forks

SUBDIVISION Quiet Waters BLOCK / SECTION LOT 1 #2 Combined LOT AREA 3.062ac SITE CLASS PS DESIGN FLOW 960gpd L.T.A.R. .03

Septic Tank: 2000 Gallons; STB 87 Date 8/21/99

Pump Tank: 2000 Gallons; PT 7 Date 8/17/99

Pump Make: Model Serial No.

Nitrification Field: No Fields 1 Square Feet 2400 Linear Feet 800

No Lines 8 Trench Width 36" Max Trench Bottom Depth 36"

☑ New System ☐ Repair System Type: I, II, III, IV, V, VI

System Description: PM - Innovative -25% Reduction

Repair System Description: PM-Innovative on Lot 1, Tennessee Circle

Maintenance Agreement Required: ☐ Yes ☑ No

Gravel Depth NA

☑ House/Mod. Home No. Bedrooms 8

☐ Mobile Home No. Bathrooms 8

☐ Business No. Employees

☐ Other


☐ Slab ☐ Crawl Space ☑ Basement w/plumbing ☐ Basement wo/plumbing

Water Supply: ☐ Individual ☐ Public ☐ Community


Comments:/Conditions: This permit voids earlier permit issued on Lot 1, Quiet Waters. Repair area across street on Lot 1, Tennessee Circle

Comments:/Conditions:

INITIAL SITE SKETCH 1" = 100'

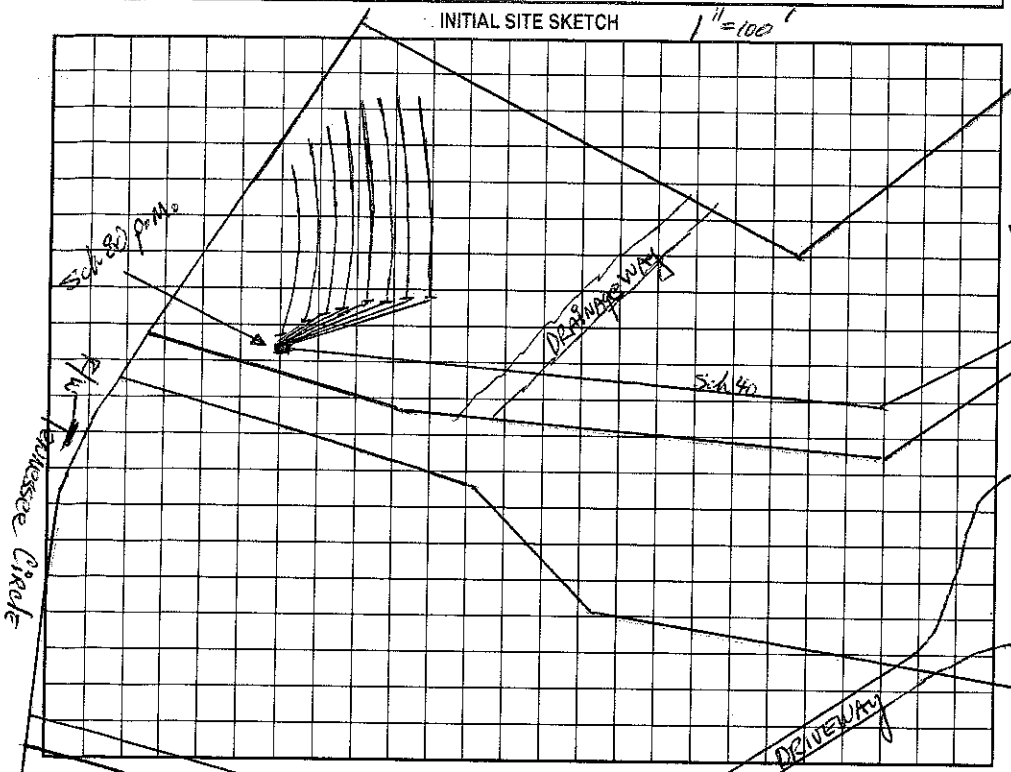

AS BUILT SKETCH

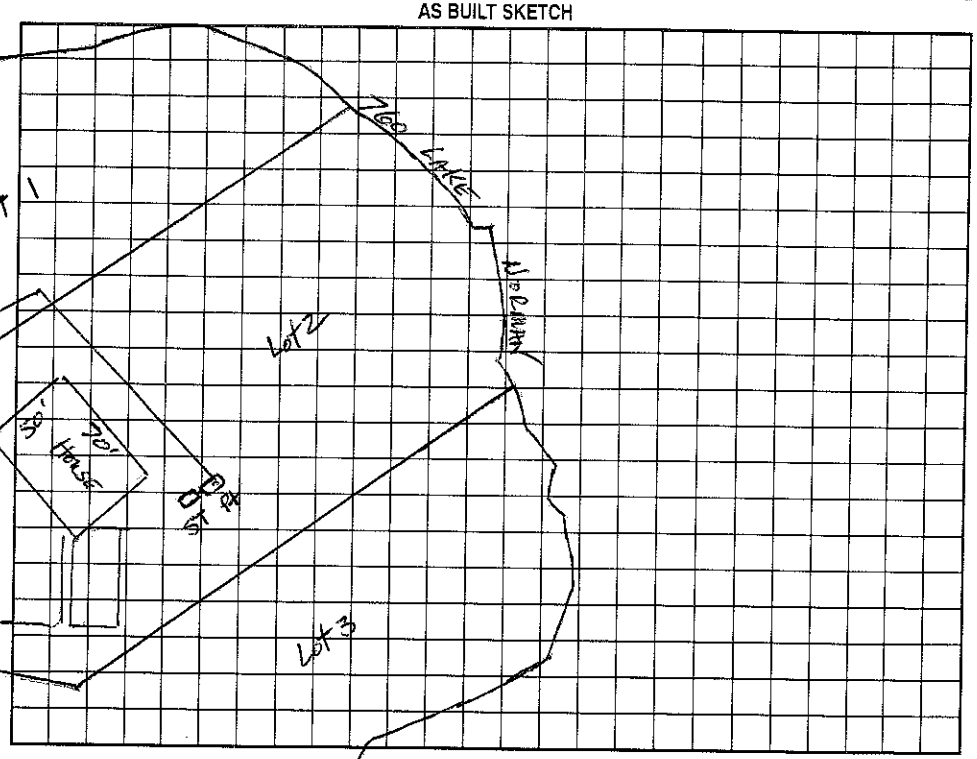

Permit can be suspended or revoked if any false information is supplied toward securing the permit/any unauthorized changes are made to the site/any unauthorized changes are made in the installation of the system. Improvement Permit with plat valid without expiration. Improvement Permit with site plan valid for sixty months. Authorization to Construct is valid for a period equal to that of Improvement Permit – not to exceed sixty months.

Signed: date 10-29-99 Installed by: WAYNE CLONTZ

Improvement Permit by: date 10-29-99 Operation Permit by: C. [illegible] RS date 2/01/00 OP

Authorization to Construct by: date 10-29-99 Existing System Inspection by: date

HEALTH DEPT. COPY: WHITE OWNER COPY (FINAL): YELLOW OWNER COPY (INITIAL): PINK