IREDELL COUNTY HEALTH DEPARTMENT

Paid 50.00 Dt

STATESVILLE 704-878-5305 MOORESVILLE 704-664-5281

IMPROVEMENT PERMIT / AUTHORIZATION TO CONSTRUCT / OPERATION PERMIT / EXISTING SYSTEM INSPECTION

PERMIT# 2594 (92857) PIN# ~~Pt of 2SA51~~ 4639475195 DATE 8/16/00

OWNER OR CONTRACTOR Frank Lawton Jr. PHONE: Business _____ Home 664-7113

ADDRESS 188 Turnberry Ln. Mooresville, NC. 28117

LOCATION North N TR Fern Hill TR Tennessee Creek, on (R) to 10th lot on (R)

SUBDIVISION Northwood BLOCK / SECTION _____ LOT 8 LOT AREA ~4.8 Ac SITE CLASS. RS per 1950 DESIGN FLOW 600 L.T.A.R. .3

Septic Tank: 1500 Gallons; STB 1011 Date 3/4/01
Pump Tank: 1500 Gallons; PT 99 Date 9/30/00
Pump Make: MYERS Model ME 50 M1 Serial No. _____
Nitrification Field: No Fields 1 Square Feet 1500 Linear Feet 500
No Lines ~~Feet~~ Trench Width 36" Max Trench Bottom Depth 30" Gravel Depth SAND.

[X] New System [ ] Repair System Type: I, II, (III), IV, V, VI
System Description: HOS on C#P Plastic + Pres. Man.
Repair System Description: 16" PPBS
Maintenance Agreement Required: [ ] Yes [X] No


[X] House/Mod. Home No. Bedrooms 5
[ ] Mobile Home No. Bathrooms 3.5
[ ] Business No. Employees _____
[ ] Other _____
[ ] Slab [ ] Crawl Space [X] Basement w/plumbing [ ] Basement wo/plumbing

Water Supply: [X] Individual [ ] Public [ ] Community

Comments:/Conditions: 40@125'


Comments:/Conditions:

(1" = 200') INITIAL SITE SKETCH

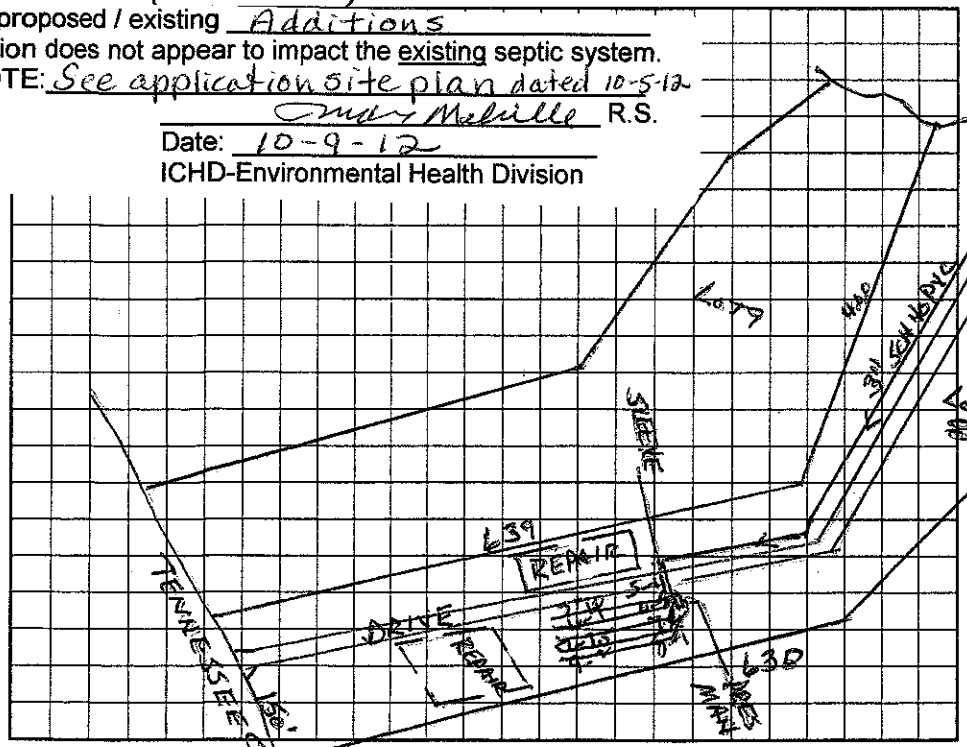

The proposed / existing Additions addition does not appear to impact the existing septic system.
*NOTE: See application site plan dated 10-5-12
Amy Melville R.S.
Date: 10-9-12
ICHD-Environmental Health Division

AS BUILT SKETCH

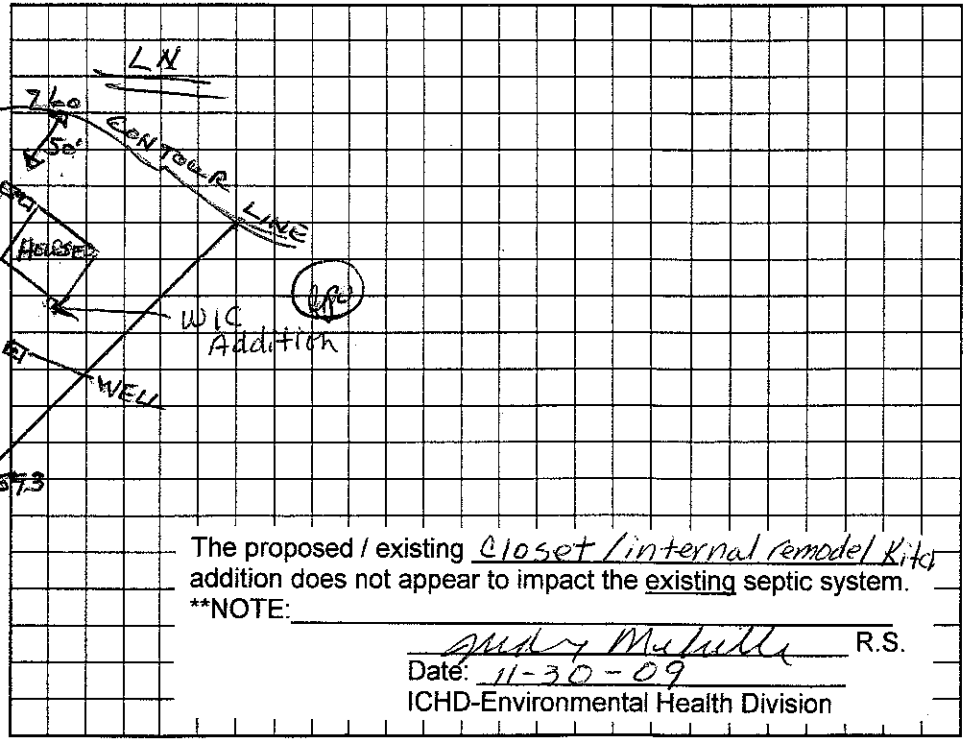

The proposed / existing Closet / internal remodel / Kit addition does not appear to impact the existing septic system.
**NOTE: _____
Amy Melville R.S.
Date: 11-30-09
ICHD-Environmental Health Division

Permit can be suspended or revoked if any false information is supplied toward securing the permit/any unauthorized changes are made to the site/any unauthorized changes are made in the installation of the system. Improvement Permit with plat valid without expiration. Improvement Permit with site plan valid for sixty months. Authorization to Construct is valid for a period equal to that of Improvement Permit – not to exceed sixty months.

Signed: X [signature] date 8/29/00 Installed by: Richard Abernathy

Improvement Permit by: Wesley Sparks RS. date 8/16/00 Operation Permit by: [signature] RS date 8/29/01

Authorization to Construct by: Wesley Sparks RS date 8/16/00 Existing System Inspection by: _____ date _____

HEALTH DEPT. COPY: WHITE OWNER COPY (FINAL): YELLOW OWNER COPY (INITIAL): PINK