IREDELL COUNTY HEALTH DEPARTMENT

STATESVILLE 704-878-5305 #130 MOORESVILLE 704-664-5281

IMPROVEMENT PERMIT / AUTHORIZATION TO CONSTRUCT / OPERATION PERMIT / EXISTING SYSTEM INSPECTION

PERMIT# 114333 PIN# 4639 47 8050 DATE 8/12/03

OWNER OR CONTRACTOR Castleview Const. PHONE: Business 704-662-6428 Home

ADDRESS PO Box 2206 Cornelius, NC. 28031

LOCATION Perth N TR Tennessee Circle, 6th parcel on (R)

SUBDIVISION NORTHWOODS BLOCK / SECTION LOT 6 LOT AREA ~3 AC SITE CLASS PS DESIGN FLOW 360 L.T.A.R. .3

Septic Tank: 1000 Gallons; STB 825 Date 12/24/03

Pump Tank: 1000 Gallons; PT 302 Date 1/7/04

Pump Make: ZOELLER Model M-140 Serial No.

Nitrification Field: No Fields 1 Square Feet 900 Linear Feet 300

No Lines 4 @ 75' Trench Width 3 Max Trench Bottom Depth 24" Gravel Depth N/A

[X] New System [ ] Repair System Type: I, II, (III), IV, V, VI

System Description: Pump-PM → Type 3

Repair System Description: Same

Maintenance Agreement Required: [ ] Yes [X] No

[X] House/Mod. Home No. Bedrooms 3

[ ] Mobile Home No. Bathrooms 3

[ ] Business No. Employees

[ ] Other

[ ] Slab [X] Crawl Space [ ] Basement w/plumbing [ ] Basement wo/plumbing


Water Supply: [X] Individual [ ] Public [ ] Community

Comments:/Conditions: Lines to be installed on contour in direction shown


Comments:/Conditions:

(1" = 100')

INITIAL SITE SKETCH

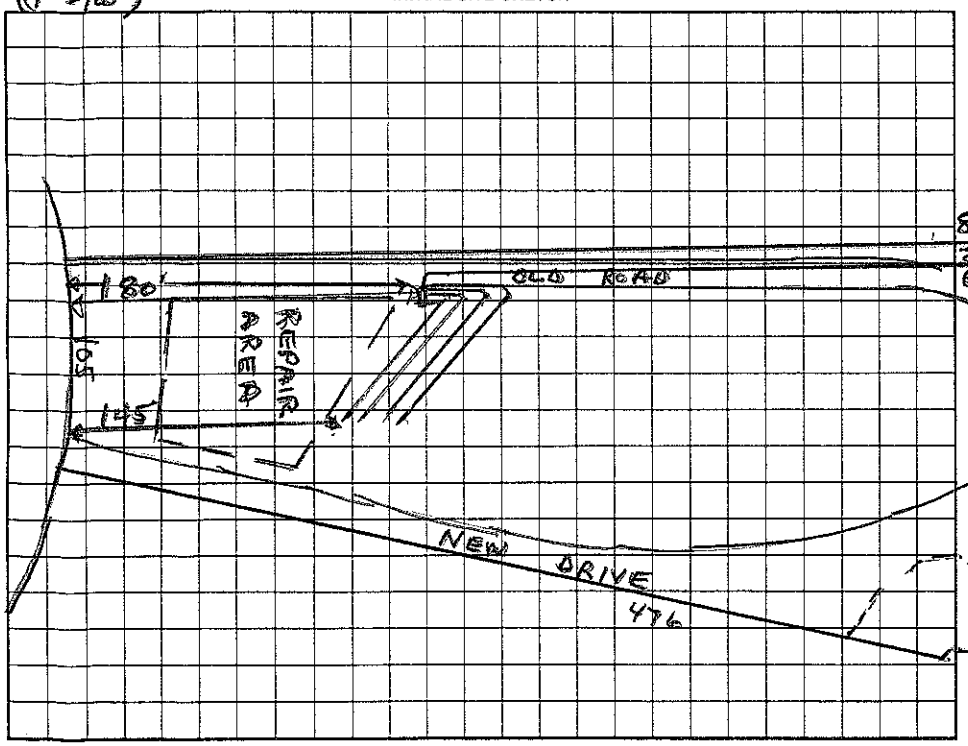

AS BUILT SKETCH

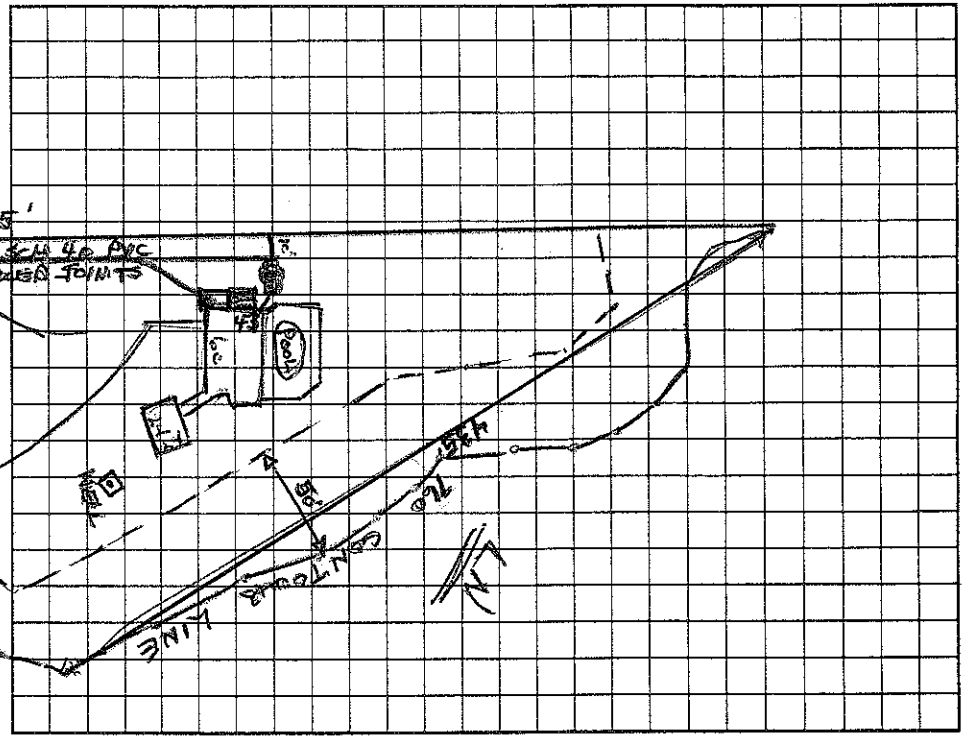

Permit can be suspended or revoked if any false information is supplied toward securing the permit/any unauthorized changes are made to the site/any unauthorized changes are made in the installation of the system. Improvement Permit with plat valid without expiration. Improvement Permit with site plan valid for sixty months. Authorization to Construct is valid for a period equal to that of Improvement Permit -- not to exceed sixty months.

Signed: [signature] date

Improvement Permit by: Wesley Sparks RS date 8/12/03

Authorization to Construct by: Wesley Sparks RS date 8/12/03

Installed by: Joe Thompson

Operation Permit by: Wesley Sparks RS date 3/10/04

Existing System Inspection by: date

HEALTH DEPT. COPY: WHITE OWNER COPY (FINAL): YELLOW OWNER COPY (INITIAL): PINK