IREDELL COUNTY HEALTH DEPARTMENT

STATESVILLE 704-878-5305 MOORESVILLE 704-664-5281

IMPROVEMENT PERMIT / AUTHORIZATION TO CONSTRUCT / OPERATION PERMIT / EXISTING SYSTEM INSPECTION

PERMIT# 126568 PIN# 4639 480340 DATE 6/9/06

OWNER OR APPLICANT Neil Parker PHONE: Business 500-1643 Home

ADDRESS 160 Foxtail Dr Mooresville, NC 28117

LOCATION Perth Rd TL Neil Farm Rd N/1.1 miles on Right Above the road

SUBDIVISION Northwood BLOCK / SECTION 2 LOT 22 LOT AREA N/.78 Acre SITE CLASS. PS DESIGN FLOW 360gpd L.T.A.R. .3

Septic Tank: 1000 Gallons; STB 524 Date 3/29/05

Pump Tank: ____ Gallons; PT ____ Date ____

Pump Make: ____ Model ____ Serial No. ____

Nitrification Field: No Fields 1 Square Feet 900' Linear Feet 300'

No Lines 5@60 Trench Width 36" Max Trench Bottom Depth 36" Gravel Depth N/A ☒ Gravity ☐ Pressure

☒ New System ☐ Repair ☐ Expansion System Type: I (II) III IV V VI

System Description: Gravity -- 25% Reduction

Repair System Description: Panel Block

Maintenance Agreement Required: ☐ Yes ☒ No

☒ House/Mod. Home No. Bedrooms 3

☐ Mobile Home No. Persons ____

☐ Business No. Employees ____

☐ Other ____

Water Supply: ☒ Individual ☐ Public ☐ Community


☐ Slab ☐ Crawl Space ☐ Basement w/plumbing ☐ Basement wo/plumbing

Comments:/Conditions: Replaces previous 4 Bedroom permit

Scale 1:50

Comments:/Conditions: Note: Keep Septic System 100Ft From well. If One piece of water tested ST used than it can be less than 100Ft to well but greater than 50Ft.

INITIAL SITE SKETCH PL 239

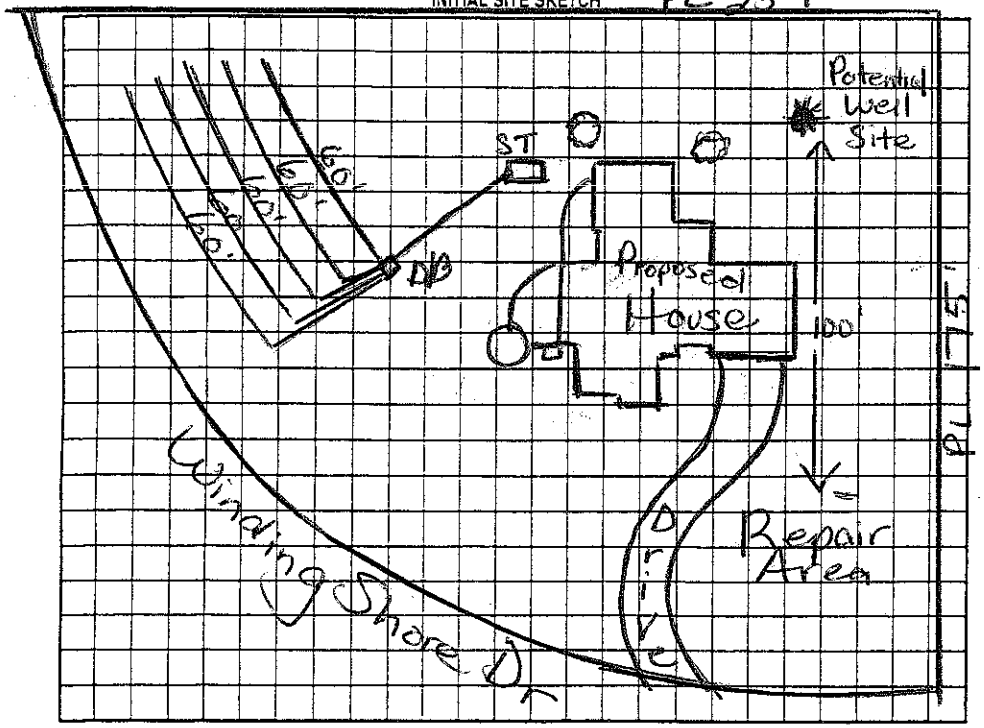

AS BUILT SKETCH

Shaft Heater Quick 4 Wt installed

Permit can be suspended or revoked if any false information is supplied toward securing the permit/any unauthorized changes are made to the site/any unauthorized changes are made in the installation of the system. Improvement Permit with plat valid without expiration. ☐ Improvement Permit with site plan valid for sixty months ☐ Authorization to Construct is valid for a period equal to that of Improvement Permit – not to exceed sixty months.

Signed: Sharon Parker date 6/13/06

Improvement Permit by: Maria H. Dotson date 6/9/06

Authorization to Construct by: Maria H. Dotson date 6/9/06

Installed by: Alexander Heating

Operation Permit by: Wesley Sperko PS. date 8/7/06

Existing System Inspection by: ____ date ____

HEALTH DEPT. COPY: WHITE OWNER COPY (FINAL): YELLOW OWNER COPY (INITIAL): PINK