# IREDELL COUNTY HEALTH DEPARTMENT

Authorization to Construct

STATESVILLE 704-878-5305 MOORESVILLE 704-664-5281

## IMPROVEMENT PERMIT / ~~CERTIFICATE OF COMPLETION~~ / OPERATION PERMIT / EXISTING SYSTEM INSPECTION

PROPERTY DESCRIPTION NO. 067652 DATE 8/12/97 TAX MAP NO. 4639.58 6311 Watershed: X Yes ☐ No

OWNER OR CONTRACTOR Russell Thompson PHONE: Business 660-6820 ~~Home~~ 463-48-1487

ADDRESS N Main St Mooresville, NC 28115

LOCATION Perth Rd N TL Neill Farm Rd., to 4th lot before cul de sac on (R)

SUBDIVISION Northwood BLOCK / SECTION II LOT 21 LOT AREA 1.36 SITE CLASS. PS DESIGN FLOW 480 L.T.A.R. 1.3

Septic Tank: 1000 Gallons; STB 794 Date 2/10/99

Pump Tank: _____ Gallons; PT _____ Date _____

Pump Make: _____ Model _____ Serial No. _____

Nitrification Field: No Fields 1 Square Feet 1600 Linear Feet 533

No Lines 5 Trench Width 36" Max Trench Bottom Depth 32" Gravel Depth 12"

X New System ☐ Repair System Type: I, II, III, IV, V, VI

System Description: Gravity - Conventional

Repair System Description: Same

Maintenance Agreement Required: ☐ Yes ☒ No

☒ House/Mod. Home No. Bedrooms 4

☐ Mobile Home No. Bathrooms 4

☐ Business No. Employees _____

☐ Other _____


☐ Slab ☒ Crawl Space ☐ Basement w/plumbing ☐ Basement wo/plumbing

Water Supply: X Individual ☐ Community ☐ Public


Comments: House located to avoid pond for pumping of house is mound toward road or site to be heavily graded - pumping will become necessary

Comments:

INITIAL SITE SKETCH

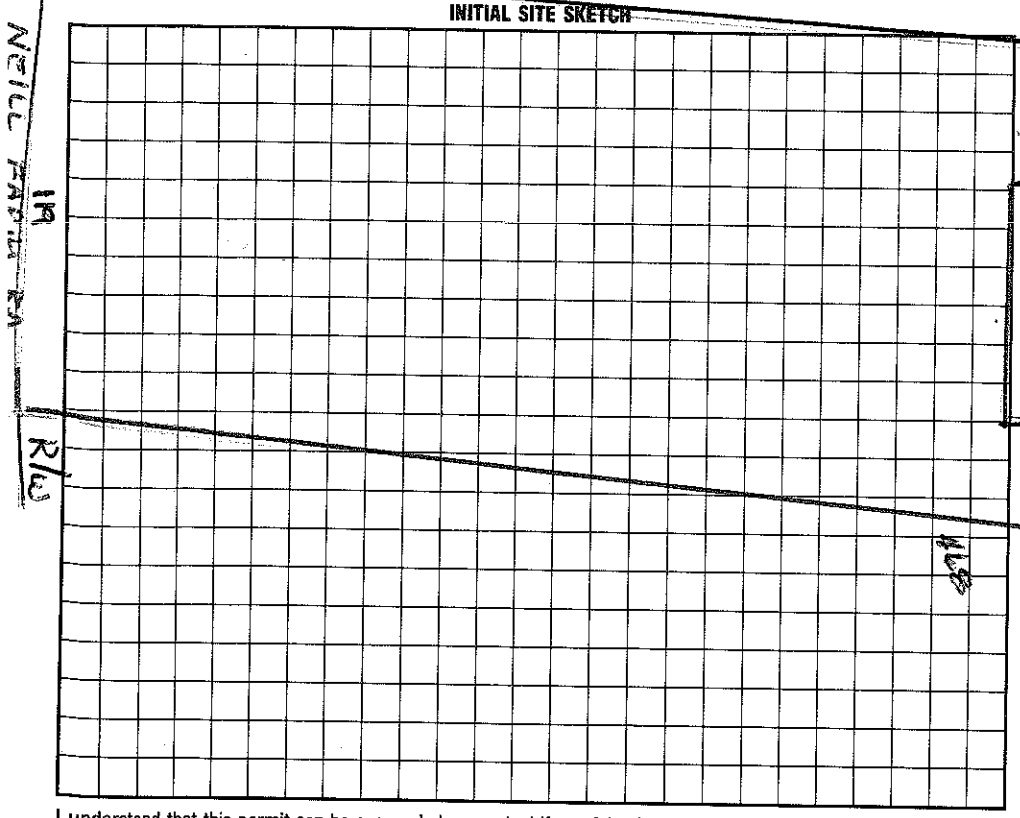


AS BUILT SKETCH

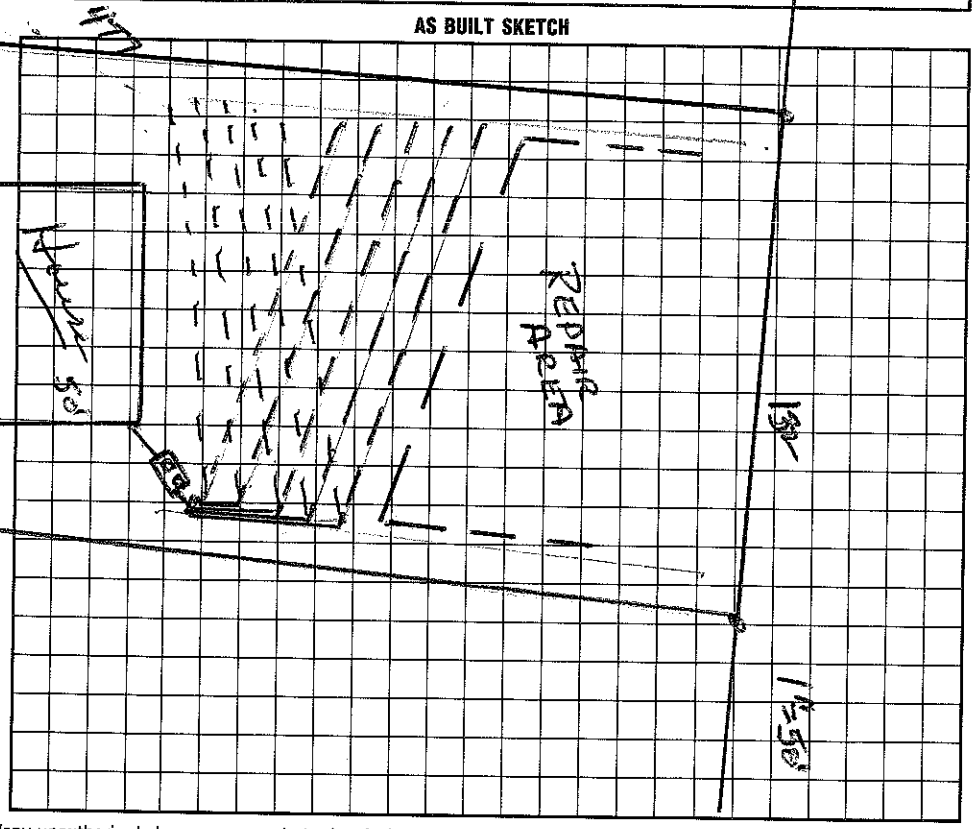


I understand that this permit can be suspended or revoked if any false information is supplied toward securing the permit/any unauthorized changes are made to the site/any unauthorized changes are made in the installation of the system. Improvement Permit is valid for 60 months from date of issuance.

Signed: Thomas N. Brooks

Improvement Permit by: Wesley Sparks R.S. date 8/14/97

Existing System Inspection by: Wesley Sparks R.S. date 8/14/97

Installed by: Piedmont Backhoe

Certificate of Completion by: _____ date _____

Operation Permit by: Wesley Sparks R.S. date 7/29/99

HEALTH DEPT. COPY: WHITE INSPECTION COPY (FINAL): GREEN OWNER COPY (FINAL): YELLOW INSPECTION COPY (INITIAL): PINK OWNER COPY (INITIAL): GOLD