IREDELL COUNTY HEALTH DEPARTMENT

STATESVILLE 704-878-5305 130.00 Paid MOORESVILLE 704-664-5281

IMPROVEMENT PERMIT / AUTHORIZATION TO CONSTRUCT / OPERATION PERMIT / EXISTING SYSTEM INSPECTION

PERMIT# 122005 PIN# 4639-48-3113 DATE

OWNER OR CONTRACTOR Gary + Betty Morgan PHONE: Business Home 704-279-6043

ADDRESS 360 Luther Barger Rd Salisbury NC 28146

LOCATION Perth, TL Ne. Form, straight to Winding Shore on Lt #333

SUBDIVISION Clark BLOCK / SECTION 16 LOT 121 LOT AREA 0.69 Ac SITE CLASS. AS DESIGN FLOW 480 L.T.A.R. 0.3

Septic Tank: 1000 Gallons; STB 1007 Date 5/6/06

Pump Tank: Gallons; PT Date

Pump Make: Model Serial No.

Nitrification Field: No Fields 1 Square Feet 810 Linear Feet 270

No Lines 6@45" Trench Width 24" or 36" Max Trench Bottom Depth 36" Gravel Depth —

☒ New System ☐ Repair System Type: I, II, III, IV, V, VI

System Description: Gravity Panel Block

Repair System Description: See comments

Maintenance Agreement Required: ☐ Yes ☒ No

☒ House/Mod. Home No. Bedrooms 4

☐ Mobile Home No. Bathrooms 4

☐ Business No. Employees

☐ Other


☐ Slab ☐ Crawl Space ☒ Basement w/plumbing ☐ Basement wo/plumbing

Water Supply: ☒ Individual ☐ Public ☐ Community

Comments:/Conditions: 85% 95%

Comments:/Conditions: * Exempt from Repair (<1945 c.) - Potential Repair area available if well is properly abandoned and relocated to optional well site

INITIAL SITE SKETCH

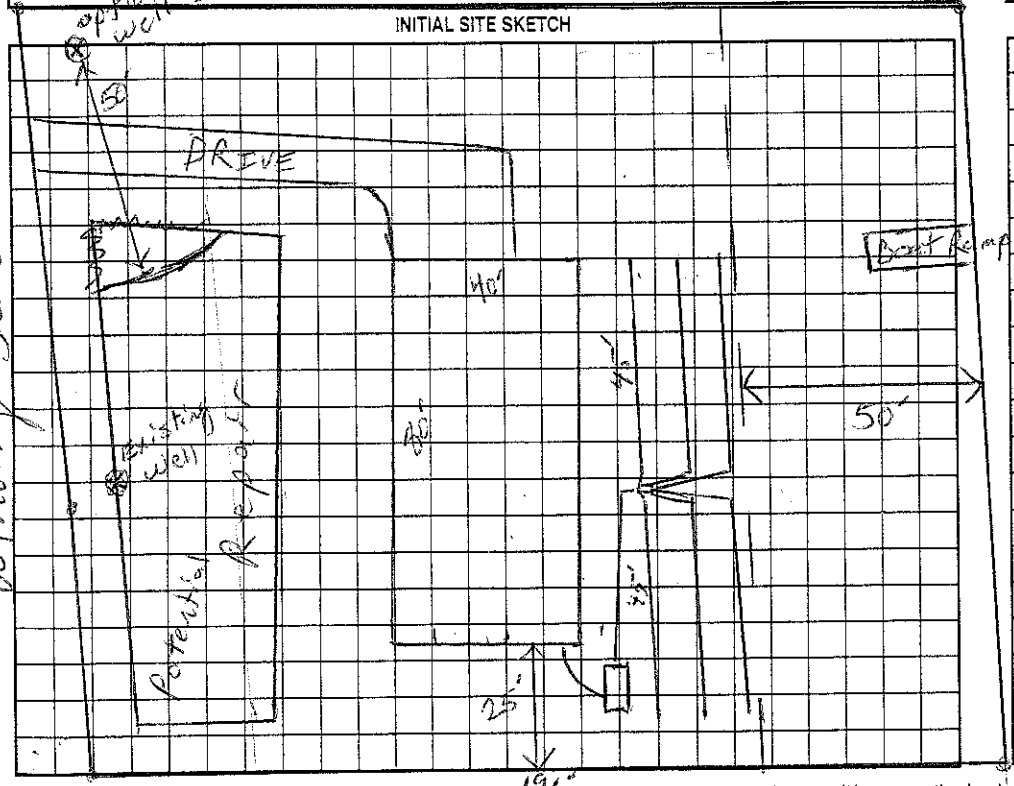

AS BUILT SKETCH

Reviewed Site plan & floor plan 4/4/05, essentially in Compliance with original permit.

LAKE NORMAN

Permit can be suspended or revoked if any false information is supplied toward securing the permit/any unauthorized changes are made to the site/any unauthorized changes are made in the installation of the system. Improvement Permit with plat valid without expiration. Improvement Permit with site plan valid for sixty months. Authorization to Construct is valid for a period equal to that of Improvement Permit – not to exceed sixty months.

Signed: Betty R Morgan date 7-26-04 Installed by: Abernathy

Improvement Permit by: RS date 7/19/04 Operation Permit by: RS date 7/11/06

Authorization to Construct by: Maria Hill RS date 4/4/05 Existing System Inspection by: date

HEALTH DEPT. COPY: WHITE OWNER COPY (FINAL): YELLOW OWNER COPY (INITIAL): PINK