IREDELL COUNTY HEALTH DEPARTMENT

STATESVILLE 704-878-5305 MOORESVILLE 704-664-5281

IMPROVEMENT PERMIT / AUTHORIZATION TO CONSTRUCT / OPERATION PERMIT / EXISTING SYSTEM INSPECTION

PERMIT# 123527 PIN# 4639 48 4260 DATE 9/27/04

OWNER OR CONTRACTOR Mark Ritchie PHONE: Business 704-637-0879 Home

ADDRESS 505 Timberlane Tr. Salisbury, NC 28147

LOCATION North N, TL Hwy 150 to R 321-527 on (L) side

SUBDIVISION C.L.T. BLOCK / SECTION 16 LOT 120 LOT AREA .67 SITE CLASS PS DESIGN FLOW 480 L.T.A.R. .3

Septic Tank: 1000 Gallons: STB Date

Pump Tank: 1000 Gallons: PT Date

Pump Make: Model Serial No.

Nitrification Field: No Fields 1 Square Feet 1200 ± Linear Feet 400 ±

No. Lines 4 @ 100' Trench Width 3' Max Trench Bottom Depth 3' Gravel Depth

[X] New System [ ] Repair System Type: I II III IV V VI

System Description: Pues Mean – Type 3 Drainfield

Repair System Description: Same

Maintenance Agreement Required: [ ] Yes [X] No

[X] House/Mod. Home No. Bedrooms

[ ] Mobile Home No. Bathrooms

[ ] Business No. Employees

[X] Other Addition 480.

[ ] Slab [ ] Crawl Space [X] Basement w/plumbing [ ] Basement wo/plumbing


Water Supply: [X] Individual [ ] Public [ ] Community

Comments/Conditions:


120

10 #120

INITIAL SITE SKETCH

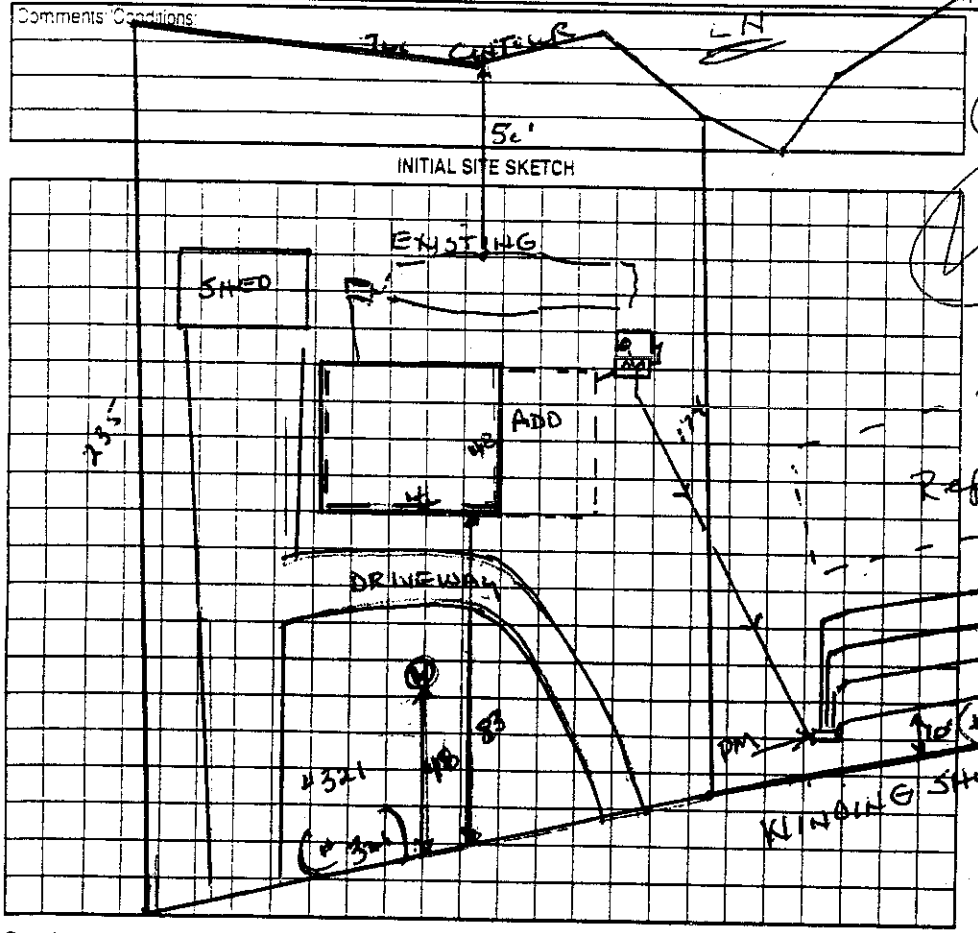

AS BUILT SKETCH

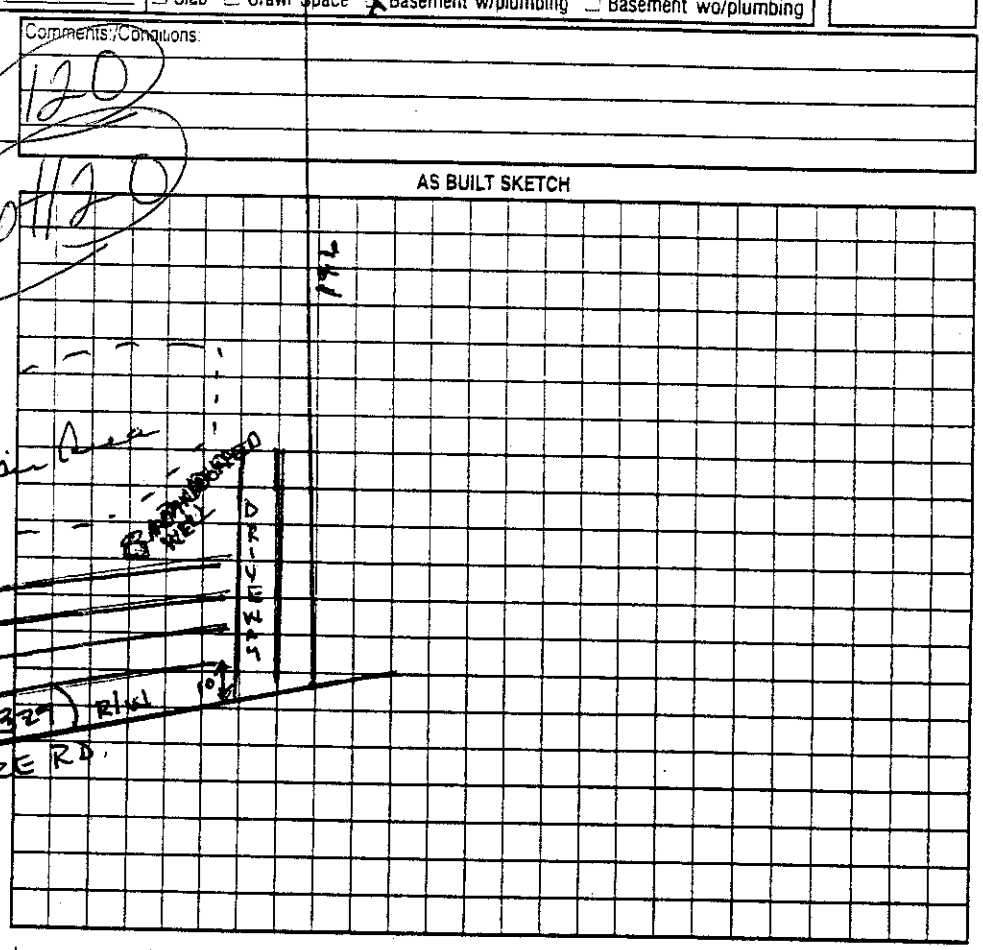

Permit can be suspended or revoked if any false information is supplied toward securing the permit/any unauthorized changes are made to the site/any unauthorized changes are made in the installation of the system. Improvement Permit with plat valid without expiration. Improvement Permit with site plan valid for sixty months. Authorization to Construct is valid for a period equal to that of Improvement Permit – not to exceed sixty months.

Signed: Shawn Hooper date

Improvement Permit by: Wesley Sparks R.S. date 9/28/04

Authorization to Construct by: Wesley Sparks R.S. date 9/28/04

Installed by:

Operation Permit by: date

Existing System Inspection by: date

HEALTH DEPT. COPY: WHITE OWNER COPY (FINAL): YELLOW OWNER COPY (INITIAL): PINK