IREDELL COUNTY HEALTH DEPARTMENT

STATESVILLE 704-878-5305 MOORESVILLE 704-664-5281

IMPROVEMENT PERMIT / AUTHORIZATION TO CONSTRUCT / OPERATION PERMIT / EXISTING SYSTEM INSPECTION

PERMIT # 163140 PIN # 4639-48-9076 DATE 10-20-10

OWNER or APPLICANT William Graham PHONE: Business 704-508-4637 Home:

OWNER or APPLICANT ADDRESS 128 La Agua Ln Troutman 28166

LOCATION / DIRECTIONS Perth, Neil Farm, Winding Shore, La Agua

SUBDIVISION Clet BLOCK / SECTION 16 LOT # 116 LOT AREA .947 AC DESIGN FLOW 240 GPD L.T.A.R.

Septic Tank EXISTING 1000 Gallons: STB Date

Pump Tank Gallons: P T Date

Pump Make Model Serial #

Nitrification Field No Fields No Lines Linear Feet

Trench Width Max. Trench Bottom Depth Gravel Depth

☐ New System ☐ Repair ☐ Expansion System Type I II III IV V VI

System Description: GRAVITY BED

Repair System Description: ≤ 1983

Maintenance Agreement Required ☐ YES ☐ NO

☒ GRAVITY ☐ PRESSURE

☒ Residence No. Bedrooms 2

☐ Business No. Persons

☒ Other No. Employees

☒ Slab ☒ Crawl Space

☐ Basement w/plumbing ☐ Basement w/o plumbing


Water Supply: ☒ Private ☐ Public ☐ Community

Comments / Conditions (1) USE MIN 10' OF 4" PIPE PRIOR TO SEPTIC TANK TO ALLOW SOLIDS TO SETTLE (2) RUN SEWER LINE CLOSE TO 50' LAKE SETBACK TO ALLOW FUTURE EXPANSION OF SEPTIC

INITIAL SITE SKETCH

Comments / Conditions SHED 10' OF 4" PIPE

AS BUILT SKETCH

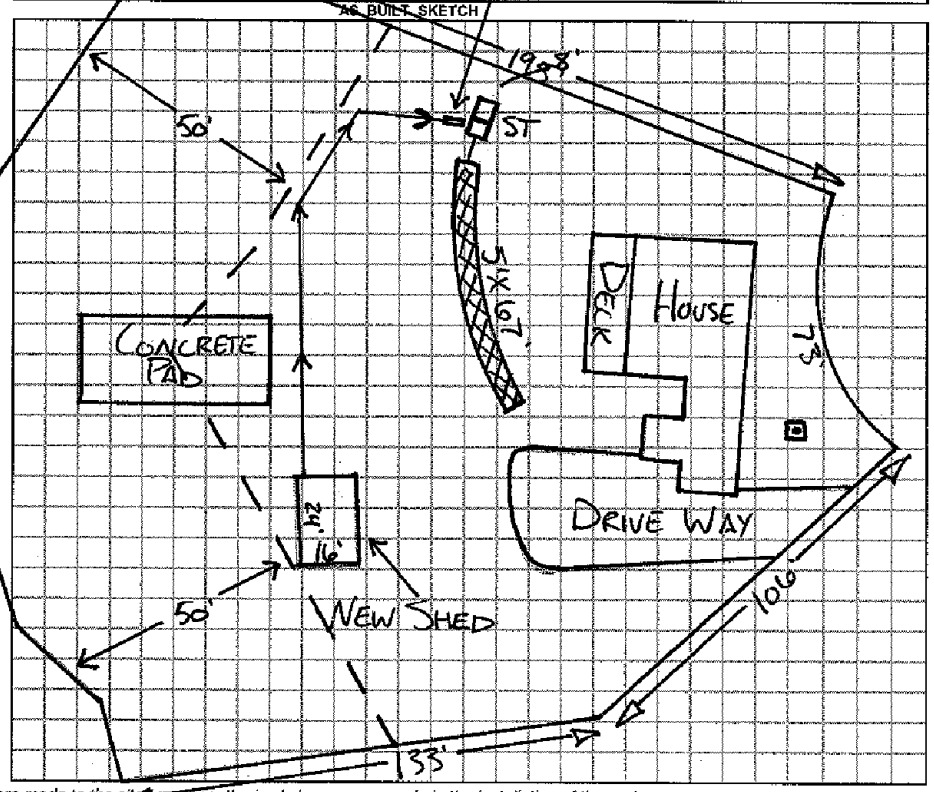

Permit can be suspended or revoked if any false information is supplied toward securing the permit / any unauthorized changes are made to the site / any unauthorized changes are made in the installation of the system.

☐ *IMPROVEMENT PERMIT w / plat valid without expiration.* ☐ *IMPROVEMENT PERMIT w / site plan valid for 60 mos.* ☐ *AUTHORIZATION TO CONSTRUCT valid for period equal to IMPROVEMENT PERMIT-not to exceed 60 mo.*

Owner / Applicant Signature: William Graham Date 10-20-10

Improvement Permit by: Date

Authorization to Construct by: Date

YOU SHOULD CONTACT A LOCATOR SERVICE PRIOR TO ANY EXCAVATION.

Installed by:

Operation Permit by: Date:

Existing System Inspected by: B A Ellis REHS Date: 10-20-10

WHITE COPY Environmental Health YELLOW COPY (Final) Owner / Applicant PINK COPY (Initial) Owner / Applicant