IREDELL COUNTY HEALTH DEPARTMENT

STATESVILLE 704-878-5305 MOORESVILLE 704-664-5281

IMPROVEMENT PERMIT / AUTHORIZATION TO CONSTRUCT / OPERATION PERMIT / EXISTING SYSTEM INSPECTION

PERMIT# 088847 PIN# 4639489268 DATE 4/6/2000

OWNER OR CONTRACTOR Lanny Jay PHONE: Business Home 528-9323

ADDRESS 124 La Agua Ln Troutman, NC

LOCATION Perth Rd TL Neil Farm TL La Agua Ln 1st Trailer

SUBDIVISION CL&T (16) BLOCK / SECTION # 125 LOT 1.01 LOT AREA SITE CLASS. DESIGN FLOW 360gpd L.T.A.R.

Septic Tank: 1000 Gallons; STB Date

Pump Tank: Gallons; PT Date

Pump Make: Model Serial No.

Nitrification Field: No Fields 1 Square Feet 1200' Linear Feet 900'

No Lines 4@75' Trench Width 36" Max Trench Bottom Depth Gravel Depth 12"

☐ New System ☐ Repair System Type: I, II, III, IV, V, VI

System Description: Existing Gravity - Conventional

Repair System Description: Pump - Innovative

Maintenance Agreement Required: ☐ Yes ☒ No

☒ House/Mod. Home No. Bedrooms 2

☐ Mobile Home No. Bathrooms 2

☐ Business No. Employees

☐ Other


☐ Slab ☐ Crawl Space ☐ Basement w/plumbing ☐ Basement wo/plumbing

Water Supply: ☒ Individual ☐ Public ☐ Community

Comments:/Conditions: Existing Septic System appears to be functioning okay at time of inspection, NO problems Noticed.

Comments:/Conditions: ☆Plumbing for new house will be at same. Evaluation of existing MH, per owner. Septic System originally sized for 3 Bedroom; installed 1988.

Not to Scale INITIAL SITE SKETCH

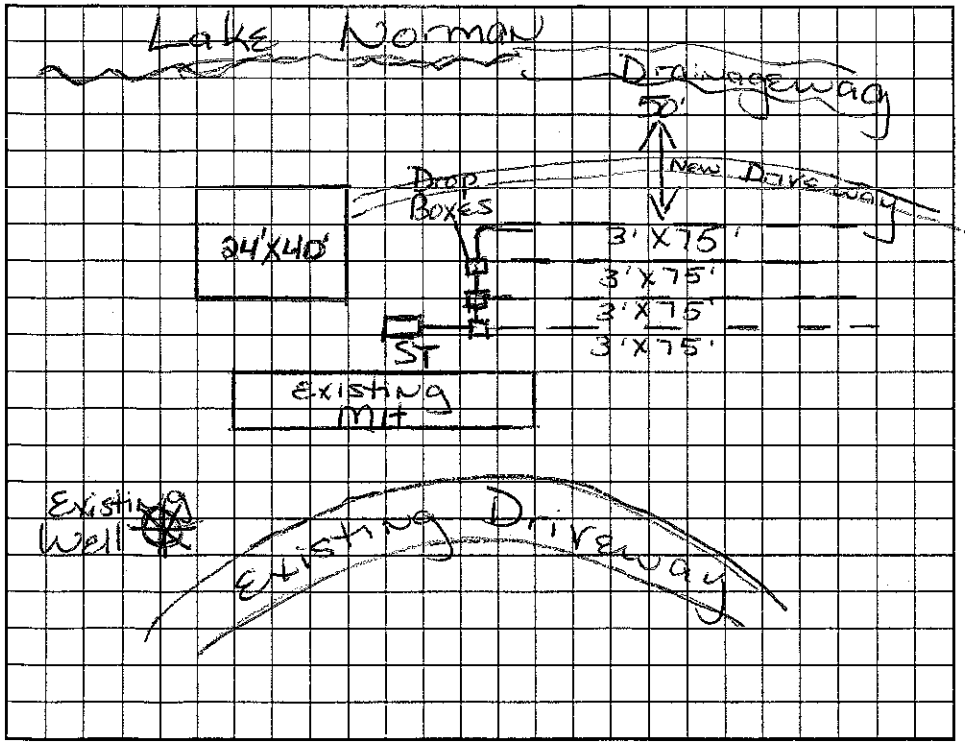

AS BUILT SKETCH

Permit can be suspended or revoked if any false information is supplied toward securing the permit/any unauthorized changes are made to the site/any unauthorized changes are made in the installation of the system. Improvement Permit with plat valid without expiration. Improvement Permit with site plan valid for sixty months. Authorization to Construct is valid for a period equal to that of Improvement Permit – not to exceed sixty months.

Signed date Installed by:

Improvement Permit by: Melissa H. Dotson R.S. date 4/6/2000 Operation Permit by: date

Authorization to Construct by: date Existing System Inspection by: Melissa H. Dotson R.S. date 4/6/2000

HEALTH DEPT. COPY: WHITE OWNER COPY (FINAL): YELLOW OWNER COPY (INITIAL): PINK