IREDELL COUNTY HEALTH DEPARTMENT

STATESVILLE 704-878-5305 50.00 Paid MOORESVILLE 704-[illegible]31 (4)

IMPROVEMENT PERMIT / AUTHORIZATION TO CONSTRUCT / OPERATION PERMIT / EXISTING SYSTEM INSPECTION

PERMIT# 105055 PIN# 4639 49 5280

OWNER OR CONTRACTOR Edward Tarantino DATE 3/18/02

ADDRESS PO Box 596 Turnell, NC. 28682 PHONE: Business 828-478-2711 Home

LOCATION Path N Ti Neil Farm Rd. onto Windy Shore on (R) B4 high power lines

SUBDIVISION Northwood BLOCK / SECTION LOT 26 LOT AREA 1.84 SITE CLASS PS DESIGN FLOW 360 L.T.A.R. .3

Septic Tank: 1000 Gallons; STB 325 Date 3/4/03

Pump Tank: 1000 Gallons; PT 302 Date 1/14/03

Pump Make: ZOELLER Model N 140 Serial No.

Nitrification Field: No Fields 1 Square Feet 900 X Linear Feet 300 X

No Lines 3@100' Trench Width 3' Max Trench Bottom Depth 3'

X New System ☐ Repair System Type: I, II, (III), IV, V, VI

System Description: Pressure Man. → EZ Flow or in Place

Repair System Description: Same

Maintenance Agreement Required: ☐ Yes X No

Gravel Depth No

X House/Mod. Home No. Bedrooms 3

☐ Mobile Home No. Bathrooms 3

☐ Business No. Employees

☐ Other

☐ Slab ☐ Crawl Space X Basement w/plumbing ☐ Basement wo/plumbing


Water Supply: X Individual ☐ Public ☐ Community

Comments:/Conditions:

Comments:/Conditions:

(1" = 50')

INITIAL SITE SKETCH

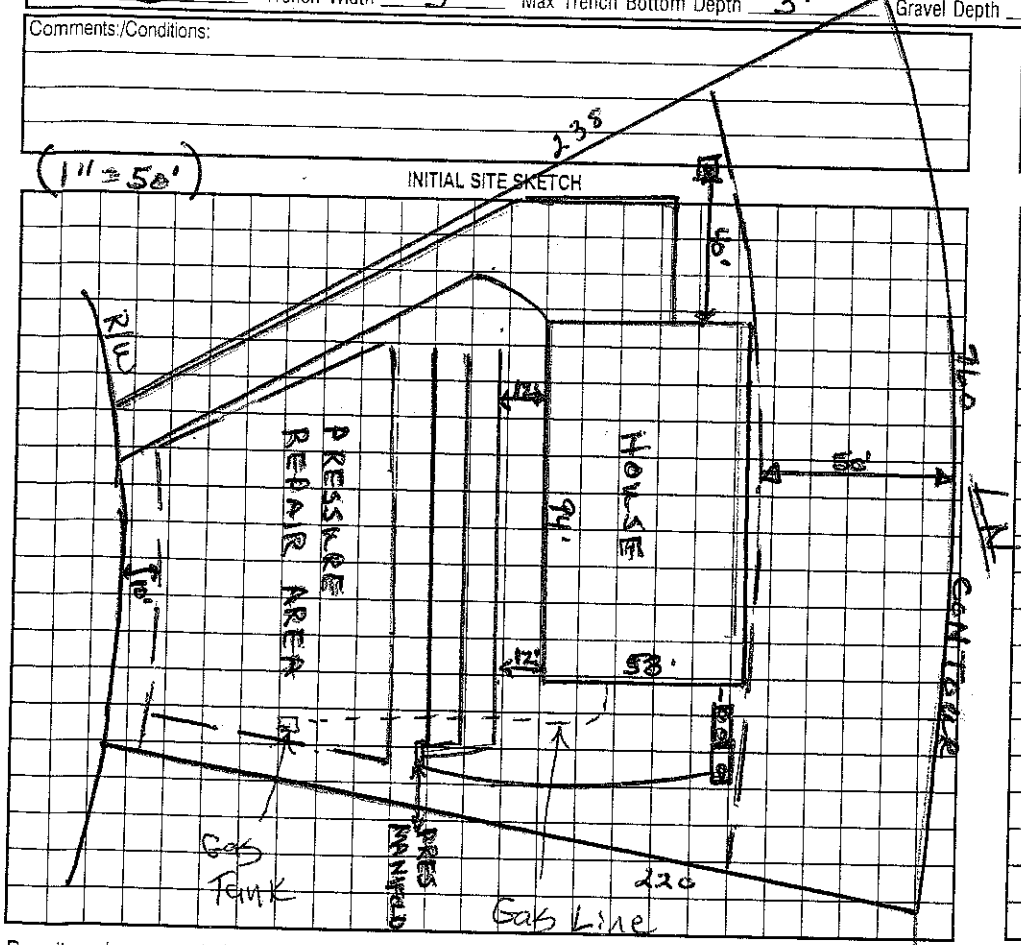

AS BUILT SKETCH

Permit can be suspended or revoked if any false information is supplied toward securing the permit/any unauthorized changes are made to the site/any unauthorized changes are made in the installation of the system. Improvement Permit with plat valid without expiration. Improvement Permit with site plan valid for sixty months. Authorization to Construct is valid for a period equal to that of Improvement Permit – not to exceed sixty months.

Signed: [signature] date 3-25-02 Installed by: Rowan Septic

Improvement Permit by: Wesley Sparks RS. date 3/18/02 Operation Permit by: [signature] date 4/2/03

Authorization to Construct by: Wesley Sparks RS. date 3/18/02 Existing System Inspection by: date

HEALTH DEPT. COPY: WHITE OWNER COPY (FINAL): YELLOW OWNER COPY (INITIAL): PINK