IREDELL COUNTY HEALTH DEPARTMENT

STATESVILLE 704-878-5305 MOORESVILLE 704-664-5281

IMPROVEMENT PERMIT / AUTHORIZATION TO CONSTRUCT / OPERATION PERMIT / EXISTING SYSTEM INSPECTION

PERMIT# 133374 PIN# 4639 50 3737 DATE 4/25/06

OWNER OR APPLICANT Eric Williams PHONE: Business 704 892 2502 Home

ADDRESS 243 LIVA LN

LOCATION Perth Rd TL @ Liva Ln, at End

SUBDIVISION CLT BLOCK / SECTION ~~14~~ LOT 130 LOT AREA 0.85AC SITE CLASS. PS DESIGN FLOW 600 L.T.A.R. 0.3

Septic Tank: 1500 Gallons; STB 338 Date

Pump Tank: 1500 Gallons; PT 477 Date

Pump Make: Gould's Model: ~~E512MB~~ Serial No.

Filtrification Field: No Fields 1 Square Feet 664 Linear Feet 332'

No Lines 4@83' Trench Width 24" Max Trench Bottom Depth 36" Gravel Depth —

☒ New System ☐ Repair ☐ Expansion System Type: I II III (IV) V VI

System Description: LP Panel Block

Repair System Description: Same

Maintenance Agreement Required: ☒ Yes ☐ No

☒ House/Mod. Home ☐ Mobile Home ☐ Business ☐ Other

No. Bedrooms 5 No. Persons No. Employees

Water Supply: ☒ Individual ☐ Public ☐ Community

☐ Gravity ☒ Pressure ☐ Slab ☐ Crawl Space ☒ Basement w/plumbing ☐ Basement wo/plumbing


Comments/Conditions:

Old well Must be Abandoned Before AC can be issued.


Comments/Conditions: Checked tanks & 3 lines 10/5/07

10/5/07 Checked 4th line Liva Ln

INITIAL SITE SKETCH

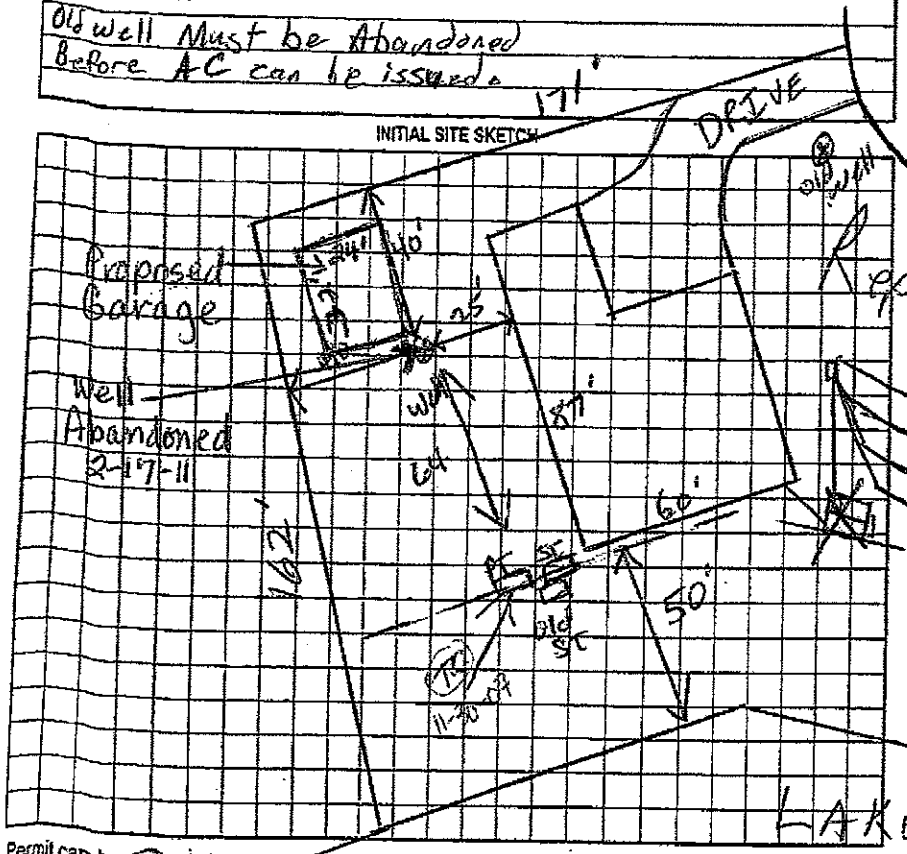

AS BUILT SKETCH

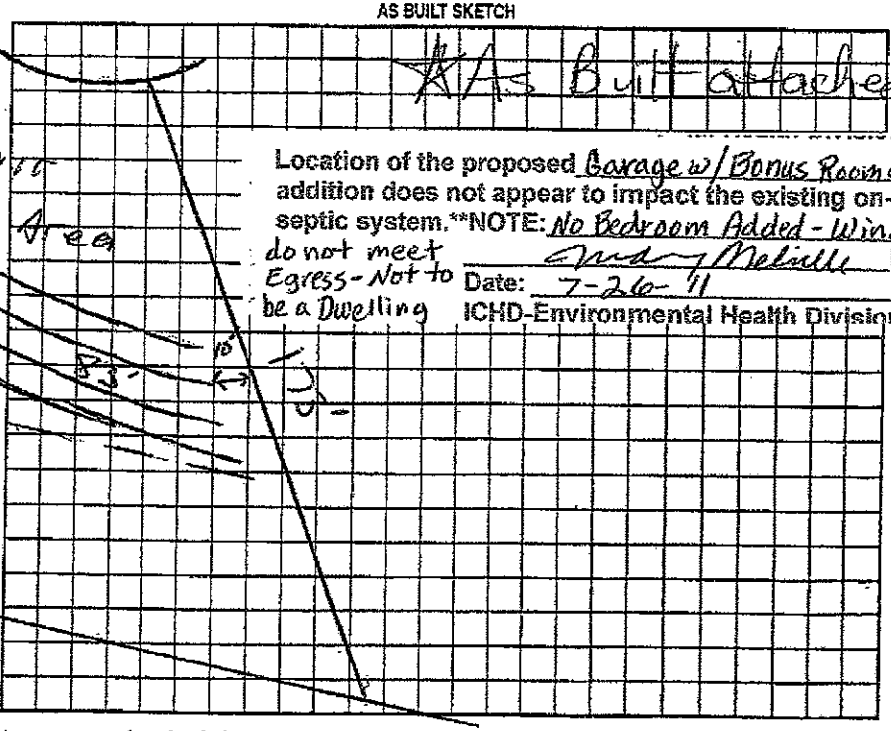

Location of the proposed Garage w/ Bonus Room & Bath addition does not appear to impact the existing on-site septic system.**NOTE: No Bedroom Added - Windows do not meet Egress - Not to be a Dwelling

Date: 7-26-11 REHS

ICHD-Environmental Health Division

Permit can be suspended or revoked if any false information is supplied toward securing the permit/any unauthorized changes are made to the site/any unauthorized changes are made in the installation of the system. Improvement Permit with plat valid without exploration ☐ Improvement Permit with site plan valid for sixty months ☒ Authorization to Construct is valid for a period equal to that of Improvement Permit – not to exceed sixty months.

Signed: date 5/8/06

Improvement Permit by: date 4/25/06

Authorization to Construct by: date 5/8/06

Installed by: date

Operation Permit by: date 11-07

Existing System Inspection by: date

HEALTH DEPT. COPY: WHITE OWNER COPY (FINAL): YELLOW OWNER COPY (INITIAL): PINK