IREDELL COUNTY HEALTH DEPARTMENT

Statesville Office (704) 878-5305 Mooresville Office (704) 660-3625 PERMIT # 209506

IMPROVEMENT PERMIT / AUTHORIZATION TO CONSTRUCT / OPERATION PERMIT / EXISTING SYSTEM

PIN # 4639503737

APPLICANT: David Adams/Fourtees Inc. APPLICANT ADDRESS: P.O. Box 2429 Denver, NC 28037

SITE ADDRESS: 243 Liva Ln. Mooresville, NC 28117 PHONE: 7043613130 ALT. PHONE: 704 998-1903

SITE DIRECTIONS: Hwy 150 W TR Perth Rd TL Liva Ln At End

SUBDIVISION: JCLOT SECTION: 14 LOT # 130 LOT AREA: .85Ac DESIGN FLOW: 600gpd L.T.A.R.: .3

Septic Tank 1500 (gal) STB Date

Pump Tank 1500 (gal) PT Date

Pump Make Model Serial #

Nitrification Fields 1 # Lines 4 to 83' Linear Ft: 332'

Trench Width 24" Max. Trench Bottom Depth 36" Gravel Depth N/A

☐ New System ☐ Repair ☐ Expansion System Type: I II III IV V VI

System Description: Exist. 1 P Panel Block

Repair System Description: Same

Maintenance Agreement Required: ☒ YES ☐ NO

☐ GRAVITY ☒ PRESSURE

☒ Residence No. Bedrooms * 5

☐ Business No. Persons

☐ Other No. Employees

☐ Slab ☐ Crawl Space


☒ Basement w/plumbing ☐ Basement w/o plumbing

Water Supply: ☒ Private ☐ Public ☐ Community


Comments / Conditions: The proposed building meets setbacks to Septic and well and does not appear to impact the existing Septic System.

* Originally permitted for 5 Bedrooms

INITIAL SITE SKETCH

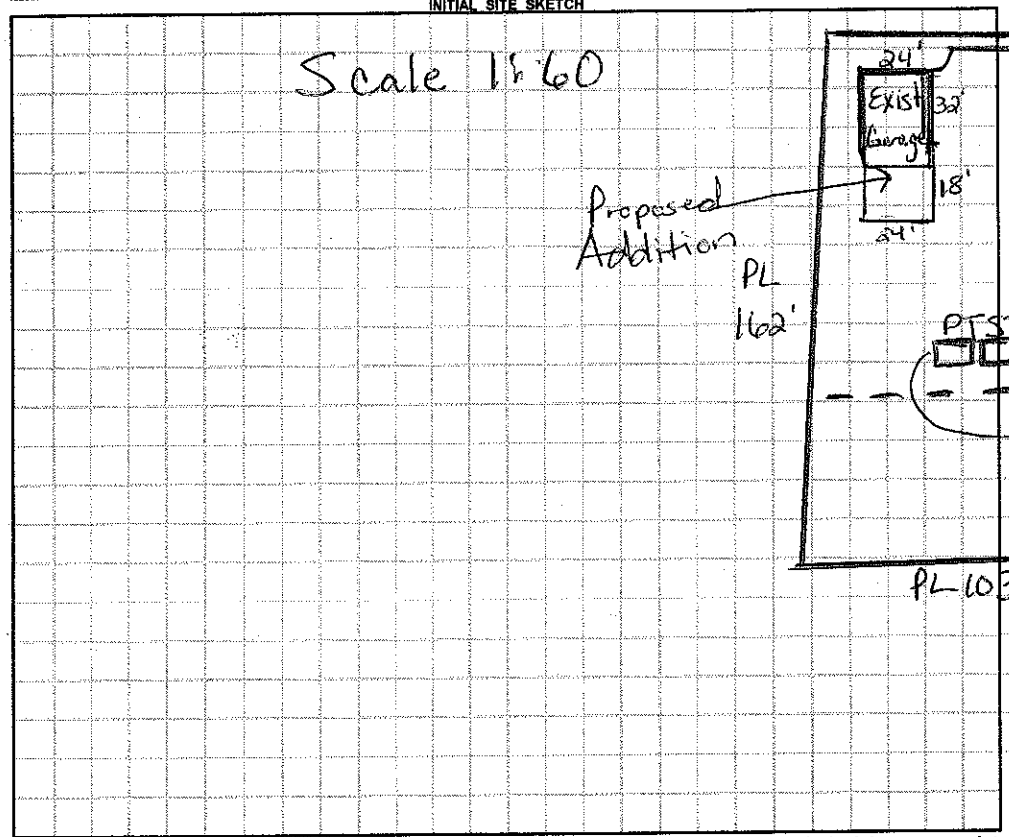

AS BUILT SKETCH

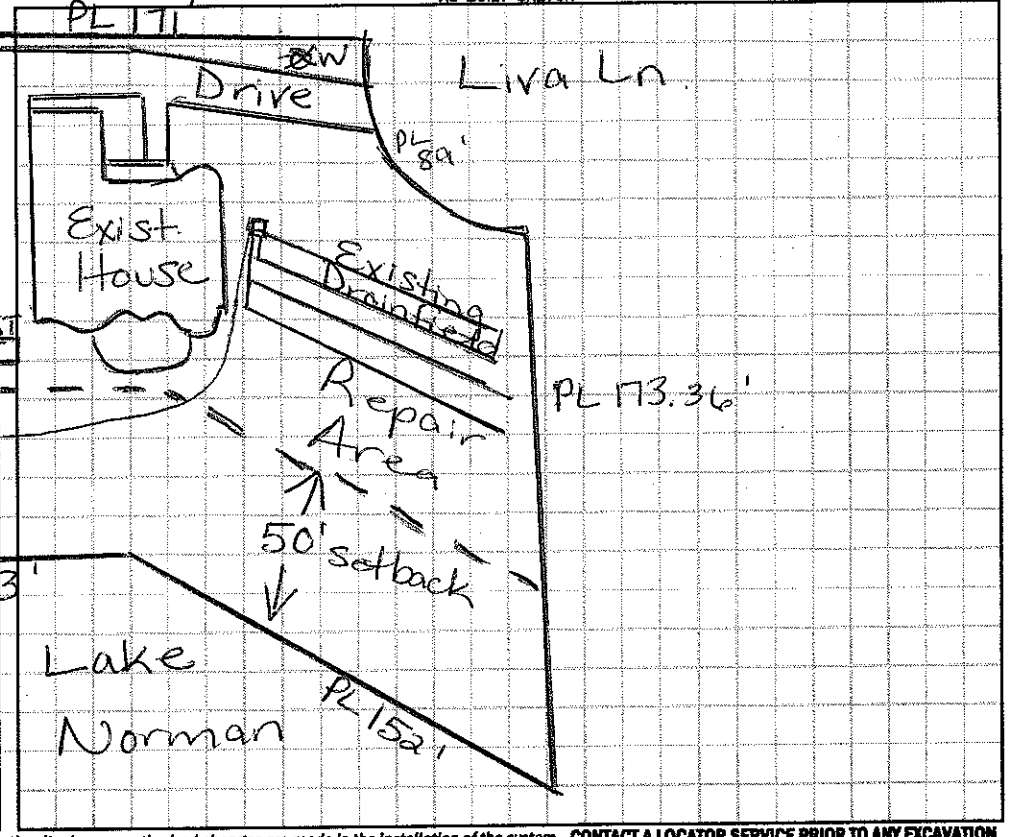

Permit can be suspended or revoked if any false information is supplied toward securing the permit / any unauthorized changes are made to the site / any unauthorized changes are made in the installation of the system. **CONTACT A LOCATOR SERVICE PRIOR TO ANY EXCAVATION**

☐ **IMPROVEMENT PERMIT** *with plat valid without expiration.* ☐ **IMPROVEMENT PERMIT** *with site plan valid for 60 mos.* ☐ **AUTHORIZATION TO CONSTRUCT** *valid for period equal to IMPROVEMENT PERMIT--not to exceed 60 mo.*

Owner / Applicant Signature: Date: 6/2/2015 Installed by: R & H 11/07

IMPROVEMENT PERMIT by: Date:

AUTHORIZATION TO CONSTRUCT by: Date:

OPERATION PERMIT by: Date:

Existing System Inspected by: Date: 6/2/15

Health Dept. Copy - WHITE Applicant (Final Approval) - YELLOW Applicant (Conditional Approval) - PINK