IREDELL COUNTY HEALTH DEPARTMENT

STATESVILLE 704-878-5305 MOORESVILLE 704-664-5281

4639504977

IMPROVEMENT PERMIT / AUTHORIZATION TO CONSTRUCT / OPERATION PERMIT / EXISTING SYSTEM INSPECTION

PERMIT# 12436 PIN# 4639615556.010 DATE 11/4/04

OWNER OR CONTRACTOR HECHT PROPERTIES/MIKE BURNES PHONE: Business 483-3651 Home

ADDRESS 885 (N) HWY 16 DENVER NC 28037

LOCATION PERTH (N) - TL LINA LANE - TR BAY CROSSING - TL SLEEPY COVE - ON LT.

SUBDIVISION BAY CROSSING BLOCK / SECTION LOT 10 LOT AREA .944c SITE CLASS PS DESIGN FLOW 480 GPD L.T.A.R. .36 PD/FT2

Septic Tank: ~~1000~~ 1500 Gallons; STB ~~500~~ 526 Date 3/13/09

Pump Tank: 1000 Gallons; PT #17 Date 3/25/09

Pump Make: Goulds Model WE10J2HH Serial No.

Nitrification Field: No Fields 1 Square Feet 540 Linear Feet 270

No Lines 6@90' Trench Width 24" Max Trench Bottom Depth 36" Gravel Depth N/A

☑ New System ☐ Repair System Type: I, II, III, ⓘV, V, VI

System Description: LP PANEL

Repair System Description: SAME

Maintenance Agreement Required: ☑ Yes ☐ No

☑ House/Mod. Home No. Bedrooms 4

☐ Mobile Home No. Bathrooms 4

☐ Business No. Employees

☐ Other


☐ Slab ☑ Crawl Space ☑ Basement w/plumbing ☐ Basement wo/plumbing

Water Supply: ☐ Individual ☑ Public ☐ Community


Comments/Conditions:

Comments/Conditions: 7/1/09 Tanks Checked by RM
3/16" hole drilled Checked Lines 11/17/09 MS
5/4/10 2ft pressure set, Checked elec. to alarm.

INITIAL SITE SKETCH 1"=50'

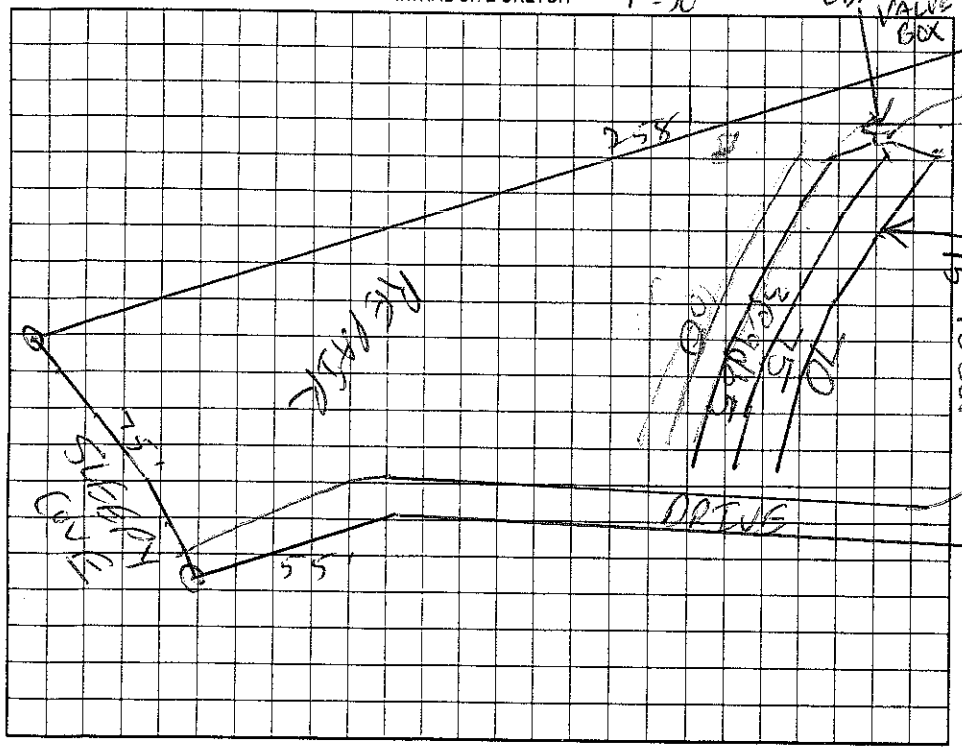

AS BUILT SKETCH

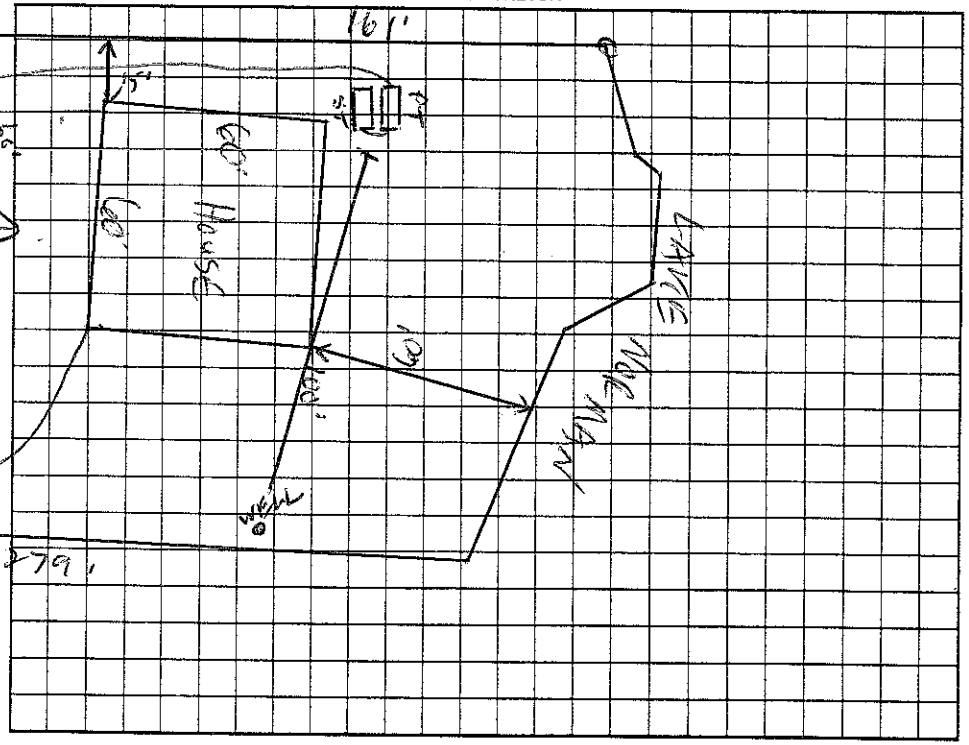

Permit can be suspended or revoked if any false information is supplied toward securing the permit/any unauthorized changes are made to the site/any unauthorized changes are made in the installation of the system. Improvement Permit with plat valid without expiration. Improvement Permit with site plan valid for sixty months. Authorization to Construct is valid for a period equal to that of Improvement Permit – not to exceed sixty months.

Signed: date 11-22-04 Installed by: Hunter Grading

Improvement Permit by: date 11/4/04 Operation Permit by: date 5/5/2010

Authorization to Construct by: Wesley Sparks RS date 6/5/09 Existing System Inspection by: date

HEALTH DEPT. COPY: WHITE OWNER COPY (FINAL): YELLOW OWNER COPY (INITIAL): PINK