IREDELL COUNTY HEALTH DEPARTMENT

STATESVILLE 704-878-5305 MOORESVILLE 704-664-5281

IMPROVEMENT PERMIT / AUTHORIZATION TO CONSTRUCT / OPERATION PERMIT / EXISTING SYSTEM INSPECTION

PERMIT# ~~121433~~ 121434 PIN# 4639615556.009 DATE 11/4/04

OWNER OR CONTRACTOR HECHT PROPERTIES INC / CASTLEVIEW CONSTR PHONE: Business 483-3651 Home

ADDRESS 685 N. HWY 16 DENVER NC 28037

LOCATION PERTH (N) - TL LIVA LN - TR BAYCROSSING - TL SLEEPY COVE - ON LT

SUBDIVISION BAYCROSSING BLOCK / SECTION LOT 8 LOT AREA 1.33AC SITE CLASS. PS DESIGN FLOW 480GPD L.T.A.R. .36AD/FT²

Septic Tank: 1000 Gallons; STB 1012 Date 12/27/04

Pump Tank: Gallons; PT Date

Pump Make: Model Serial No.

Nitrification Field: No Fields 1 Square Feet ~~1200~~ 1000 Linear Feet ~~400~~ 335

No Lines ~~5@167~~ Trench Width 36" Max Trench Bottom Depth 36" Gravel Depth 12"

☒ New System ☐ Repair System Type: I II III IV V VI

System Description: GRAVITY CONVENTIONAL

Repair System Description: GRAVITY 25% REDUCTION

Maintenance Agreement Required: ☐ Yes ☒ No

☒ House/Mod. Home No. Bedrooms 4

☐ Mobile Home No. Bathrooms 4

☐ Business No. Employees

☐ Other


☐ Slab ☒ Crawl Space ☐ Basement w/plumbing ☐ Basement wo/plumbing

Water Supply: ☒ Individual ☐ Public ☐ Community

Comments:/Conditions: 4@100'


Quick 4 Infiltrators Installed

1"=50' INITIAL SITE SKETCH

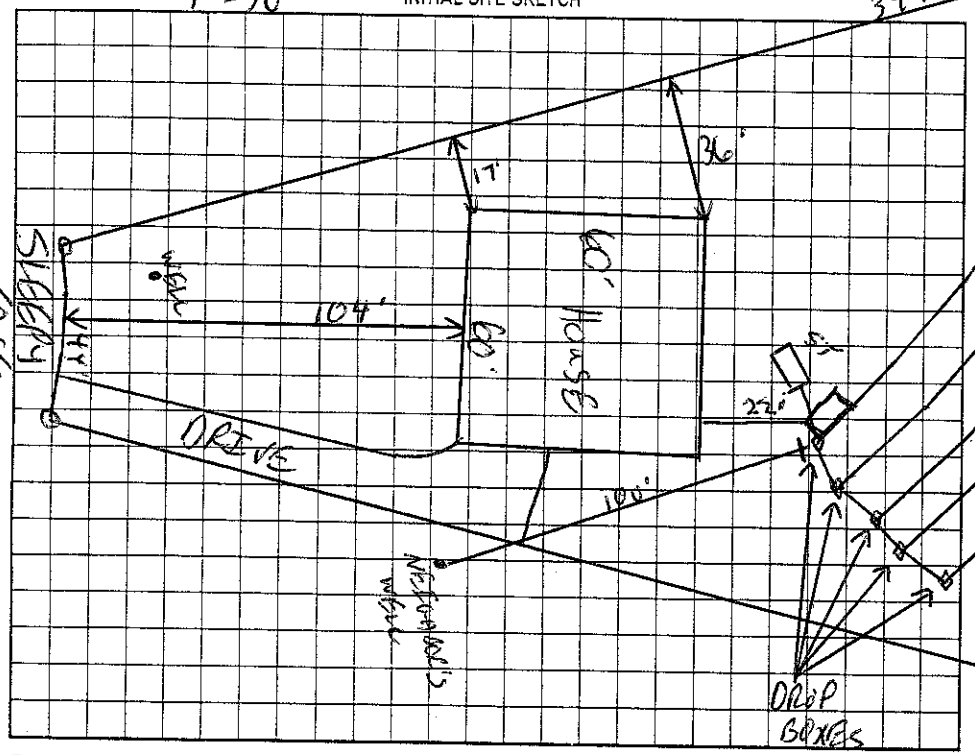

Comments:/Conditions:

AS BUILT SKETCH

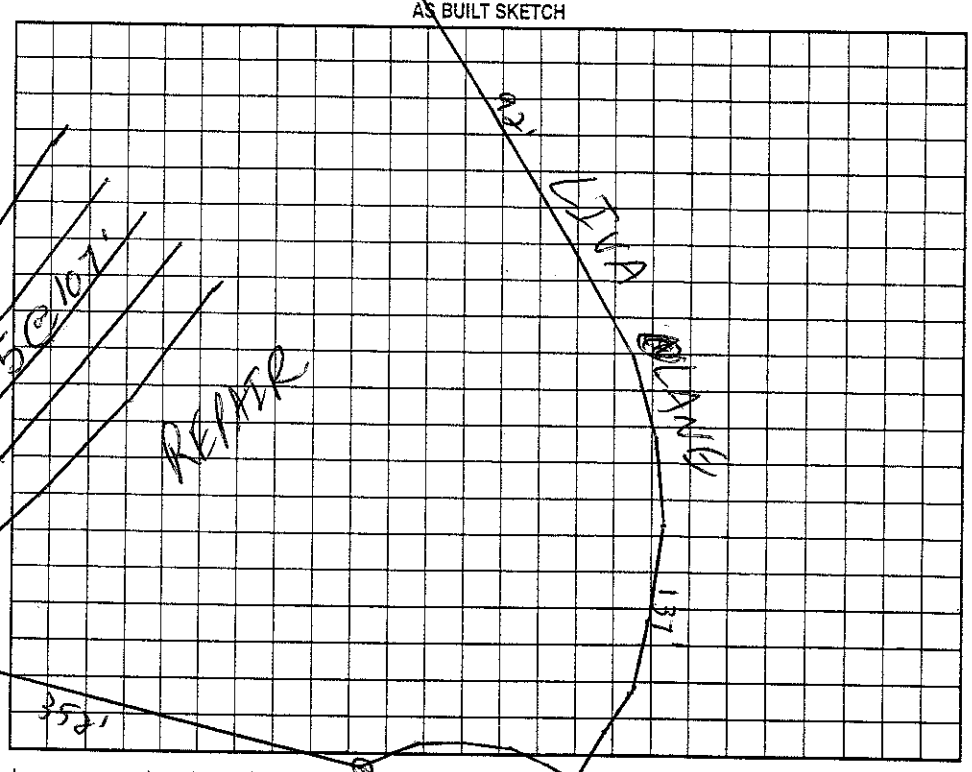

Permit can be suspended or revoked if any false information is supplied toward securing the permit/any unauthorized changes are made to the site/any unauthorized changes are made to the installation of the system. Improvement Permit with plat valid without expiration. Improvement Permit with site plan valid for sixty months. Authorization to Construct is valid for a period equal to that of Improvement Permit – not to exceed sixty months.

Signed: date 11-22-04 Installed by: A-1 Backhoe

Improvement Permit by: RS date 11/4/04 Operation Permit by: RS date 6/29/05

Authorization to Construct by: Wesley Sparks RS. date 1/20/05 Existing System Inspection by: date

HEALTH DEPT. COPY: WHITE OWNER COPY (FINAL): YELLOW OWNER COPY (INITIAL): PINK