IREDELL COUNTY HEALTH DEPARTMENT

STATESVILLE 704-878-5305 MOORESVILLE 704-664-5281

IMPROVEMENT PERMIT / AUTHORIZATION TO CONSTRUCT / OPERATION PERMIT / EXISTING SYSTEM INSPECTION

PERMIT# 121434 PIN# 4639 ~~ST 5556,008~~ 50 5689 DATE 9/27/05

OWNER OR CONTRACTOR Castleview Const. Co. PHONE: Business 895-5502 Home

ADDRESS PO Box 2206 Cornelius, NC. 28031

LOCATION Perth N TL Livaltn. TR Bay Crossing TL Sleepy Cove ln., on L at culde sac.

SUBDIVISION Bay Crossing BLOCK / SECTION LOT 8 LOT AREA ~1.3 SITE CLASS. AC DESIGN FLOW 480 L.T.A.R. .3

Septic Tank: 1500 Gallons; STB ~~1500~~ 338 Date 8/20/05

Pump Tank: Gallons; PT Date

Pump Make: Model Serial No.

Nitrification Field: No Fields 1 Square Feet 1206 Linear Feet 400

No Lines 4@100 Trench Width 3 Max Trench Bottom Depth 3 Gravel Depth No

☒ New System ☐ Repair System Type: I, II, (III) IV, V, VI

System Description: Gravity - 25%

Repair System Description: Same

Maintenance Agreement Required: ☐ Yes ☒ No

☒ House/Mod. Home No. Bedrooms 4

☐ Mobile Home No. Bathrooms 4

☐ Business No. Employees

☐ Other


☐ Slab ☒ Crawl Space ☐ Basement w/plumbing ☐ Basement wo/plumbing

Water Supply: ☒ Individual ☐ Public ☐ Community


Comments:/Conditions:

Comments:/Conditions: I@4W installed as accepted Septem

INITIAL SITE SKETCH

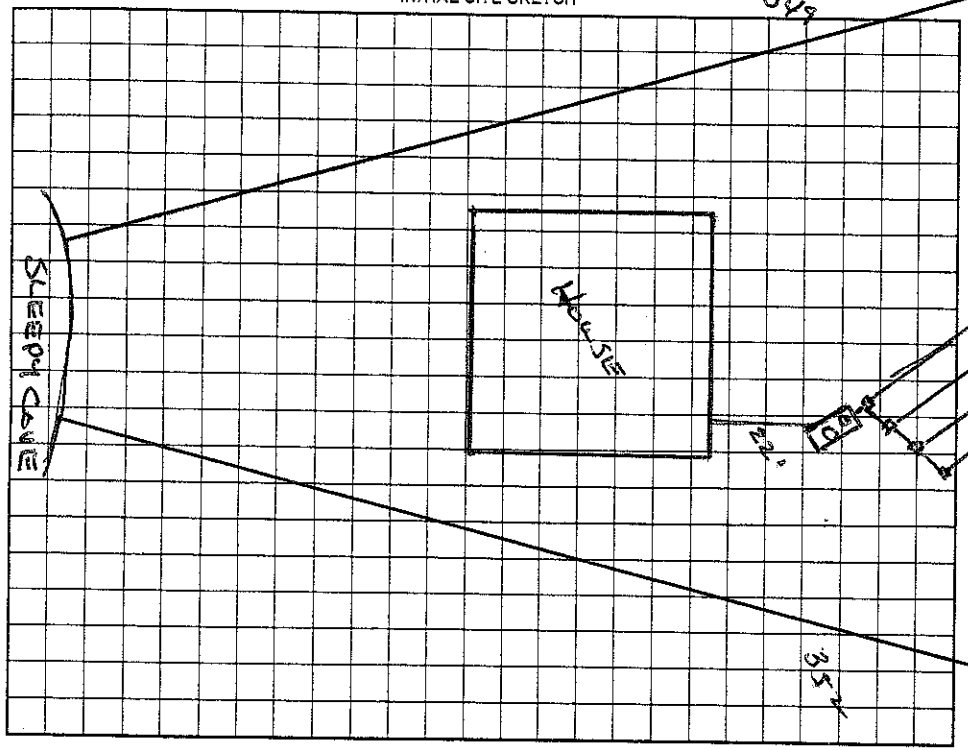

AS-BUILT SKETCH

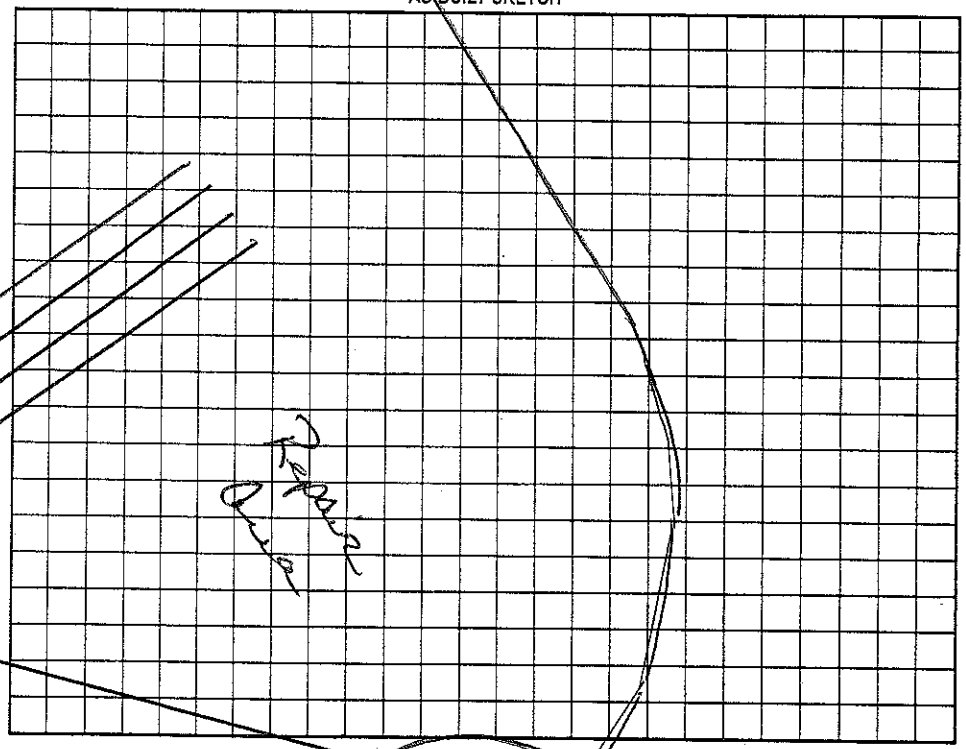

Permit can be suspended or revoked if any false information is supplied toward securing the permit/any unauthorized changes are made to the site/any unauthorized changes are made in the installation of the system. Improvement Permit with plat valid without expiration. Improvement Permit with site plan valid for sixty months. Authorization to Construct is valid for a period equal to that of Improvement Permit – not to exceed sixty months.

Signed: date

Improvement Permit by: CBF date

Authorization to Construct by: AWS date 11/20/05

Installed by: A-1 / Stanley Septic Svcs.

Operation Permit by: GM / Wesley Sparks date 9/27/05

Existing System Inspection by: date

HEALTH DEPT. COPY: WHITE OWNER COPY (FINAL): YELLOW OWNER COPY (INITIAL): PINK