IREDELL COUNTY HEALTH DEPARTMENT

STATESVILLE 704-878-5305 MOORESVILLE 704-664-5281

IMPROVEMENT PERMIT / AUTHORIZATION TO CONSTRUCT / OPERATION PERMIT / EXISTING SYSTEM INSPECTION

PERMIT# 121433 PIN# 4639-61-5556.007 DATE 11/4/04

OWNER OR CONTRACTOR HECHT PROPERTIES / Castleview PHONE: Business 483-3651 Home

ADDRESS 855 N. HWY 16 DENVER NC 28037

LOCATION PERTH (N) - TL LIVA - TR BAYCROSSING - TL SLEEPY COVE - .7+- ON LT

SUBDIVISION BAYCROSSING BLOCK / SECTION LOT 7 LOT AREA .85AC SITE CLASS. PS DESIGN FLOW 480GPD L.T.A.R. .30-80/FT=

Septic Tank: 1000 Gallons; STB 1012 Date 12/27/04
Pump Tank: Gallons; PT Date
Pump Make: Model Serial No.
Nitrification Field: No Fields 1 Square Feet 1200 Linear Feet 400
No Lines 4@100' Trench Width 36" Max Trench Bottom Depth 36" Gravel Depth

☑ New System ☐ Repair System Type: I, II, III, IV, V, VI
System Description: GRAVITY 25% REDUCTION
Repair System Description: SAME
Maintenance Agreement Required: ☐ Yes ☑ No

☑ House/Mod. Home No. Bedrooms 4
☐ Mobile Home No. Bathrooms 4
☐ Business No. Employees
☐ Other


☐ Slab ☑ Crawl Space ☐ Basement w/plumbing ☐ Basement wo/plumbing

Water Supply: ☑ Individual ☐ Public ☐ Community


Comments:/Conditions: Reviewed Building plans & Site plan essentially in Compliance with original permit.

Comments:/Conditions:

INITIAL SITE SKETCH 1"=50'

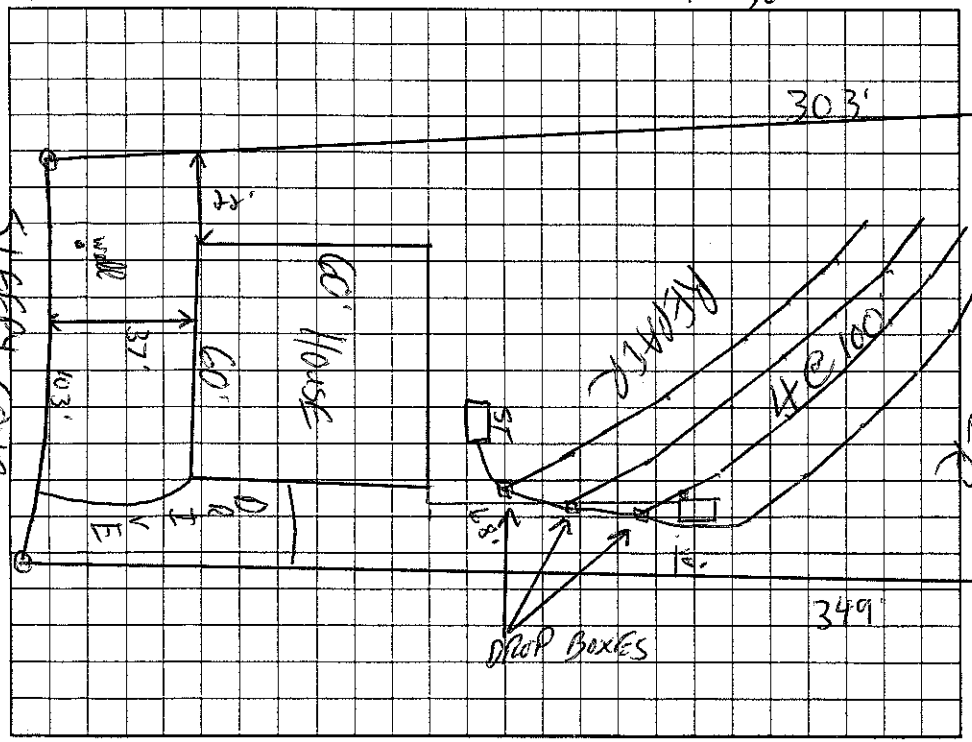

AS BUILT SKETCH

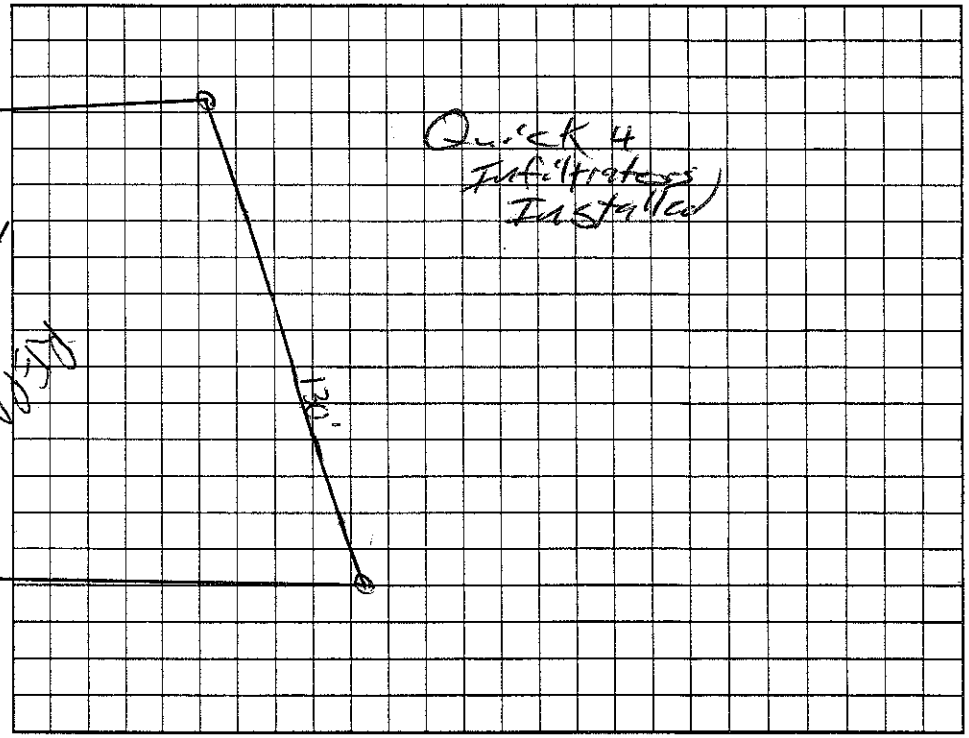

Permit can be suspended or revoked if any false information is supplied toward securing the permit/any unauthorized changes are made to the site/any unauthorized changes are made in the installation of the system. Improvement Permit with plat valid without expiration. Improvement Permit with site plan valid for sixty months. Authorization to Construct is valid for a period equal to that of Improvement Permit – not to exceed sixty months.

Signed: date 11-22-04 Installed by: A-1 Backhoe

Improvement Permit by: date 11/4/04 Operation Permit by: RS date 6/29/05

Authorization to Construct by: RS date 1/20/05 Existing System Inspection by: date

HEALTH DEPT. COPY: WHITE OWNER COPY (FINAL): YELLOW OWNER COPY (INITIAL): PINK