# IREDELL COUNTY HEALTH DEPARTMENT

STATESVILLE 704-878-5305 MOORESVILLE 704-664-5281

## IMPROVEMENT PERMIT / AUTHORIZATION TO CONSTRUCT / OPERATION PERMIT / EXISTING SYSTEM INSPECTION

PERMIT# 121433 PIN# 4639 ~~61 5556 7007~~ 50 7658 DATE 9/23/05

OWNER OR CONTRACTOR Castleview Const. PHONE: Business 895-5502 Home

ADDRESS PO Box 2206 Cornelius, NC. 28031

LOCATION Perth N TL Live TR Boxcrossing TL Sleepy Cove, 7th lot on (L)

SUBDIVISION Boxcrossing BLOCK / SECTION LOT 7 LOT AREA 2.85 SITE CLASS PS DESIGN FLOW 480 L.T.A.R. .3

Septic Tank: 1500 Gallons; STB 338 Date 8/21/05
Pump Tank: Gallons; PT Date
Pump Make: Model Serial No.
Nitrification Field: No Fields 1 Square Feet 1200 Linear Feet 400
No Lines 4@100 Trench Width 3 Max Trench Bottom Depth 3 Gravel Depth No

☒ New System ☐ Repair System Type: I, II, III, IV, V, VI
System Description: Gravity 2590 Reduced
Repair System Description: SAME
Maintenance Agreement Required: ☐ Yes ☒ No


☒ House/Mod. Home No. Bedrooms 4
☐ Mobile Home No. Bathrooms 4
☐ Business No. Employees
☐ Other
☐ Slab ☒ Crawl Space ☐ Basement w/plumbing ☐ Basement wo/plumbing

Water Supply:
☒ Individual
☐ Public
☐ Community


Comments:/Conditions:

Comments:/Conditions: Deck 4 ft off the house not allowed

INITIAL SITE SKETCH

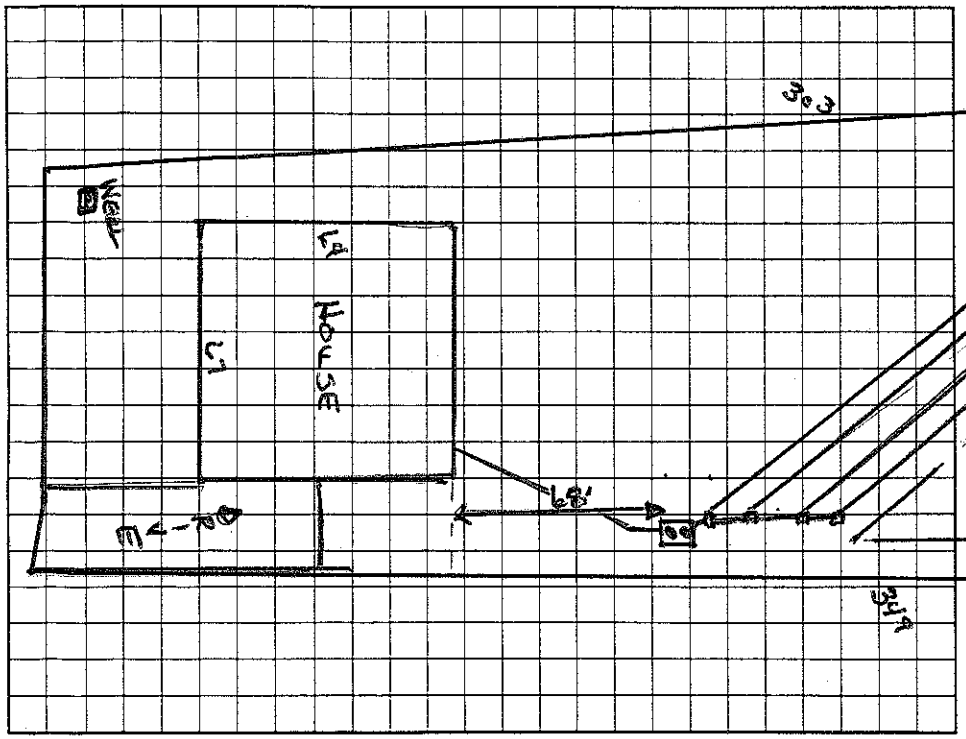


AS BUILT SKETCH

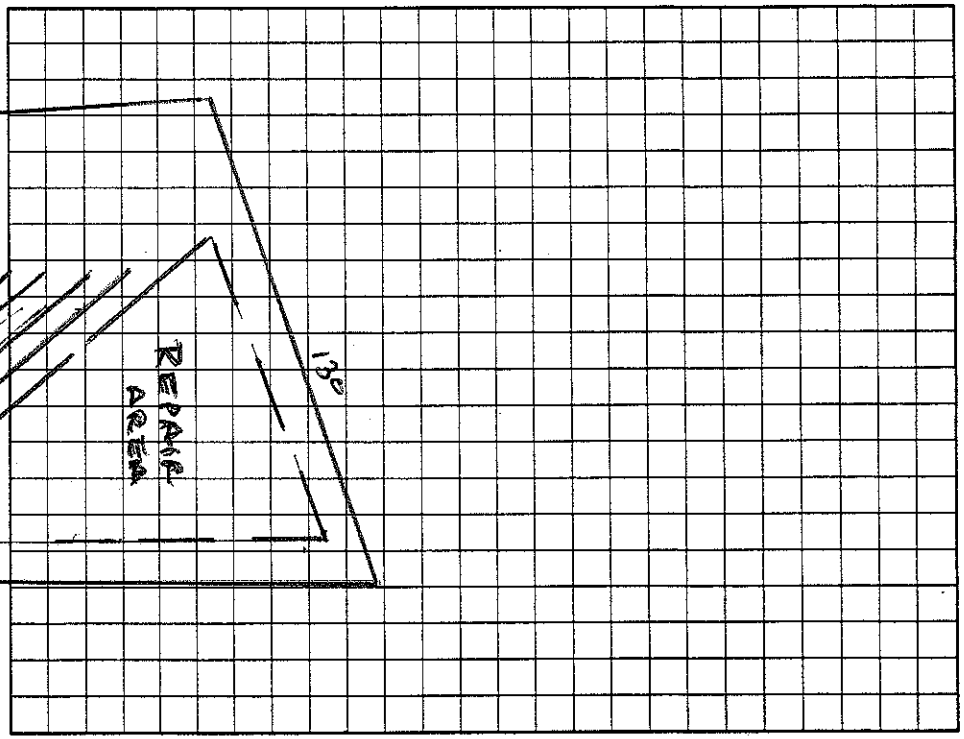


Permit can be suspended or revoked if any false information is supplied toward securing the permit/any unauthorized changes are made to the site/any unauthorized changes are made in the installation of the system. Improvement Permit with plat valid without expiration. Improvement Permit with site plan valid for sixty months. Authorization to Construct is valid for a period equal to that of Improvement Permit – not to exceed sixty months.

Signed: date

Improvement Permit by: CBF date

Authorization to Construct by: MD date

Installed by: A-1 + Sterling Septic Service

Operation Permit by: GM / Wilbur Sparks date 9/23/05

Existing System Inspection by: date

HEALTH DEPT. COPY: WHITE OWNER COPY (FINAL): YELLOW OWNER COPY (INITIAL): PINK