IREDELL COUNTY HEALTH DEPARTMENT

Statesville Office (704) 878-5305 Mooresville Office (704) 660-3625 PERMIT # 206657

IMPROVEMENT PERMIT / AUTHORIZATION TO CONSTRUCT / OPERATION PERMIT / EXISTING SYSTEM

PIN # 4639 50 8282

APPLICANT: Christopher & Brooke Bice APPLICANT ADDRESS: 377 Stumpy Creek Rd Mooresville, NC 28117

SITE ADDRESS: 377 Stumpy Creek Rd Mooresville, NC PHONE: 704 453-1519 ALT. PHONE: Jim 484 467 5668 Mark

SITE DIRECTIONS: Perth Rd N TL Stumpy Creek, Nearend on left

SUBDIVISION: C.L.T SECTION: 14 LOT # 1040 LOT AREA: 1.22 Acre DESIGN FLOW: 360gpd L.T.A.R.: .3

Septic Tank X 1000 (gal)	STB 1012	Date 8/3/14	☒ New System ☐ Repair ☐ Expansion	System Type: I II III IV V VI	☒ Residence	No. Bedrooms 3	Water Supply
Pump Tank 1000 (gal)	PT	Date	System Description: New ST to exist PT 25% Red		☑ Business	No. Persons	☒ Private
Pump Make	Model	Serial #	Repair System Description: 1 P Panel Block		☐ Other	No. Employees	☐ Public
# Nitrification Fields 1	# Lines 5	Linear Ft: 300Ft	Maintenance Agreement Required: ☐ YES ☒ NO		☐ Slab	☐ Crawl Space	☐ Community
Trench Width 36"	Max. Trench Bottom Depth 36"	Gravel Depth N/A	☐ GRAVITY ☒ PRESSURE		☒ Basement w/plumbing	☐ Basement w/o plumbing	


exist

Comments / Conditions: * Must keep Septic System 15ft from proposed pool. Cover / connect to existing PT.


* Relocate ST or install new ST and "properly" abandon Existing ST to meet setback (15ft) to inground Swimming pool.

Scale 1:50

INITIAL SITE SKETCH

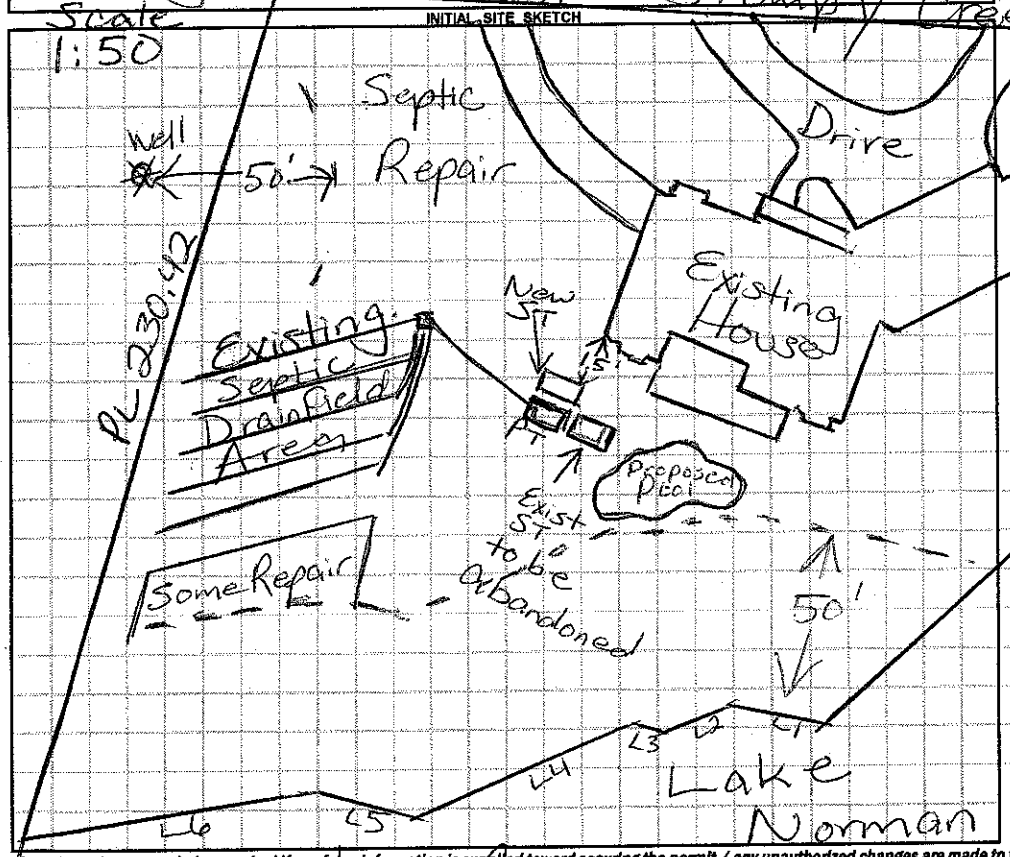

AS BUILT SKETCH

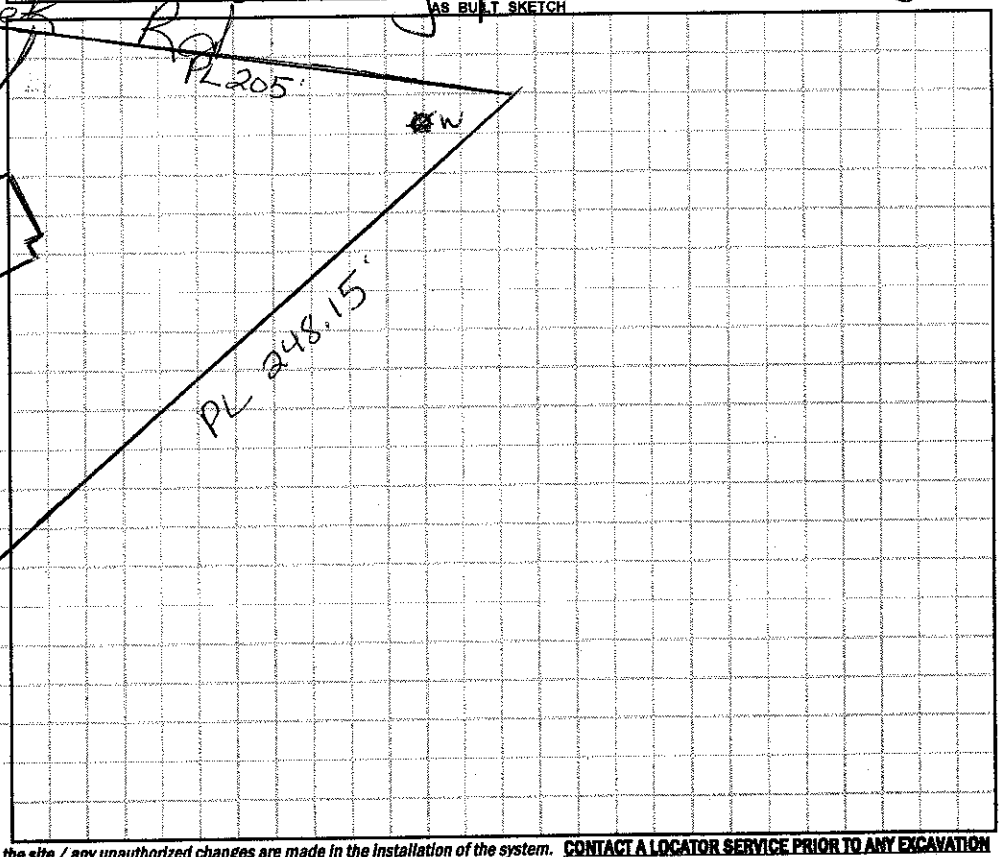

Permit can be suspended or revoked if any false information is supplied toward securing the permit / any unauthorized changes are made to the site / any unauthorized changes are made in the installation of the system. **CONTACT A LOCATOR SERVICE PRIOR TO ANY EXCAVATION**

☐ **IMPROVEMENT PERMIT** *with plat valid without expiration.* ☐ **IMPROVEMENT PERMIT** *with site plan valid for 60 mos.* ☐ **AUTHORIZATION TO CONSTRUCT** *valid for period equal to IMPROVEMENT PERMIT--not to exceed 60 mo.*

Owner / Applicant Signature: Date: 12/16/14 Installed by: Steve Jordan

IMPROVEMENT PERMIT by: Date: 12/17/14 OPERATION PERMIT by: Date: 1/15/15

AUTHORIZATION TO CONSTRUCT by: Date: 12/17/14 Existing System Inspected by: Date:

Health Dept. Copy - WHITE Applicant (Final Approval) - YELLOW Applicant (Conditional Approval) - PINK