IREDELL COUNTY HEALTH DEPARTMENT

STATESVILLE 704-878-5305 50.00 Pd. MOORESVILLE 704-664-5281

IMPROVEMENT PERMIT / AUTHORIZATION TO CONSTRUCT / OPERATION PERMIT / EXISTING SYSTEM INSPECTION

PERMIT# 111542 PIN# 4639-50-8282 DATE 3/14/05

OWNER OR CONTRACTOR Robert Shoemake PHONE: Business 704 201 4267 Home 704 663-3921

ADDRESS 113 Collingswood RD Mooresville NC 28117

LOCATION Perth, TL Stumpy Creek Near End on Lt

SUBDIVISION CL+T BLOCK / SECTION LOT 1040 LOT AREA 1.22AC SITE CLASS PS DESIGN FLOW 360 L.T.A.R. 0.3

Septic Tank: 1000 Gallons; STB 1007 Date 9/16/05
Pump Tank: 1000 Gallons; PT 274 Date 5/20/05
Pump Make: Zoeller Model N152 Serial No.
Nitrification Field: No Fields 1 Square Feet 900 Linear Feet 360'
No Lines 5@60' Trench Width 36" Max Trench Bottom Depth 36" Gravel Depth —

☒ New System ☐ Repair System Type: I, II, III, IV, V, VI
System Description: Press. Man. 2580 Product
Repair System Description: LP Pour/Block
Maintenance Agreement Required: ☐ Yes ☒ No

☒ House/Mod. Home No. Bedrooms 3
☐ Mobile Home No. Bathrooms
☐ Business No. Employees
☐ Other


☐ Slab ☐ Crawl Space ☑ Basement w/plumbing ☐ Basement wo/plumbing

Water Supply: ☒ Individual ☐ Public ☐ Community


Comments:/Conditions:

Comments:/Conditions:

INITIAL SITE SKETCH

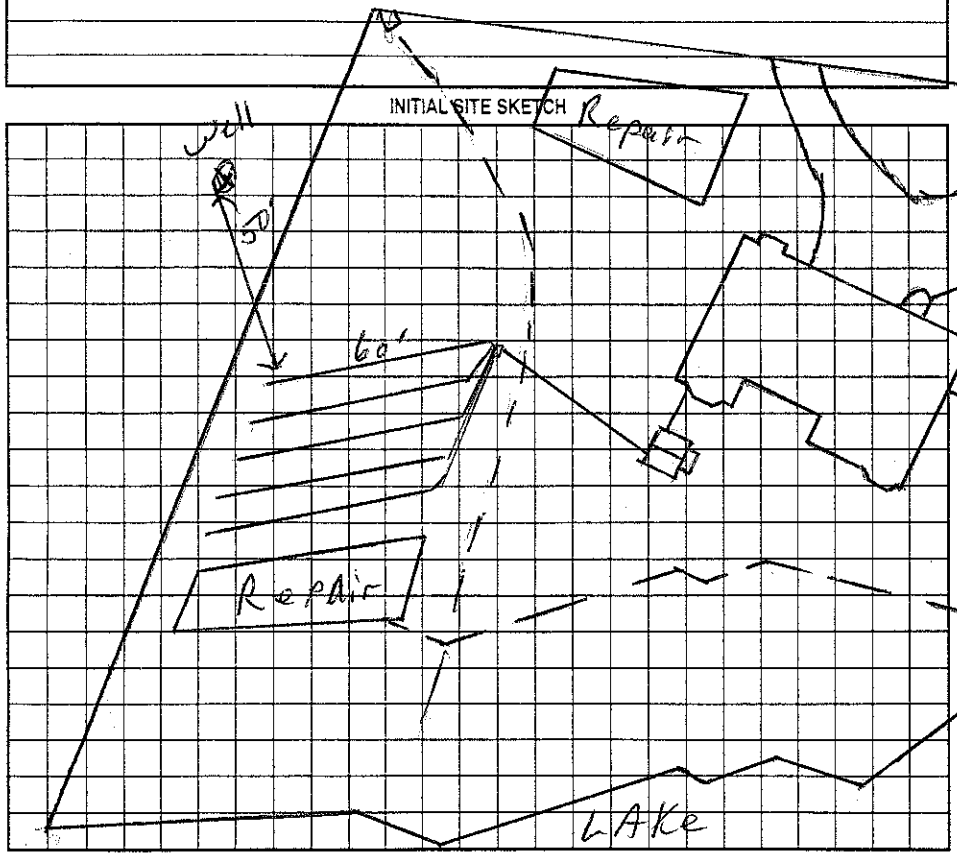

AS BUILT SKETCH

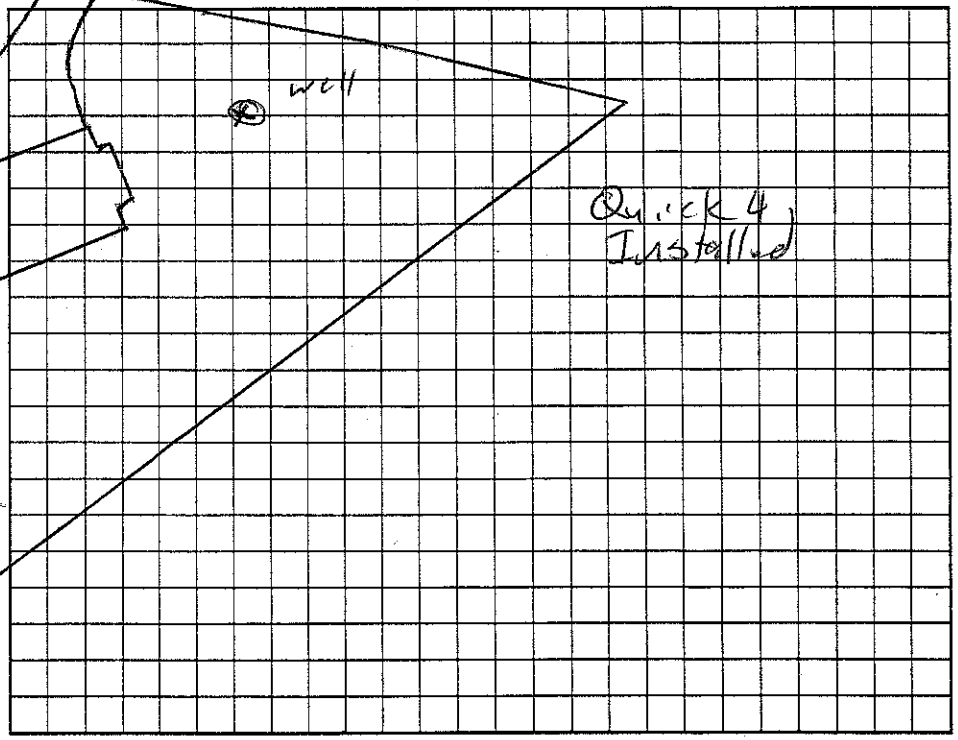

Permit can be suspended or revoked if any false information is supplied toward securing the permit/any unauthorized changes are made to the site/any unauthorized changes are made in the installation of the system. Improvement Permit with plat valid without expiration. Improvement Permit with site plan valid for sixty months. Authorization to Construct is valid for a period equal to that of Improvement Permit – not to exceed sixty months.

Signed: Robert Shoemake date 3-14-05 Installed by: Wayne Clontz

Improvement Permit by: RS date 3/14/05 Operation Permit by: RS date 2/21/06

Authorization to Construct by: RS date 3/14/05 Existing System Inspection by: date

HEALTH DEPT. COPY: WHITE OWNER COPY (FINAL): YELLOW OWNER COPY (INITIAL): PINK