IREDELL COUNTY HEALTH DEPARTMENT

STATESVILLE 704-878-5305 MOORESVILLE 704 64-5281

IMPROVEMENT PERMIT / AUTHORIZATION TO CONSTRUCT / OPERATION PERMIT / EXISTING SYSTEM INSPECTION

PERMIT# 12147 PIN# ~~4639661555 Lot 042~~ 4639515200.000 DATE 11/4/04

OWNER OR CONTRACTOR Hecht Properties/Titan Homes PHONE: Business 483-3651 Home

ADDRESS 885 North Highway 16 Denver, NC 28037

LOCATION Perth Rd South TR Liva Ln - TR BAYCROSSING - TL SLEEPY COVE - SEPTIC ON LT - LOT ON RT

SUBDIVISION Bay Crossing BLOCK / SECTION ph 1 LOT 12 LOT AREA SITE CLASS. PS DESIGN FLOW 480 gpd L.T.A.R. 1256 FO/FT

Septic Tank: 1000 Gallons; STB 282 Date 7/11/05
Pump Tank: 1020 Gallons; PI 40 Date 7/9/05
Pump Make: Zoeller Model E189E Serial No.
Nitrification Field: No Fields 1 Square Feet 1440 Linear Feet 480
No Lines 6@80' Trench Width 36" Max Trench Bottom Depth 60 (24") Gravel Depth N/A

☑ New System ☐ Repair System Type: I, II, III, IV, V, VI
System Description: PUMP 25% REDUCTION
Repair System Description: SAME
Maintenance Agreement Required: ☐ Yes ☐ No

☒ House/Mod. Home No. Bedrooms 4
☐ Mobile Home No. Bathrooms 4
☐ Business No. Employees
☐ Other

Water Supply: ☒ Individual ☐ Public ☐ Community


☐ Slab ☐ Crawl Space ☑ Basement w/plumbing ☐ Basement wo/plumbing

Comments:/Conditions: 1) OFFSITE SEPTIC 2) SEE MASTER PLAT FOR COLOR CODED PUMP SUPPLY LINE LOCATION

The proposed / existing Swimming Pool addition does not appear to impact the existing septic system.
**NOTE: Keep Pool cut at least 15ft from Septic
BEHS
Date: 5/14/2010
ICHD Environmental Health Division

Comments:/Conditions: OFFSITE
Gary & Wesley check lead tanks - lines pressure clear & alarm checked by MJ

AS BUILT SKETCH

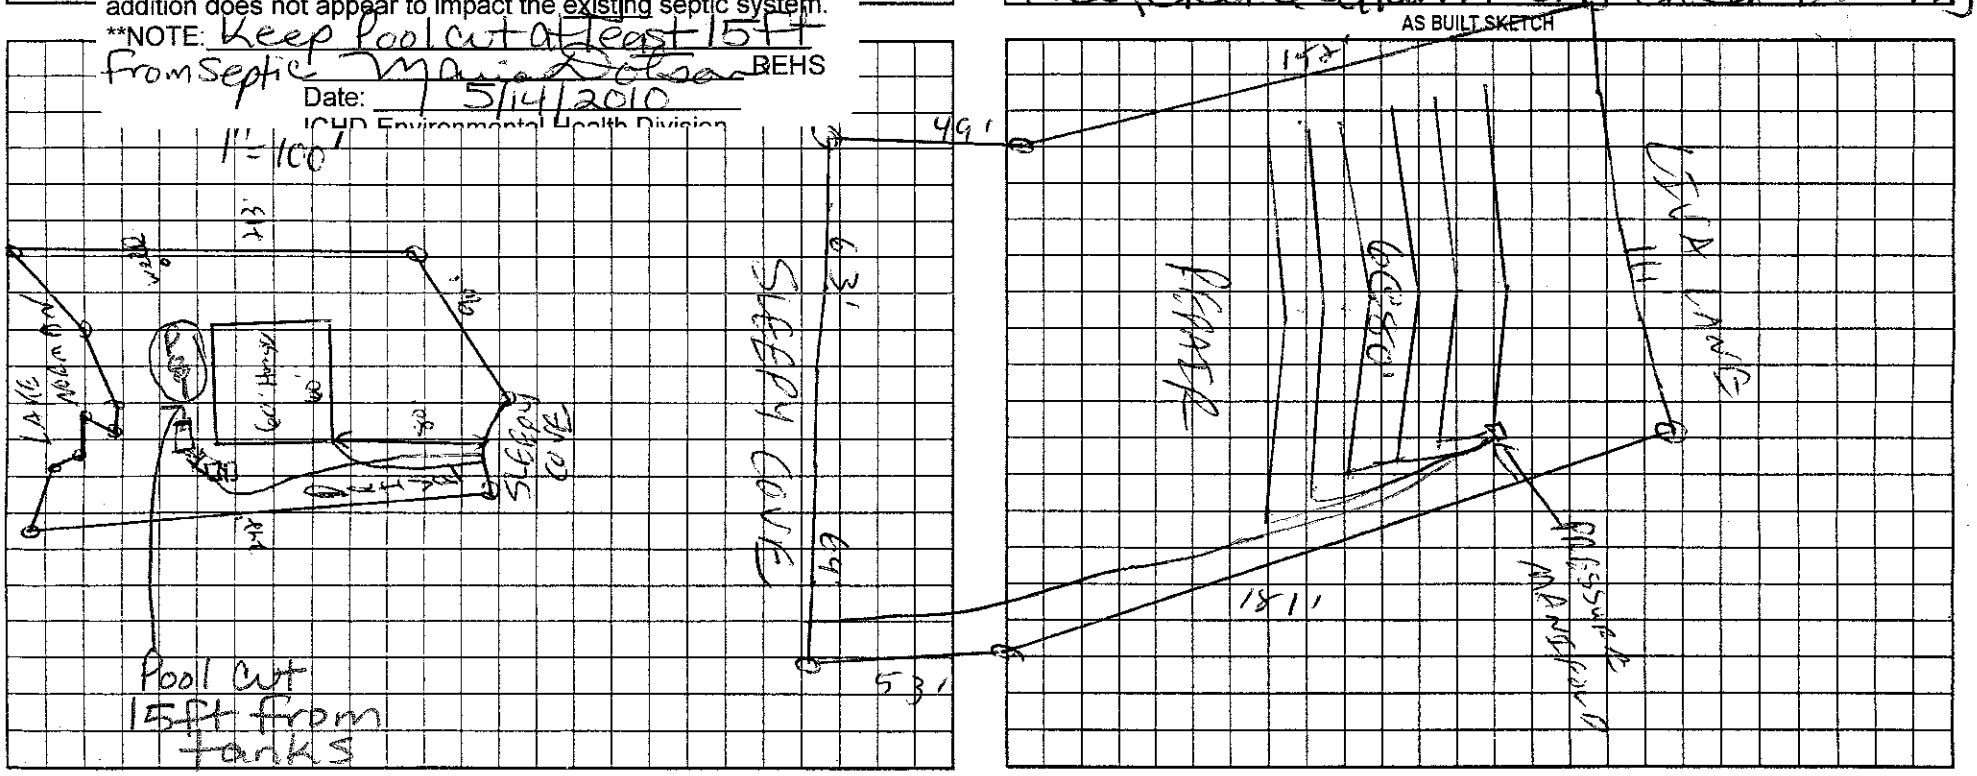

Permit can be suspended or revoked if any false information is supplied toward securing the permit/any unauthorized changes are made to the site/any unauthorized changes are made in the installation of the system. Improvement Permit with plat valid without expiration. Improvement Permit with site plan valid for sixty months. Authorization to Construct is valid for a period equal to that of Improvement Permit – not to exceed sixty months.

Signed: date 11-22-04 Installed by: B+M.

Improvement Permit by: AS date 11/4/04 Operation Permit by: Maria H. Dolan RS date 8/31/05

Authorization to Construct by: Wesley Sparks RS date 2/11/05 Existing System Inspection by: date

HEALTH DEPT. COPY: WHITE OWNER COPY (FINAL): YELLOW OWNER COPY (INITIAL): PINK