IREDELL COUNTY HEALTH DEPARTMENT

STATESVILLE 704-878-5305 MOORESVILLE 704-664-5281

IMPROVEMENT PERMIT / AUTHORIZATION TO CONSTRUCT / OPERATION PERMIT / EXISTING SYSTEM INSPECTION

PERMIT# 12161 PIN# 4639615556.035 4639517943 DATE 11/5/04

OWNER OR CONTRACTOR Hecht Properties PHONE: Business 483-3651 Home

ADDRESS 885 North Highway 16 Denver NC 28037

LOCATION Perth Rd South TR Lava Ln - TR BAYCROSSING - TL BAYSHORE - ON LT

SUBDIVISION Bay Crossing BLOCK / SECTION 1 LOT 35 LOT AREA 1.16AC SITE CLASS PS DESIGN FLOW 450gpd L.T.A.R. .3600/FT =

Septic Tank: 1600 Gallons; STB 338 Date 10-9-05

Pump Tank: 1600 Gallons; PT 283 Date 10-7-05

Pump Make: Gould Model F05E3972L Serial No. WE0712HU

Nitrification Field: No Fields 1 Square Feet 1200 Linear Feet 400

No Lines 5@80' Trench Width 36" Max Trench Bottom Depth 36" Gravel Depth n/a

☒ New System ☐ Repair System Type: I, II, III, IV, V, VI

System Description: PUMP 25% REDUCTION

Repair System Description: SAME

Maintenance Agreement Required: ☐ Yes ☒ No

☒ House/Mod. Home ☐ Mobile Home ☐ Business ☐ Other


No. Bedrooms 4 No. Bathrooms 4 No. Employees

Water Supply: ☒ Individual ☐ Public ☐ Community

☐ Slab ☒ Crawl Space ☒ Basement w/plumbing ☐ Basement wo/plumbing


Comments:/Conditions: SUPPLY LINE TO BE 30" DEEP OR GREATER UNDER DRIVE & sleeve line under drive 11-7-05 Flagged lines & reversed supply line to other side

INITIAL SITE SKETCH

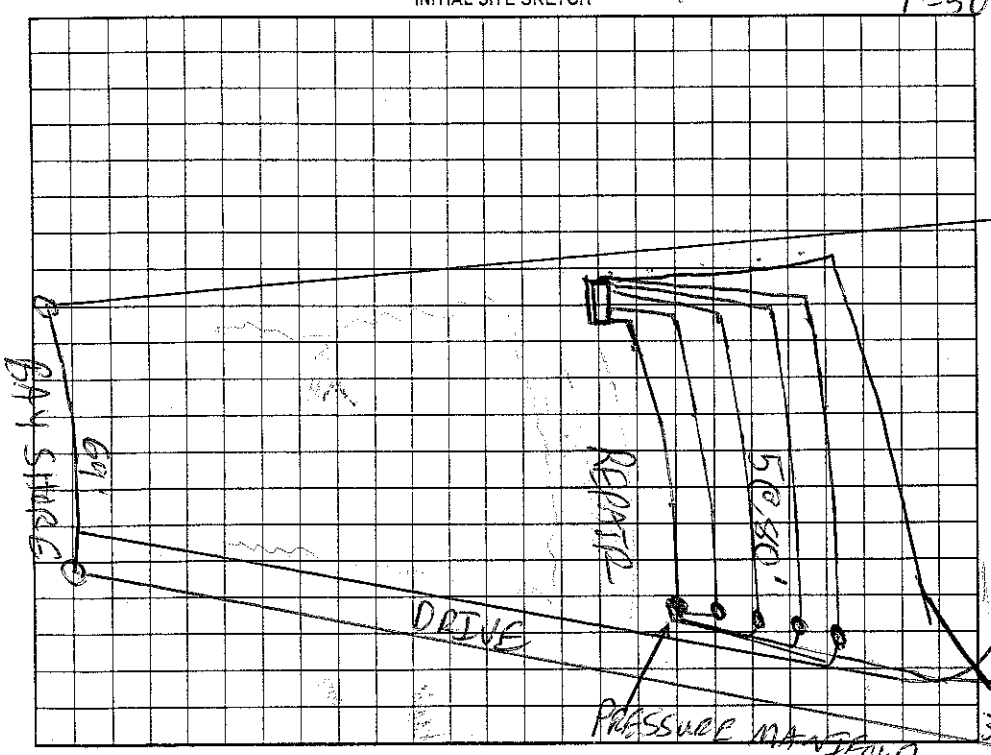

Comments:/Conditions: CRAWL Red Poly lok filter ST w/ marker & risers 3/4 HP pump, pump w/ riser Line Lengths from lower 80, 83, 81, 81, 83

AS BUILT SKETCH

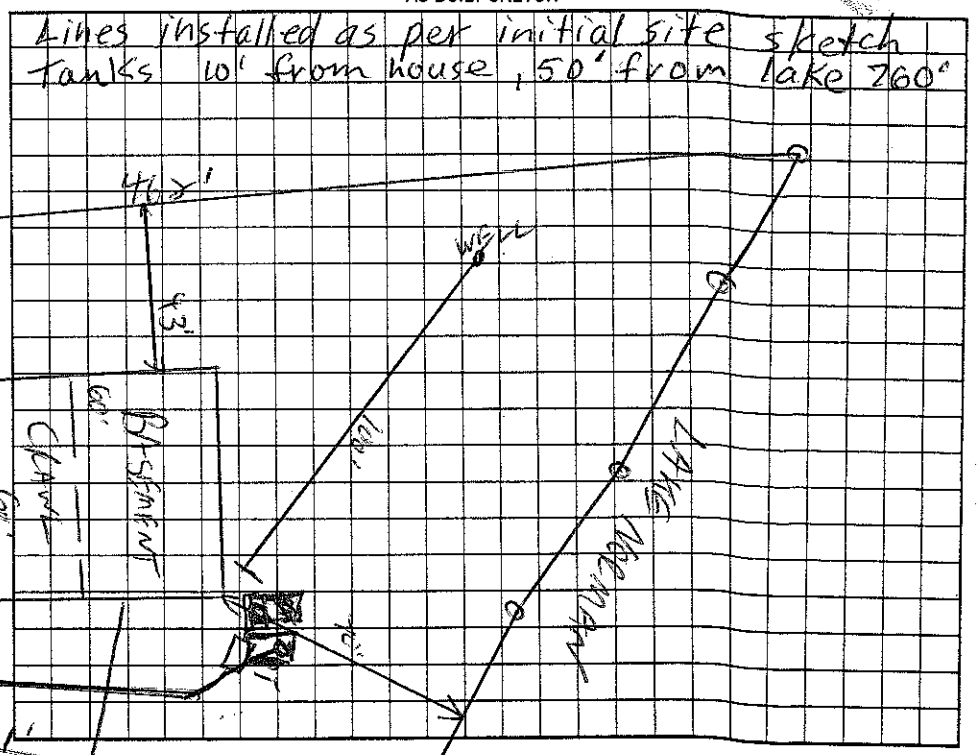

Permit can be suspended or revoked if any false information is supplied toward securing the permit/any unauthorized changes are made to the site/any unauthorized changes are made in the installation of the system. Improvement Permit with plat valid without expiration. Improvement Permit with site plan valid for sixty months. Authorization to Construct is valid for a period equal to that of Improvement Permit – not to exceed sixty months.

Signed: [signature] date 11-22-04 Installed by: Larry Hicks

Improvement Permit by: [signature] RS date 11/5/04 Operation Permit by: Wesley Sparks RS. date 1/5/06

Authorization to Construct by: Wesley Sparks RS. date 1/5/05 Existing System Inspection by: date

HEALTH DEPT. COPY: WHITE OWNER COPY (FINAL): YELLOW OWNER COPY (INITIAL): PINK