IREDELL COUNTY HEALTH DEPARTMENT

STATESVILLE 704-878-5305 MOORESVILLE 704-664-5281

IMPROVEMENT PERMIT / AUTHORIZATION TO CONSTRUCT / OPERATION PERMIT / EXISTING SYSTEM INSPECTION

PERMIT# 12160 PIN# 4639-61-5556 4639-51-8860 DATE 11/5/04

OWNER OR CONTRACTOR Hecht Properties/Becky with Home PHONE: Business (704) 483-3651 Home

ADDRESS 885 North Highway 16 Denver NC 28037

LOCATION Perth Rd South TR Liva Ln - TR BAY CROSSING - TL BAYSIDE - ON LT

SUBDIVISION Bay Crossing BLOCK / SECTION 1 LOT 34 LOT AREA 1.1AC SITE CLASS PS DESIGN FLOW 480gpd L.T.A.R. 1360 FT2

Septic Tank: 1500 ~~1000~~ Gallons; STB 444 Date 3-25-07

Pump Tank: 1000 Gallons; PT 27 Date 3-25-07

Pump Make: Myers Model ME50(5)21 Serial No.

Nitrification Field: (No) Fields 1 Square Feet 1200 Linear Feet 400

No Lines 5@80' Trench Width 36" Max Trench Bottom Depth 36" Gravel Depth NA

☒ New System ☐ Repair System Type: I, II, III, IV, V, VI

System Description: Pump 36% REDUCTION

Repair System Description: LP PUMP

Maintenance Agreement Required: ☐ Yes ☑ No

☒ House/Mod. Home ☐ Mobile Home ☐ Business ☐ Other

No. Bedrooms 4 No. Bathrooms 4 No. Employees

Water Supply: ☒ Individual ☐ Public ☐ Community

☐ Slab ☑ Crawl Space ☐ Basement w/plumbing ~~☐ Basement w/o plumbing~~

Comments:/Conditions: VSC

House will be Crawl space + closer to system. System will need to move uphill approx. 10'


Comments:/Conditions: CRAWL

5/3/07 Checked tanks


5/8/07 Checked lines (EZ Flow)

~~X~~ Must Keep Only Water Line 10ft from Septic System

INITIAL SITE SKETCH 1"=50'

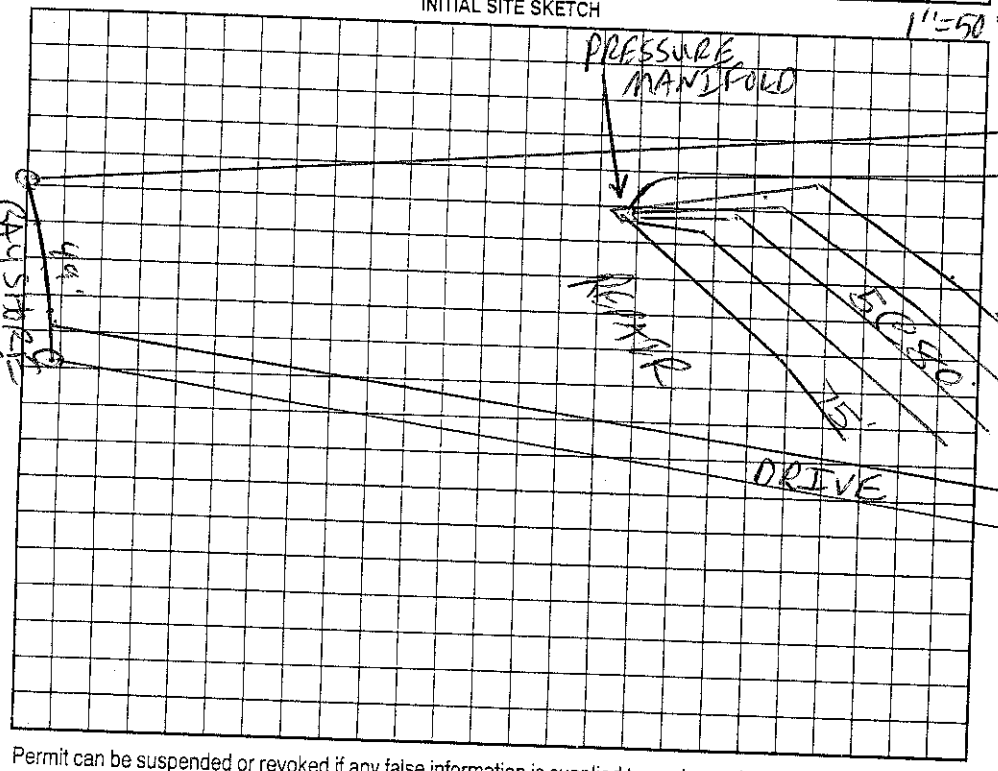

AS BUILT SKETCH

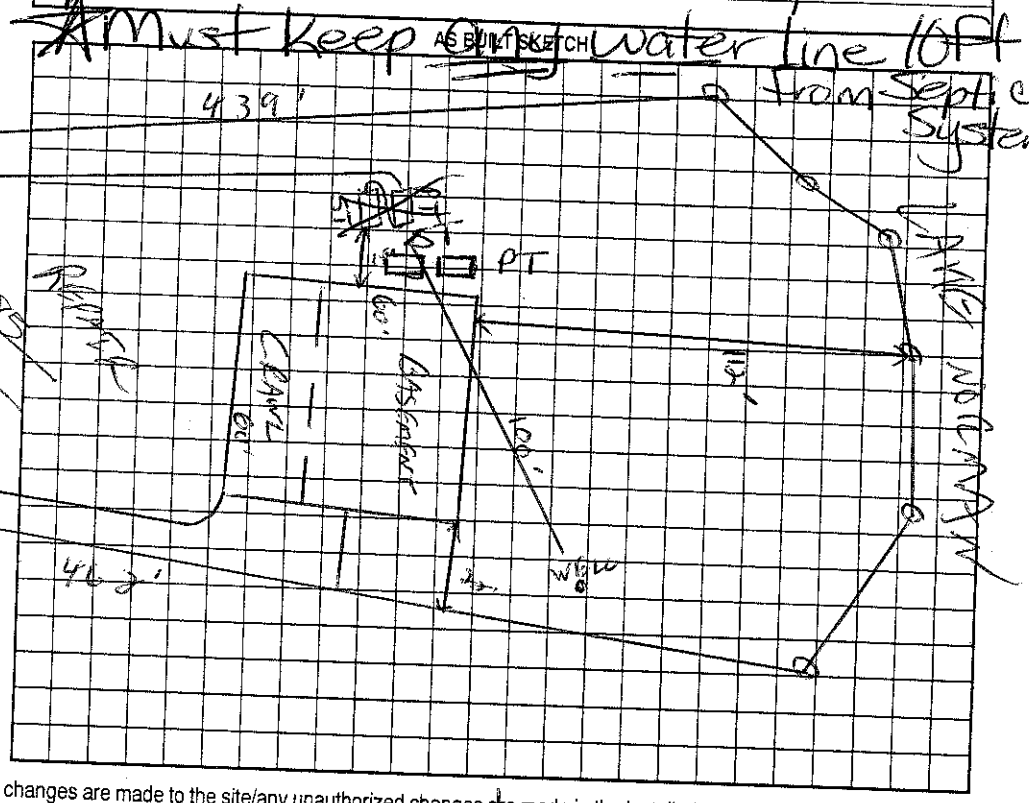

Permit can be suspended or revoked if any false information is supplied toward securing the permit/any unauthorized changes are made to the site/any unauthorized changes are made in the installation of the system. Improvement Permit with plat valid without expiration. Improvement Permit with site plan valid for sixty months. Authorization to Construct is valid for a period equal to that of Improvement Permit – not to exceed sixty months.

Signed: [signature] date 11-22-04 Installed by: [signature]

Improvement Permit by: [signature] date 11/5/04 Operation Permit by: [signature] RS date 5/23/07

Authorization to Construct by: [signature] RS date 5/17/06 Existing System Inspection by: date

HEALTH DEPT. COPY: WHITE OWNER COPY (FINAL): YELLOW OWNER COPY (INITIAL): PINK