IREDELL COUNTY HEALTH DEPARTMEN

STATESVILLE 704-878-5305 MOORESVILLE 704-664-5281

IMPROVEMENT PERMIT / AUTHORIZATION TO CONSTRUCT / OPERATION PERMIT / EXISTING SYSTEM INSPECTION

PERMIT# 121609 PIN# 4639615556.33 4639-51-9734 DATE 11/5/04

OWNER OR CONTRACTOR Hecht Properties PHONE: Business 704 483-3651 Home

ADDRESS 585 North Highway 16 Denver, NC 28037

LOCATION Perth Rd TR Lake Norman - TR BAY CROSSING - TL BAYSHORE - ON LT

SUBDIVISION Bay Crossing BLOCK / SECTION 1 LOT 33 LOT AREA 1.064C SITE CLASS PS DESIGN FLOW 480 gpd L.T.A.R. .3600/FT

Septic Tank: 1500 ~~1000~~ Gallons; STB 330 Date 11-19-07

Pump Tank: 1000 Gallons; PT 33 Date 1-1-08

Pump Make Goulds Model WE0712H 3/4HP Serial No.

Nitrification Field: No Fields 1 Square Feet 540 Linear Feet 270

No Lines 4 Trench Width 24" Max Trench Bottom Depth 36" Gravel Depth #4

☒ New System ☐ Repair System Type: I, II, III, IV, V, VI

System Description: LP PANEL

Repair System Description: SAME

Maintenance Agreement Required: ☑ Yes ☐ No

☒ House/Mod. Home No. Bedrooms 4

☐ Mobile Home No. Bathrooms 4

☐ Business No. Employees

☐ Other


☐ Slab ☑ Crawl Space ☑ Basement w/plumbing ☐ Basement wo/plumbing

Water Supply: ☒ Individual ☐ Public ☐ Community


Comments:/Conditions: 30" DEEP OR MORE UNDER DRIVE WITH SUPPLY LINE

Comments:/Conditions: ~~Trench~~ full basement * Installed 390' lines maintain setbacks from basement

INITIAL SITE SKETCH 1"=50'

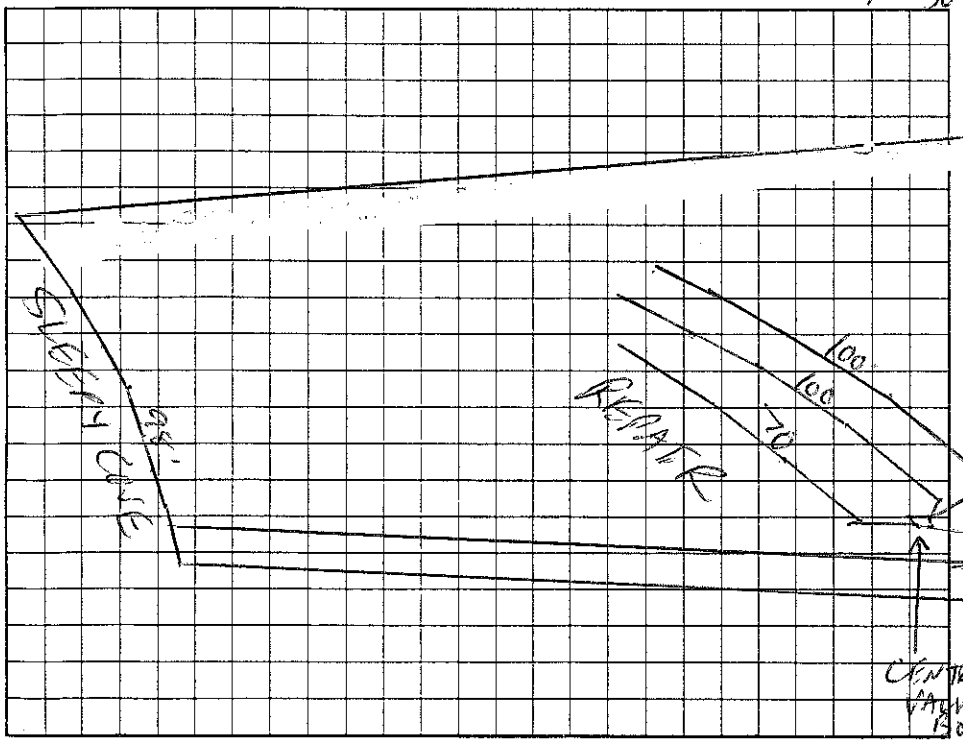

AS BUILT SKETCH

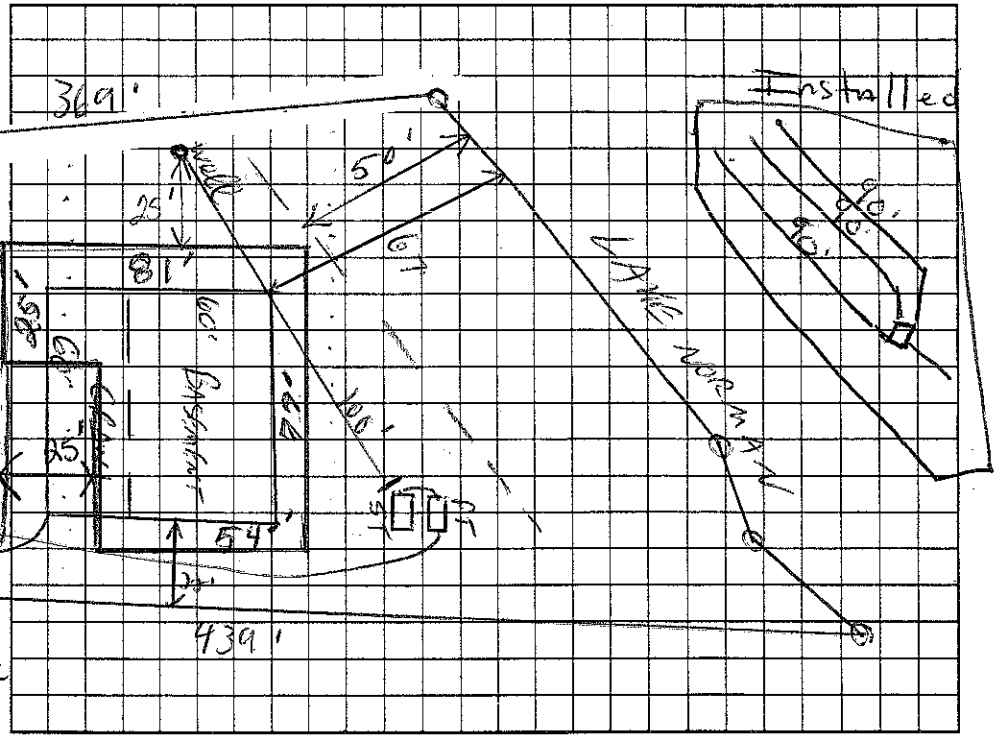

Permit can be suspended or revoked if any false information is supplied toward securing the permit/any unauthorized changes are made to the site/any unauthorized changes are made in the installation of the system. Improvement Permit with plat valid without expiration. Improvement Permit with site plan valid for sixty months. Authorization to Construct is valid for a period equal to that of Improvement Permit – not to exceed sixty months.

Signed: date 11-26-07 Installed by: C & M Enterprising

Improvement Permit by: C. R. S. date 11/5/04 Operation Permit by: Anthony Cole Jr. date 6/2/08

Authorization to Construct by: Mindy Melville date 9-13-07 Existing System Inspection by: date

HEALTH DEPT. COPY: WHITE OWNER COPY (FINAL): YELLOW OWNER COPY (INITIAL): PINK