IREDELL COUNTY HEALTH DEPARTMENT

STATESVILLE 704-878-5305 50.00 Paid MOORESVILLE 704-664-5281 1:30

IMPROVEMENT PERMIT / AUTHORIZATION TO CONSTRUCT / OPERATION PERMIT / EXISTING SYSTEM INSPECTION

PERMIT# 092406 PIN# ~~4639-73-4475~~ 4639521491.000 DATE 4/7/03

OWNER OR CONTRACTOR NICK MILLER PHONE: Business 662-6340 Home

ADDRESS 116 CREEKY HOLLOW DR. MOORESVILLE NC 28117

LOCATION PERTH RD - TL FERNHILL TOWARD LAKE - TL WILDWOOD COVE - TR CREEKY HOLLOW. ON RT AT END

SUBDIVISION WILDWOOD COVE BLOCK / SECTION LOT 23/23A LOT AREA 33020 ft² SITE CLASS. AS DESIGN FLOW 480 gpd L.T.A.R. 3660/F2

Septic Tank: 1000 Gallons; STB 1012 Date * see

Pump Tank: 1000 Gallons; PT 17 Date * Below

Pump Make: Goulds Model WE07124 Serial No. J03L7054

Nitrification Field: No Fields 1 Square Feet 1200 Linear Feet 400

No Lines 7-5 Trench Width 36" Max Trench Bottom Depth 36" Gravel Depth N/A

☑ New System ☐ Repair System Type: I, II, III, IV, V, VI

System Description: PUMP 25% REDUCTION

Repair System Description: LP SAME OFFSITE

Maintenance Agreement Required: ☐ Yes ☑ No 23A

☑ House/Mod. Home No. Bedrooms 7

☐ Mobile Home No. Bathrooms 4

☐ Business No. Employees

☐ Other

☐ Slab ☐ Crawl Space ☑ Basement w/plumbing ☐ Basement wo/plumbing


Water Supply: ☑ Individual ☐ Public ☐ Community

Comments:/Conditions: * Tanks Set When Footings were Dug


1" = 50'

Comments:/Conditions:

INITIAL SITE SKETCH

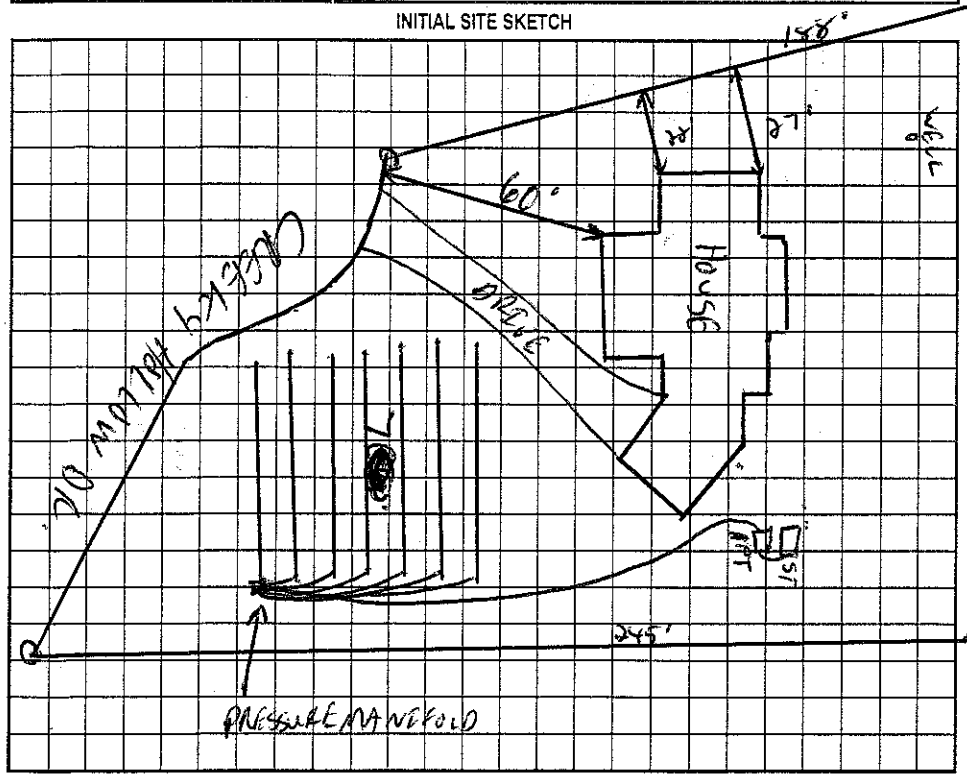

AS BUILT SKETCH

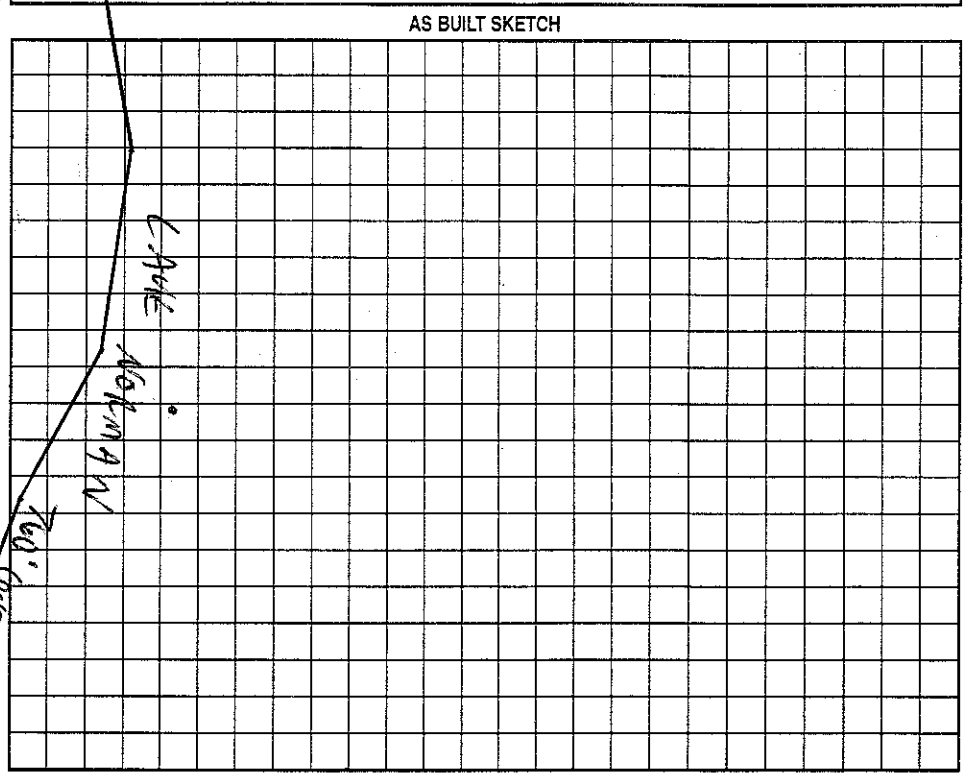

Permit can be suspended or revoked if any false information is supplied toward securing the permit/any unauthorized changes are made to the site/any unauthorized changes are made in the installation of the system. Improvement Permit with plat valid without expiration. Improvement Permit with site plan valid for sixty months. Authorization to Construct is valid for a period equal to that of Improvement Permit – not to exceed sixty months.

Signed: Nick Miller date 4/8/03 Installed by: Tony Fry

Improvement Permit by: C. Sizemore date 4/7/03 Operation Permit by: Wesley Sparks R.S. date 1/20/04

Authorization to Construct by: C. Sizemore date 4/7/03 Existing System Inspection by: date

HEALTH DEPT. COPY: WHITE OWNER COPY (FINAL): YELLOW OWNER COPY (INITIAL): PINK