$1,550

IREDELL COUNTY HEALTH DEPARTMENT

STATESVILLE 704-878-5305 MOORESVILLE 704-664-5281

IMPROVEMENT PERMIT / AUTHORIZATION TO CONSTRUCT / OPERATION PERMIT / EXISTING SYSTEM INSPECTION

PERMIT# 133536 PIN# 4639734475 4639521555 Jim DATE 8-1-06

OWNER OR APPLICANT Kimberly James Homes PHONE: Business 235-1450 ~~Home~~ Blanton 201-0658

ADDRESS 147 Market Place Ave

LOCATION Perth Rd TL Fern Hill TL Wildwood Cove Dr TR Creeky Hollow Rd Lot on Right

SUBDIVISION Wildwood Cove BLOCK / SECTION ____ LOT 24 LOT AREA 34,428 sf SITE CLASS. PS DESIGN FLOW 360gpd L.T.A.R. .3

1/2 HP

Septic Tank: 1000 Gallons; STB 317 Date 4-17-06

Pump Tank: 1000 Gallons; PT 27 Date 5-26-06

Pump Make: Champion Model CPE54-12 Serial No. B12682

Nitrification Field: No Fields 1 Square Feet 900' Linear Feet 300'

No Lines 4@75' Trench Width 36" Max Trench Bottom Depth 36"

☒ New System ☐ Repair ☐ Expansion System Type: I II III IV V VI

System Description: Pump-PM-25% Reduction

Repair System Description: LP-Panel Block

Maintenance Agreement Required: ☐ Yes ☒ No Not Initially

Gravel Depth N/A ☐ Gravity ☒ Pressure

☒ House/Mod. Home ☐ Mobile Home ☐ Business ☐ Other

No. Bedrooms 3 No. Persons ____ No. Employees ____

Water Supply: ☒ Individual ☐ Public ☐ Community

☐ Slab ☐ Crawl Space ☐ Basement w/plumbing ☐ Basement wo/plumbing


Comments/Conditions: Replaces Expired permit, reduced to 3 Bedroom From 4 Bedroom

Comments/Conditions: 8/16/06 Checked tanks & lines

Pressure, elect & alarm Checked 8/29/06

Scale 1" = 50' INITIAL SITE SKETCH

PM = Pressure Manifold

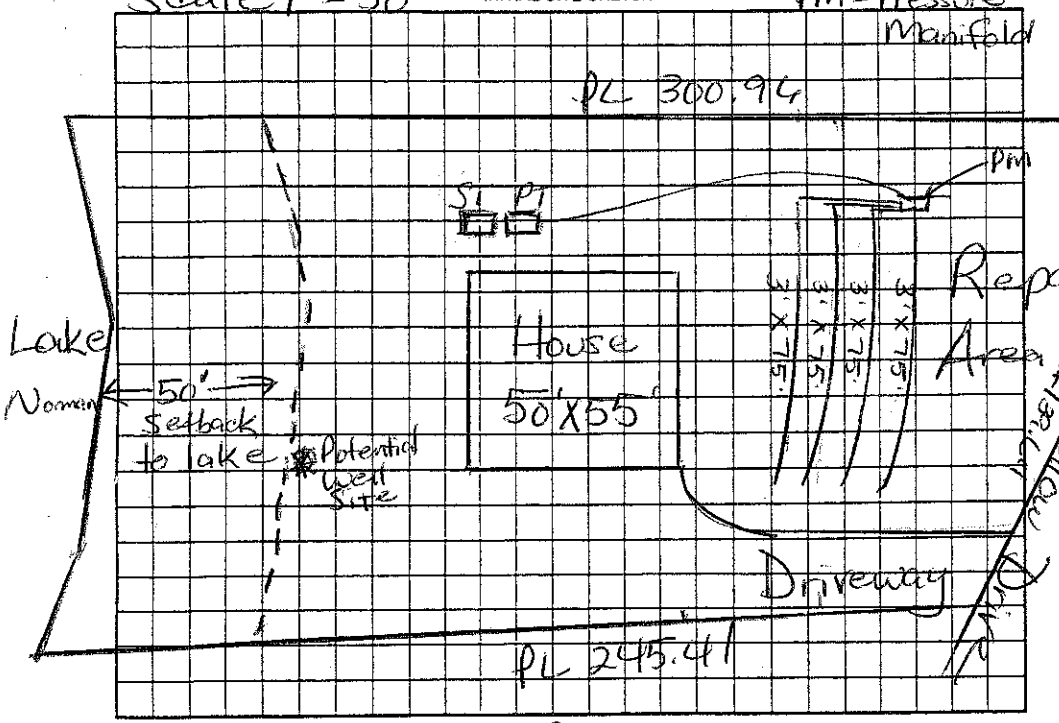

AS BUILT SKETCH 8/29/06

Permit can be suspended or revoked if any false information is supplied toward securing the permit/any unauthorized changes are made to the site/any unauthorized changes are made in the installation of the system. Improvement Permit with plat valid without expiration ☐ Improvement Permit with site plan valid for sixty months ☐

Authorization to Construct is valid for a period equal to that of Improvement Permit – not to exceed sixty months.

Signed [signature] date 8/7/06

Improvement Permit by: Maria H. Dotson RS date 8/2/06

Authorization to Construct by: Maria H. Dotson RS date 8/2/06

Installed by: C.D. Rasemann RS

Operation Permit by: Maria H. Dotson date 8/29/06

Existing System Inspection by: ____ date ____

HEALTH DEPT. COPY: WHITE OWNER COPY (FINAL): YELLOW OWNER COPY (INITIAL): PINK