IREDELL COUNTY HEALTH DEPARTMENT

STATESVILLE 704-878-5305 MOORESVILLE 704-664-5281

IMPROVEMENT PERMIT / AUTHORIZATION TO CONSTRUCT / OPERATION PERMIT / EXISTING SYSTEM INSPECTION

PERMIT# 092403 PIN# 4639 73 4475(pt.) 4639 52 4118 DATE ~~Feb~~ 15,01

OWNER OR CONTRACTOR Crescent Resources Dev. PHONE: Business Home

ADDRESS P.O. Box 1003, Charlotte N.C. 28201

LOCATION Perth Rd. N. TL Fern Hill Rd TL Wildwood Cove TR Creeky Hollow at end 119 Creeky Hollow Dr.

SUBDIVISION Wildwood Cove BLOCK / SECTION LOT 21/21A LOT AREA 43,534 + 14,400 ft² SITE CLASS. RS *SFE DESIGN FLOW 480 gpd L.T.A.R. .03 SFE 21A

Septic Tank: 1000 Gallons; STB 194 Date 11/12/01

Pump Tank: 1000 Gallons; PT 27 Date 11/13/01

Pump Make: Zoeller Model Effl - ~~Sewage~~ No. 2 HP

Nitrification Field: No Fields 1 Square Feet 1200 Linear Feet 400

No Lines 4@100' Trench Width 36" Max Trench Bottom Depth 36" Gravel Depth N/A

☑ New System ☐ Repair System Type: I, II, III, IV, V, VI

System Description: Conv. Innovative 25% Red on 21A

Repair System Description: LPP/BPS on 21A

Maintenance Agreement Required: ☐ Yes ☑ No

☑ House/Mod. Home No. Bedrooms 4

☐ Mobile Home No. Bathrooms 4

☐ Business No. Employees

☐ Other


☐ Slab ☐ Crawl Space ☑ Basement w/plumbing ☐ Basement wo/plumbing

Water Supply: ~~Individual~~ Public ☐ Community


Comments:/Conditions: 11/5/01 Revised house plans essentially complies with Permit criteria. Ars S.

Comments:/Conditions: EZLAY INSTALLED 7/31/02

INITIAL SITE SKETCH

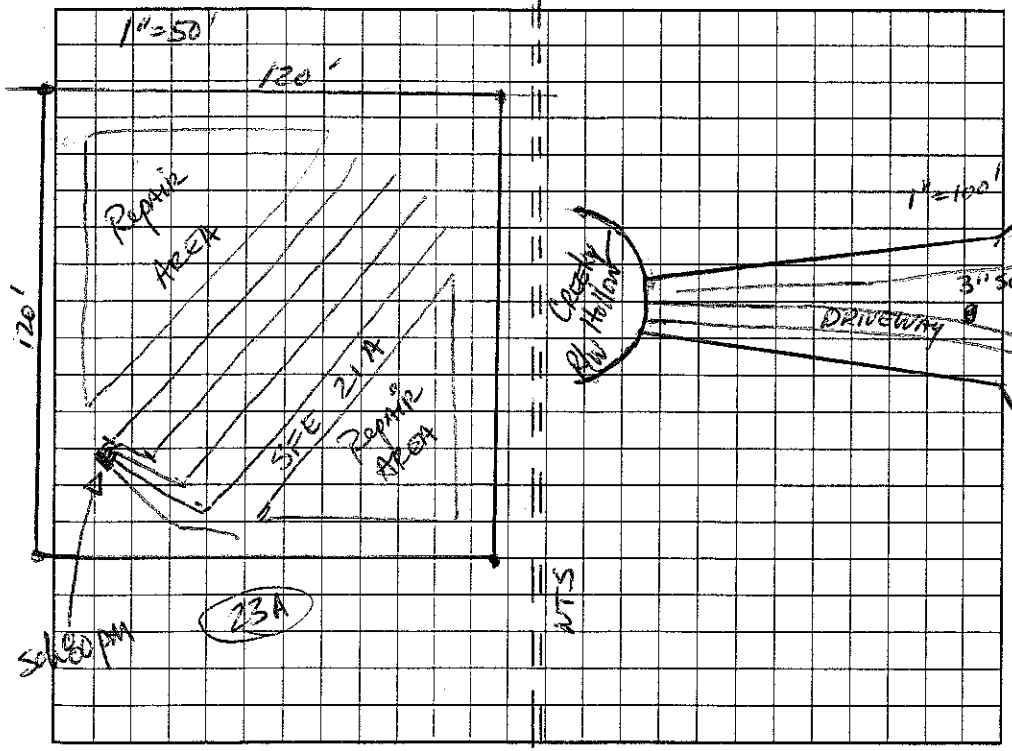

AS BUILT SKETCH

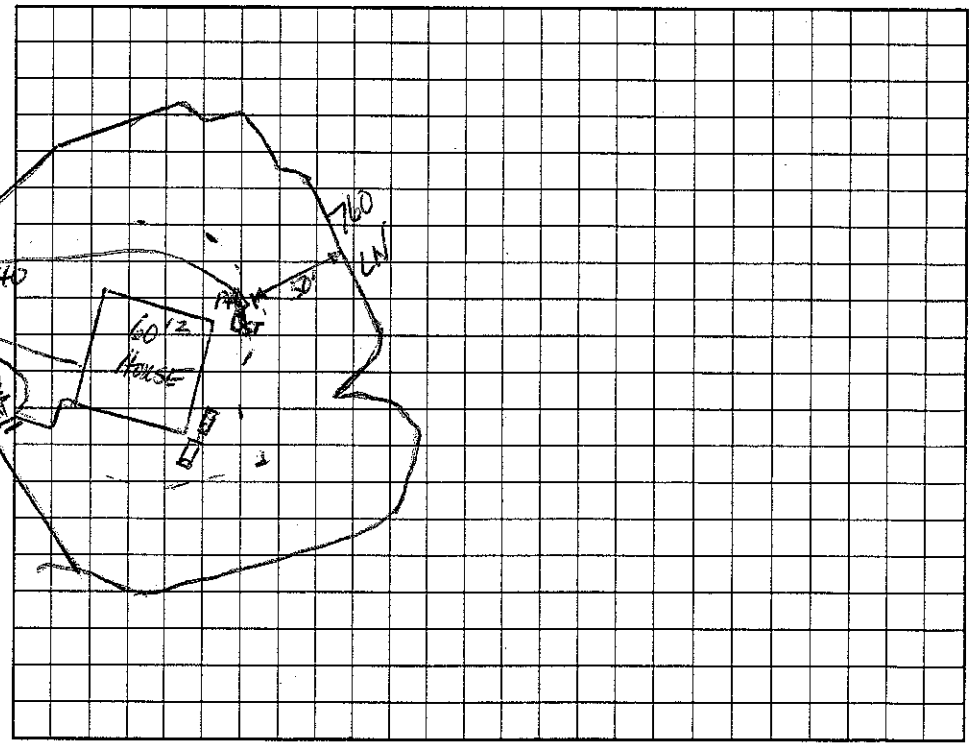

Permit can be suspended or revoked if any false information is supplied toward securing the permit/any unauthorized changes are made to the site/any unauthorized changes are made in the installation of the system. Improvement Permit ~~with plat~~ valid without ~~expiration~~. Improvement Permit with site plan valid for sixty months. Authorization to Construct is valid for a period equal to that of Improvement Permit – not to exceed sixty months.

Signed: date 3-21-01 Installed by: Long Grading Co.

Improvement Permit by: date 2-15-01 Operation Permit by: Wesley Sparks RS. date 8/23/02

Authorization to Construct by: Wesley Sparks RS. date 11/5/01 Existing System Inspection by: date

HEALTH DEPT. COPY: WHITE OWNER COPY (FINAL): YELLOW OWNER COPY (INITIAL): PINK