IREDELL COUNTY HEALTH DEPARTMENT

STATESVILLE 704-878-5305 200.00 Paid MOORESVILLE 704-664-5281

IMPROVEMENT PERMIT / AUTHORIZATION TO CONSTRUCT / OPERATION PERMIT / EXISTING SYSTEM INSPECTION

PERMIT# 092397 PIN# ~~4639-73-4475 pt.~~ 4639-52-5843 DATE 11/15/01

OWNER OR CONTRACTOR J.S. Regal LLC PHONE: Business 704-509-9100 Home

ADDRESS 11145 Metro Mont Pkwy Charlotte NC 28269

LOCATION Perth, TL Fern Hill, TL Wildwood Cove, on Rt before End

SUBDIVISION Wildwood Cove BLOCK / SECTION LOT 16 LOT AREA 31,670 ft² SITE CLASS. AS DESIGN FLOW 600 L.T.A.R. 0.3

Septic Tank: 1500 Gallons; STB 338 Date 3/30/02
Pump Tank: 1500 Gallons; PT 338 Date 3/30/02
Pump Make: Myers Model ME50511 Serial No. 502
Nitrification Field: No. Fields 1 Square Feet 1008 Linear Feet 336'
No Lines 4@84' Trench Width 24" m.n Max Trench Bottom Depth 36" Gravel Depth —

☒ New System ☐ Repair System Type: I, II, III, (IV) V, VI
System Description: LP Panel Block
Repair System Description: Same
Maintenance Agreement Required: ☒ Yes ☐ No

☒ House/Mod. Home ☐ Mobile Home ☐ Business ☐ Other
No. Bedrooms 5 No. Bathrooms 4.5 No. Employees


☐ Slab ☐ Crawl Space ☒ Basement w/plumbing ☐ Basement wo/plumbing

Water Supply: ☒ Individual ☐ Public ☐ Community


Comments:/Conditions: Well needs to go in where it is marked in order to maintain 50' separation from all septic systems
7/24/02 - Will use 5@67R3 - AWS.

Comments:/Conditions: Tanks Checked by W.S
Lines & Pressure Checked 7/26/02 MD
Elect & alarm Checked 8/26/02

INITIAL SITE SKETCH 1"=50'

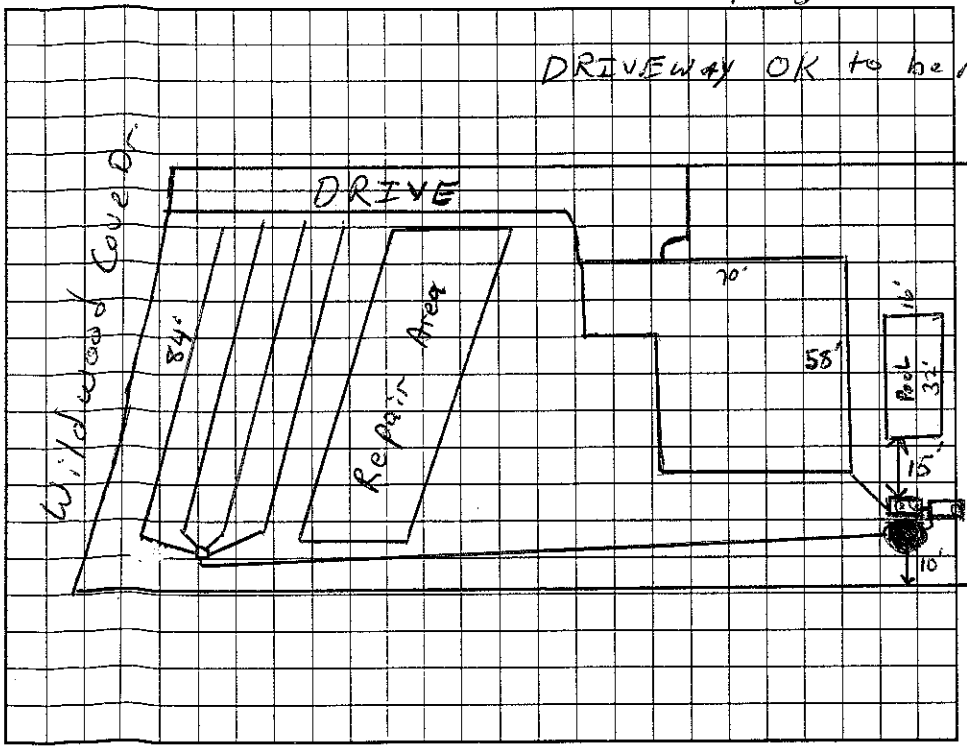

AS BUILT SKETCH

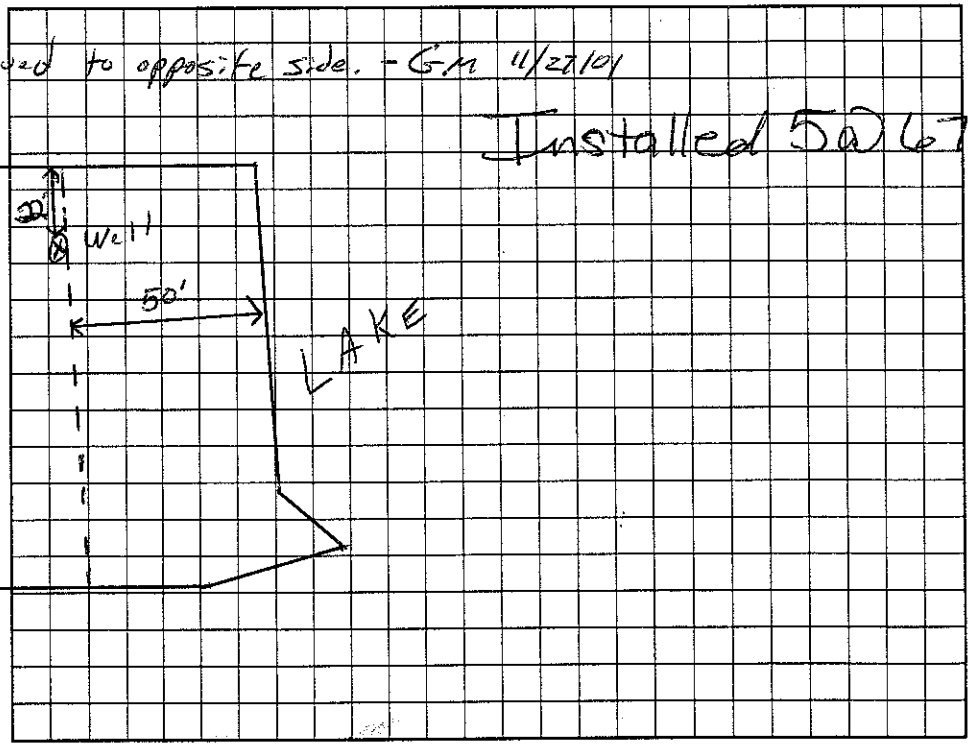

Permit can be suspended or revoked if any false information is supplied toward securing the permit/any unauthorized changes are made to the site/any unauthorized changes are made in the installation of the system. Improvement Permit with plat valid without expiration. Improvement Permit with site plan valid for sixty months. Authorization to Construct is valid for a period equal to that of Improvement Permit – not to exceed sixty months.

Signed: Michael J. Tate date 11/27/01
Improvement Permit by: [signature] LSI date 11/29/01
Authorization to Construct by: [signature] LSI date 11/29/01

Installed by: Dobson & Sons
Operation Permit by: [signature] R.S. date 8/22/2002
Existing System Inspection by: date

HEALTH DEPT. COPY: WHITE OWNER COPY (FINAL): YELLOW OWNER COPY (INITIAL): PINK