IREDELL COUNTY HEALTH DEPARTMENT

STATESVILLE 704-878-5305 MOORESVILLE 704-664-5281

IMPROVEMENT PERMIT / AUTHORIZATION TO CONSTRUCT / OPERATION PERMIT / EXISTING SYSTEM INSPECTION

PERMIT# 121612 PIN# 4639 61 5556.036 4639-52-7095 DATE 1/2/07

OWNER OR APPLICANT Dream Works PHONE: Business 704-202-7376 Home

ADDRESS 516 River Hwy. Suite D # 135

LOCATION 145 Bay Shore Loop. Mooresville, NC. 28117

SUBDIVISION Bay Cruising BLOCK / SECTION 1 LOT 36 LOT AREA .97 Ac SITE CLASS. PS DESIGN FLOW 480 L.T.A.R. .3

Septic Tank: 1500 Gallons; STB 528 Date 5/4/06

Pump Tank: 1000 Gallons; PT 17 Date 6/12/06

Pump Make: Gould's Model WE0 1012 Serial No.

Nitrification Field: No Fields 1 Square Feet 855 Linear Feet 285

No Lines 5@57' Trench Width 3 Max Trench Bottom Depth 3' Gravel Depth No

☒ New System ☐ Repair ☐ Expansion System Type: I II III IV V VI

System Description: Pressured - 16" PPBPS

Repair System Description: SAME

Maintenance Agreement Required: ☒ Yes ☐ No

☒ House/Mod. Home ☐ Mobile Home ☐ Business ☐ Other

No. Bedrooms 4 No. Persons No. Employees


Water Supply: ☐ Individual ☐ Public ☒ Community

☐ Gravity ☒ Pressure ☐ Slab ☐ Crawl Space ☒ Basement w/plumbing ☐ Basement wo/plumbing


Comments:/Conditions:

Comments:/Conditions: 16" PPBPS Type 4 Absorption
5@57'x3'
2' PH

INITIAL SITE SKETCH

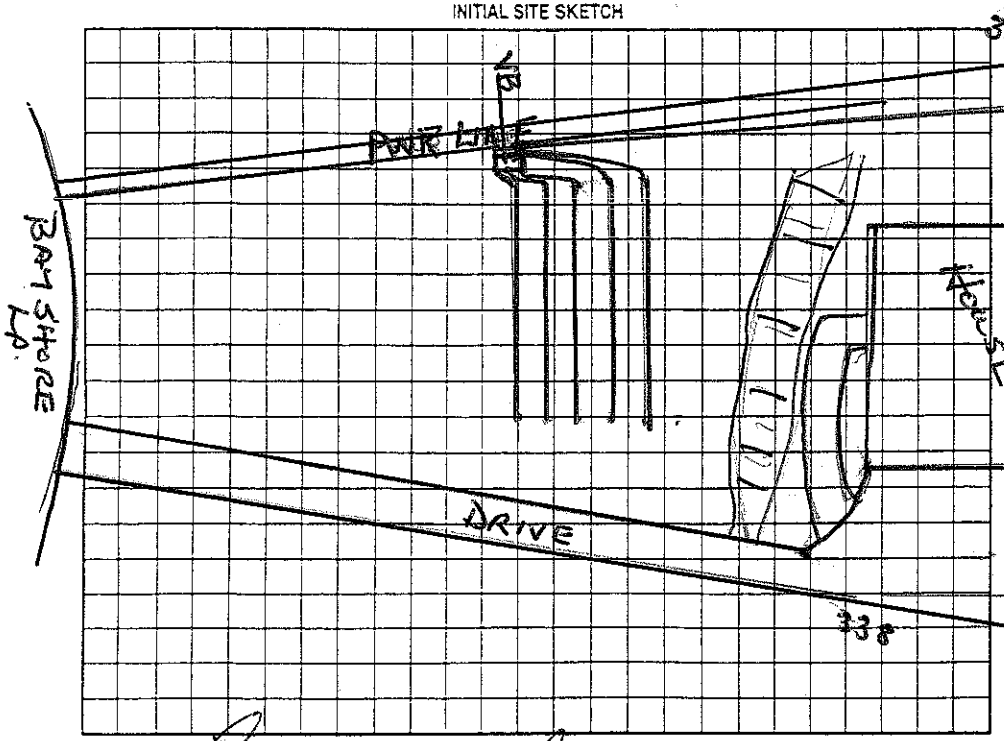

AS BUILT SKETCH

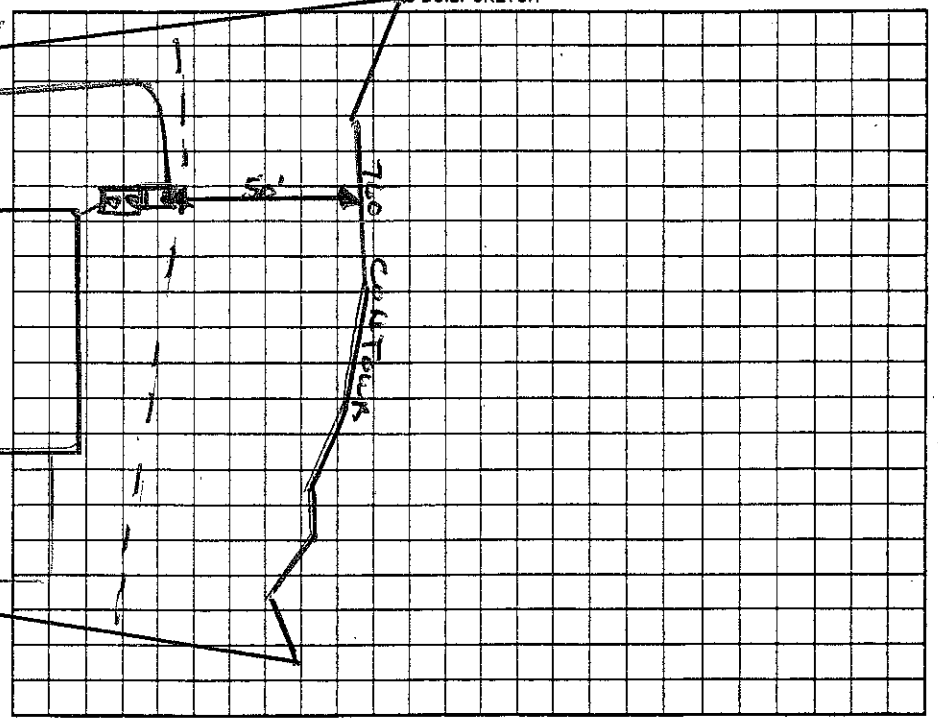

Permit can be suspended or revoked if any false information is supplied toward securing the permit/any unauthorized changes are made to the site/any unauthorized changes are made in the installation of the system. Improvement Permit with plan valid without expiration ☐ Improvement Permit with site plan valid for sixty months ☐ Authorization to Construct is valid for a period equal to that of Improvement Permit – not to exceed sixty months.

Signed Sondra Hall date 1-5-07 Installed by: Piedmont Backhoe

Improvement Permit by: date

Authorization to Construct by: date

Operation Permit by: Wesley Sparkers date 1/2/07

Existing System Inspection by: date

HEALTH DEPT. COPY: WHITE OWNER COPY (FINAL): YELLOW OWNER COPY (INITIAL): PINK

IREDELL COUNTY HEALTH DEPARTMENT

STATESVILLE 704-878-5305 MOORESVILLE 704-664-5281

IMPROVEMENT PERMIT / AUTHORIZATION TO CONSTRUCT / OPERATION PERMIT / EXISTING SYSTEM INSPECTION

PERMIT# 12612 PIN# 4639615556.036 DATE 11/5/04

OWNER OR CONTRACTOR Hecht Properties, Inc / Dreamwood PHONE: Business 483-3651 Home

ADDRESS 885 North Highway 16 Denver, NC 28037

LOCATION Perth Rd South TR, Liva Ln - TR BAY CROSSING - TL BAYSHORE - ON LT

SUBDIVISION Bay Crossing BLOCK / SECTION 1 LOT 36 LOT AREA .97AC SITE CLASS. PS DESIGN FLOW 480gpd L.T.A.R. .3660/FT ±

Septic Tank: ~~1500~~ ~~1000~~ Gallons; STB 528 Date 5/4/04

Pump Tank: 1000 Gallons; PT 17 Date 11/12/04

Pump Make: Ecovos Model WE0.5H22S5 Serial No. 285

Nitrification Field: No Fields 1 Square Feet ~~1000~~ Linear Feet ~~400~~

No Lines ~~5@50'~~ Trench Width 36" Max Trench Bottom Depth 36" Gravel Depth

☒ New System ☐ Repair System Type: I, II, ~~III~~ IV, V, VI

System Description: ~~Pump 250 gal tank~~

Repair System Description: SAME

Maintenance Agreement Required: ☐ Yes ☒ No

☒ House/Mod. Home ☐ Mobile Home ☐ Business ☐ Other

No. Bedrooms 4 No. Bathrooms 4 No. Employees

☐ Slab ☒ Crawl Space ☒ Basement w/plumbing ☐ Basement wo/plumbing

Water Supply: ☒ Individual ☐ Public ☐ Community

Comments:/Conditions:

Well for Lot 36 is 52' from tanks on Lot 37

Comments:/Conditions:


~~PACTANK~~ 1000 gal 1 1/2" NPBPS Type 4 installed

Lot 34 23


5@57' x 3'

2+' PM

INITIAL SITE SKETCH 1"=50'

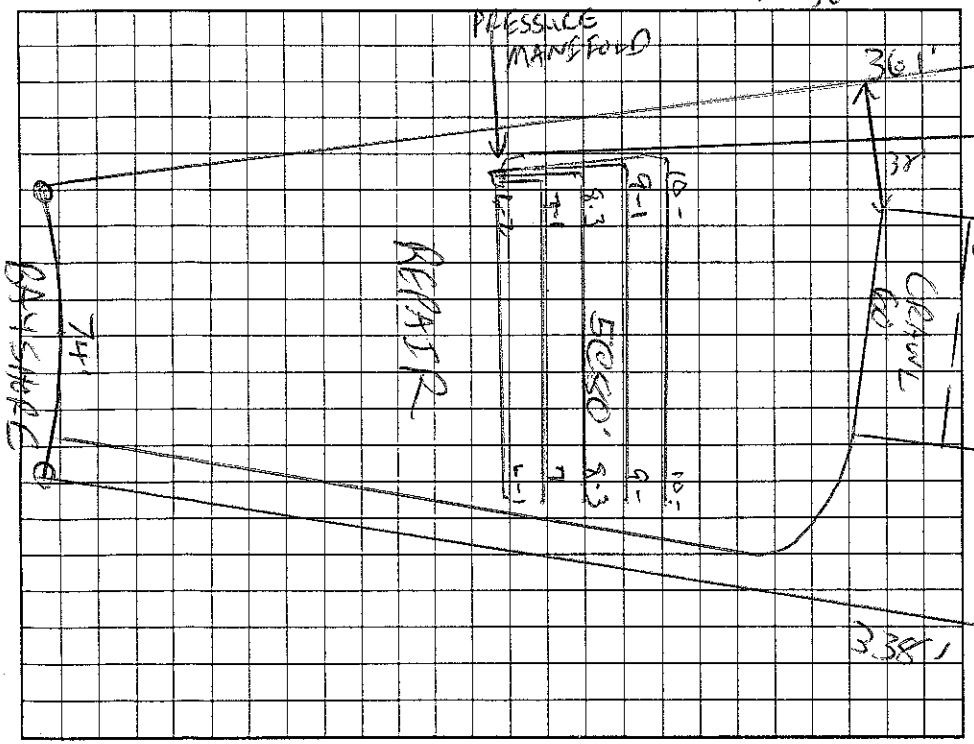

AS BUILT SKETCH

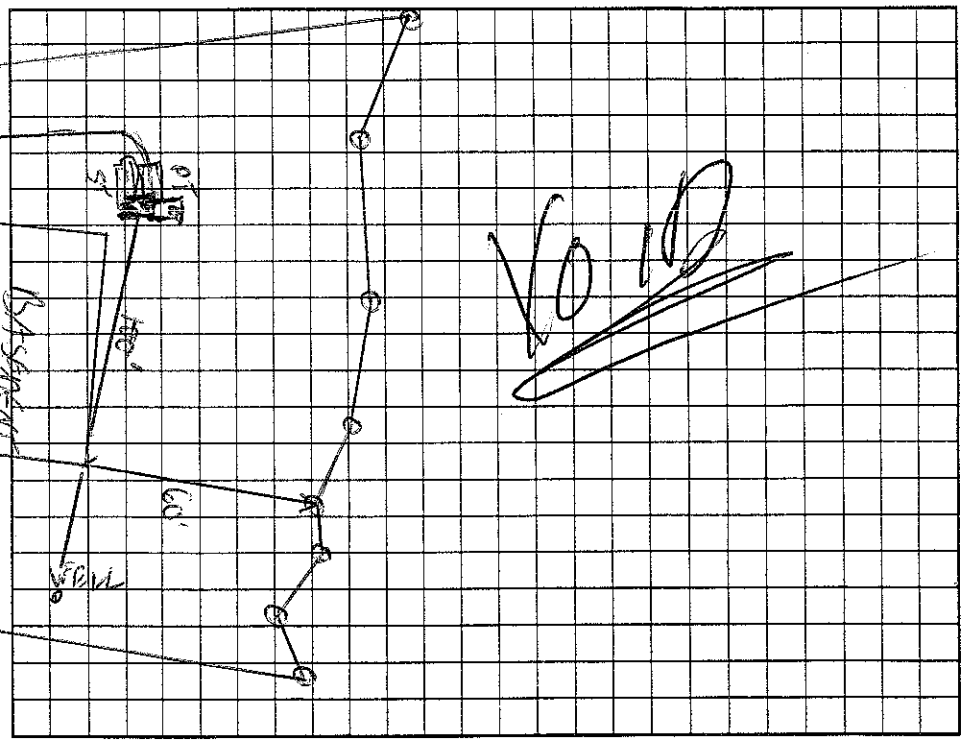

Permit can be suspended or revoked if any false information is supplied toward securing the permit/any unauthorized changes are made to the site/any unauthorized changes are made in the installation of the system. Improvement Permit with plat valid without expiration. Improvement Permit with site plan valid for sixty months. Authorization to Construct is valid for a period equal to that of Improvement Permit – not to exceed sixty months.

Signed: 11-22-04 date 11-22-04 Installed by: Piedmont Backhoe

Improvement Permit by: date 11/5/04 Operation Permit by: date

Authorization to Construct by: RS date 4/13/05 Existing System Inspection by: date

HEALTH DEPT. COPY: WHITE OWNER COPY (FINAL): YELLOW OWNER COPY (INITIAL): PINK