
Windmere F-4125

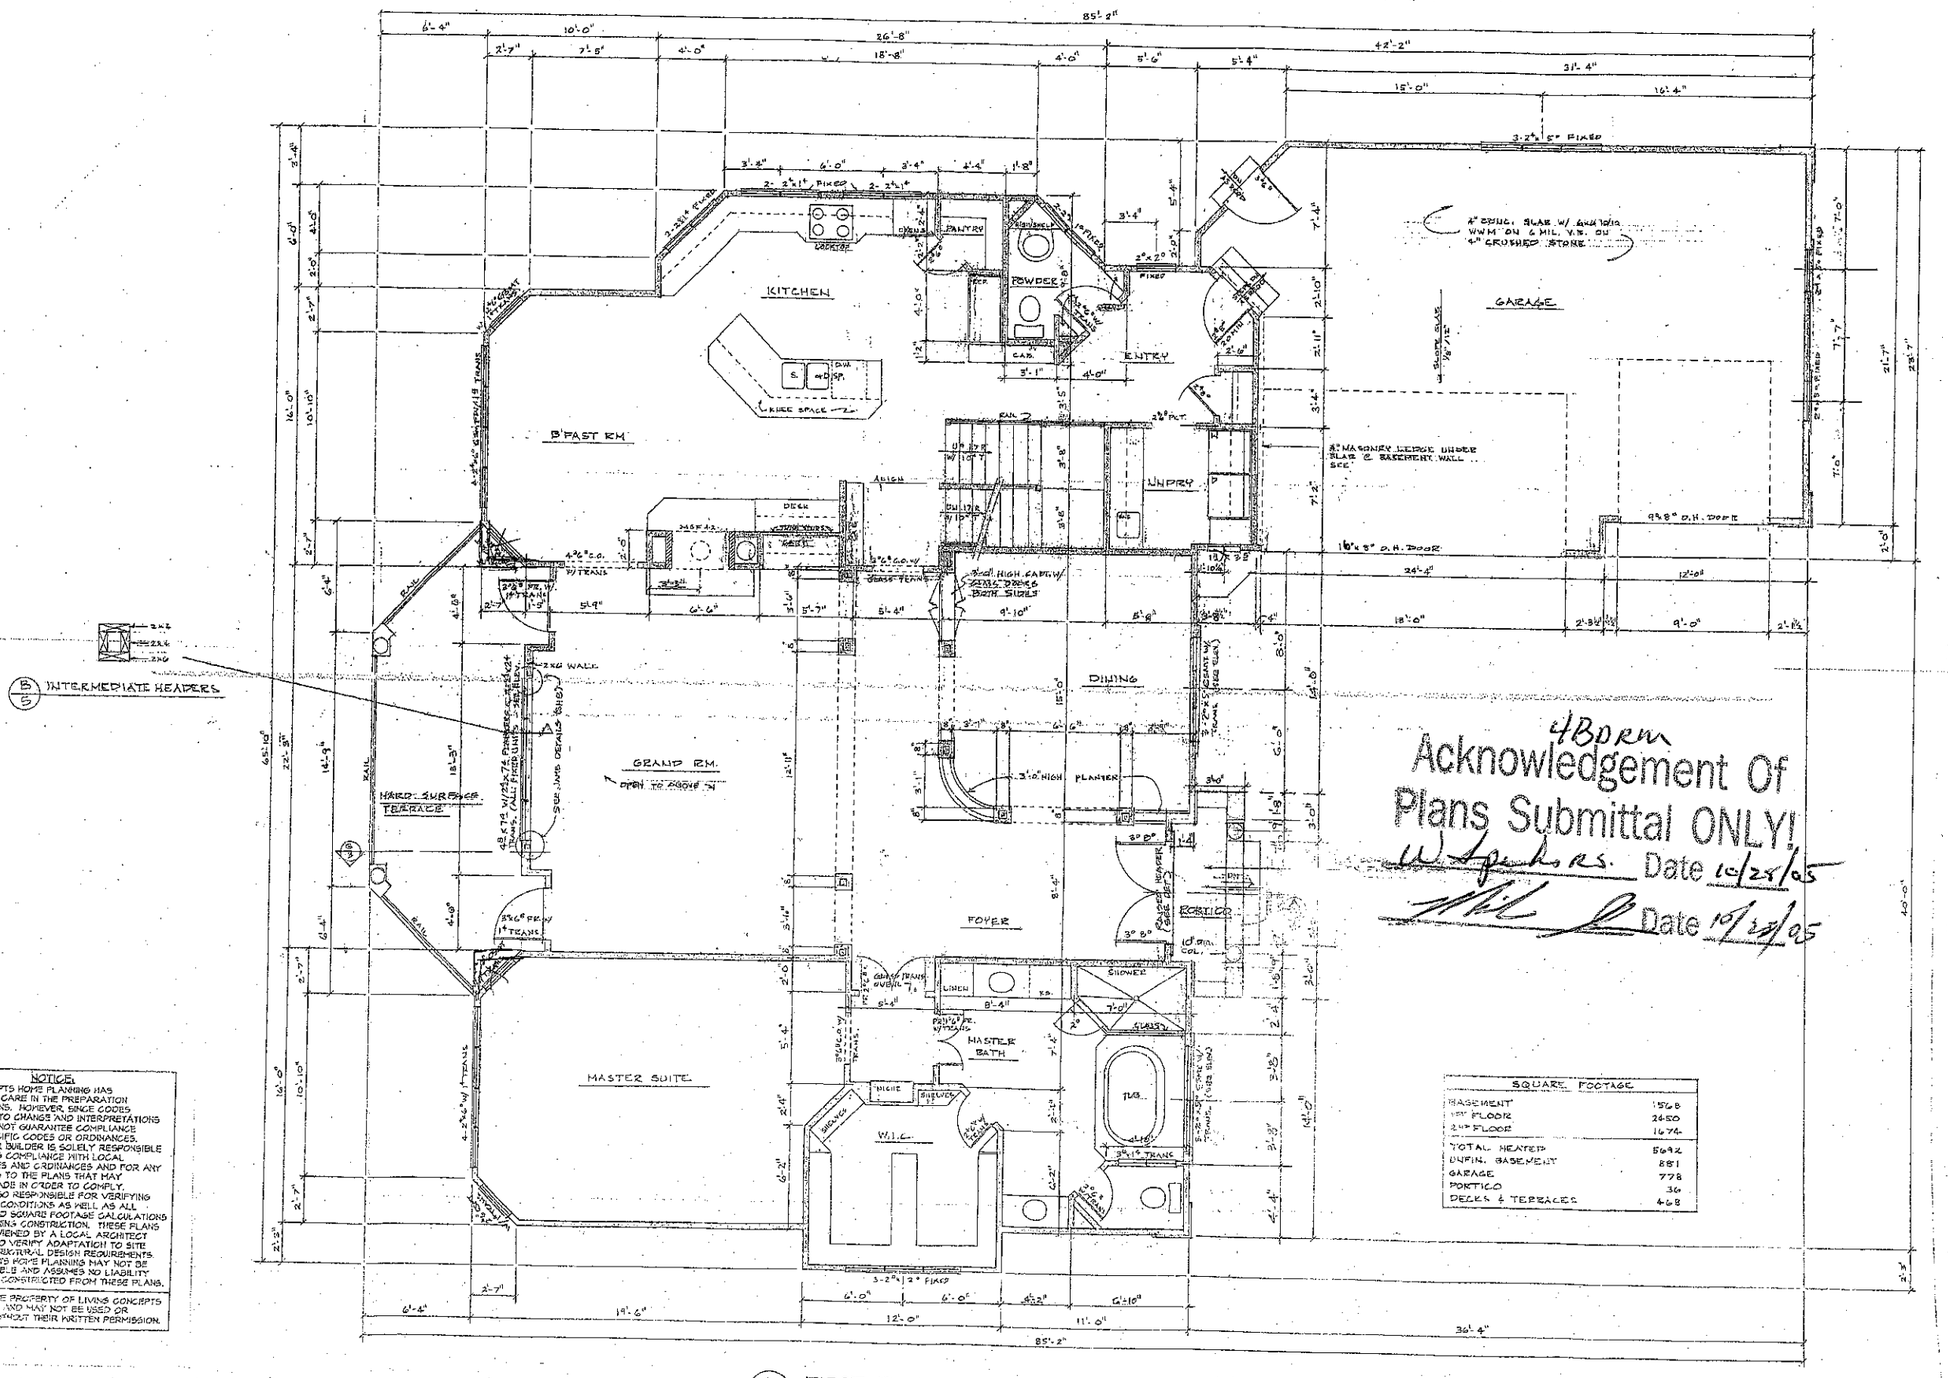

A 5 FIRST FLOOR PLAN
1/4" = 1'-0"

SQUARE FOOTAGE	
BASEMENT	1568
1ST FLOOR	2450
2ND FLOOR	1674
TOTAL HEATED	5692
UNFIN. BASEMENT	881
GARAGE	778
PORTICO	36
DECKS & TERRACES	468

4BDRM

Acknowledgement Of Plans Submittal ONLY!

W Spencer RS. Date 10/25/05

Date 10/25/05

NOTICE

LIVING CONCEPTS HOME PLANNING HAS TAKEN GREAT CARE IN THE PREPARATION OF THESE PLANS. HOWEVER, SINCE CODES ARE SUBJECT TO CHANGE AND INTERPRETATIONS VARY, WE DO NOT GUARANTEE COMPLIANCE WITH ANY SPECIFIC CODES OR ORDINANCES. PURCHASER OR BUILDER IS SOLELY RESPONSIBLE FOR VERIFYING COMPLIANCE WITH LOCAL BUILDING CODES AND ORDINANCES AND FOR ANY MODIFICATIONS TO THE PLANS THAT MAY NEED TO BE MADE IN ORDER TO COMPLY. BUILDER IS ALSO RESPONSIBLE FOR VERIFYING SITE AND SOIL CONDITIONS AS WELL AS ALL DIMENSIONS AND SQUARE FOOTAGE CALCULATIONS BEFORE BEGINNING CONSTRUCTION. THESE PLANS SHOULD BE REVIEWED BY A LOCAL ARCHITECT OR ENGINEER TO VERIFY ADAPTATION TO SITE AND LOCAL STRUCTURAL DESIGN REQUIREMENTS. LIVING CONCEPTS HOME PLANNING MAY NOT BE HELD RESPONSIBLE AND ASSUMES NO LIABILITY FOR HOMES CONSTRUCTED FROM THESE PLANS.

THESE PLANS ARE THE PROPERTY OF LIVING CONCEPTS HOME PLANNING AND MAY NOT BE USED OR REPRODUCED WITHOUT THEIR WRITTEN PERMISSION.

GENERAL CONTRACTOR SHALL BE HELD SOLELY RESPONSIBLE FOR COMPLETION OF ALL WORK SHOWN OR REASONABLY IMPLIED BY THESE DRAWINGS AND/OR SPECIFICATIONS. HE SHALL CONFIRM ALL DIMENSIONS AND CONDITIONS AT THE SITE AND SHALL IMMEDIATELY NOTIFY THE ARCHITECT IN WRITING OF ANY DISCREPANCIES. ARCHITECT NOT RESPONSIBLE FOR EQUIPMENT OR FIXTURES NOT SPECIFIED ON THESE PLANS.

Copyright 1997 Building Graphics Inc., Used by permission by Living Concepts


Living Concepts HOME PLANNING
INC.
1400 CLANEY EXECUTIVE PARK
CHARLOTTE, NC. 28210
(704) 541-2227
(FAX) 541-4289

COMM. NO. | JOB NO. | DRAWN BY: D.D. | CHECKED BY:

REVISIONS:

DATE:

SHEET NO. 5 OF 14

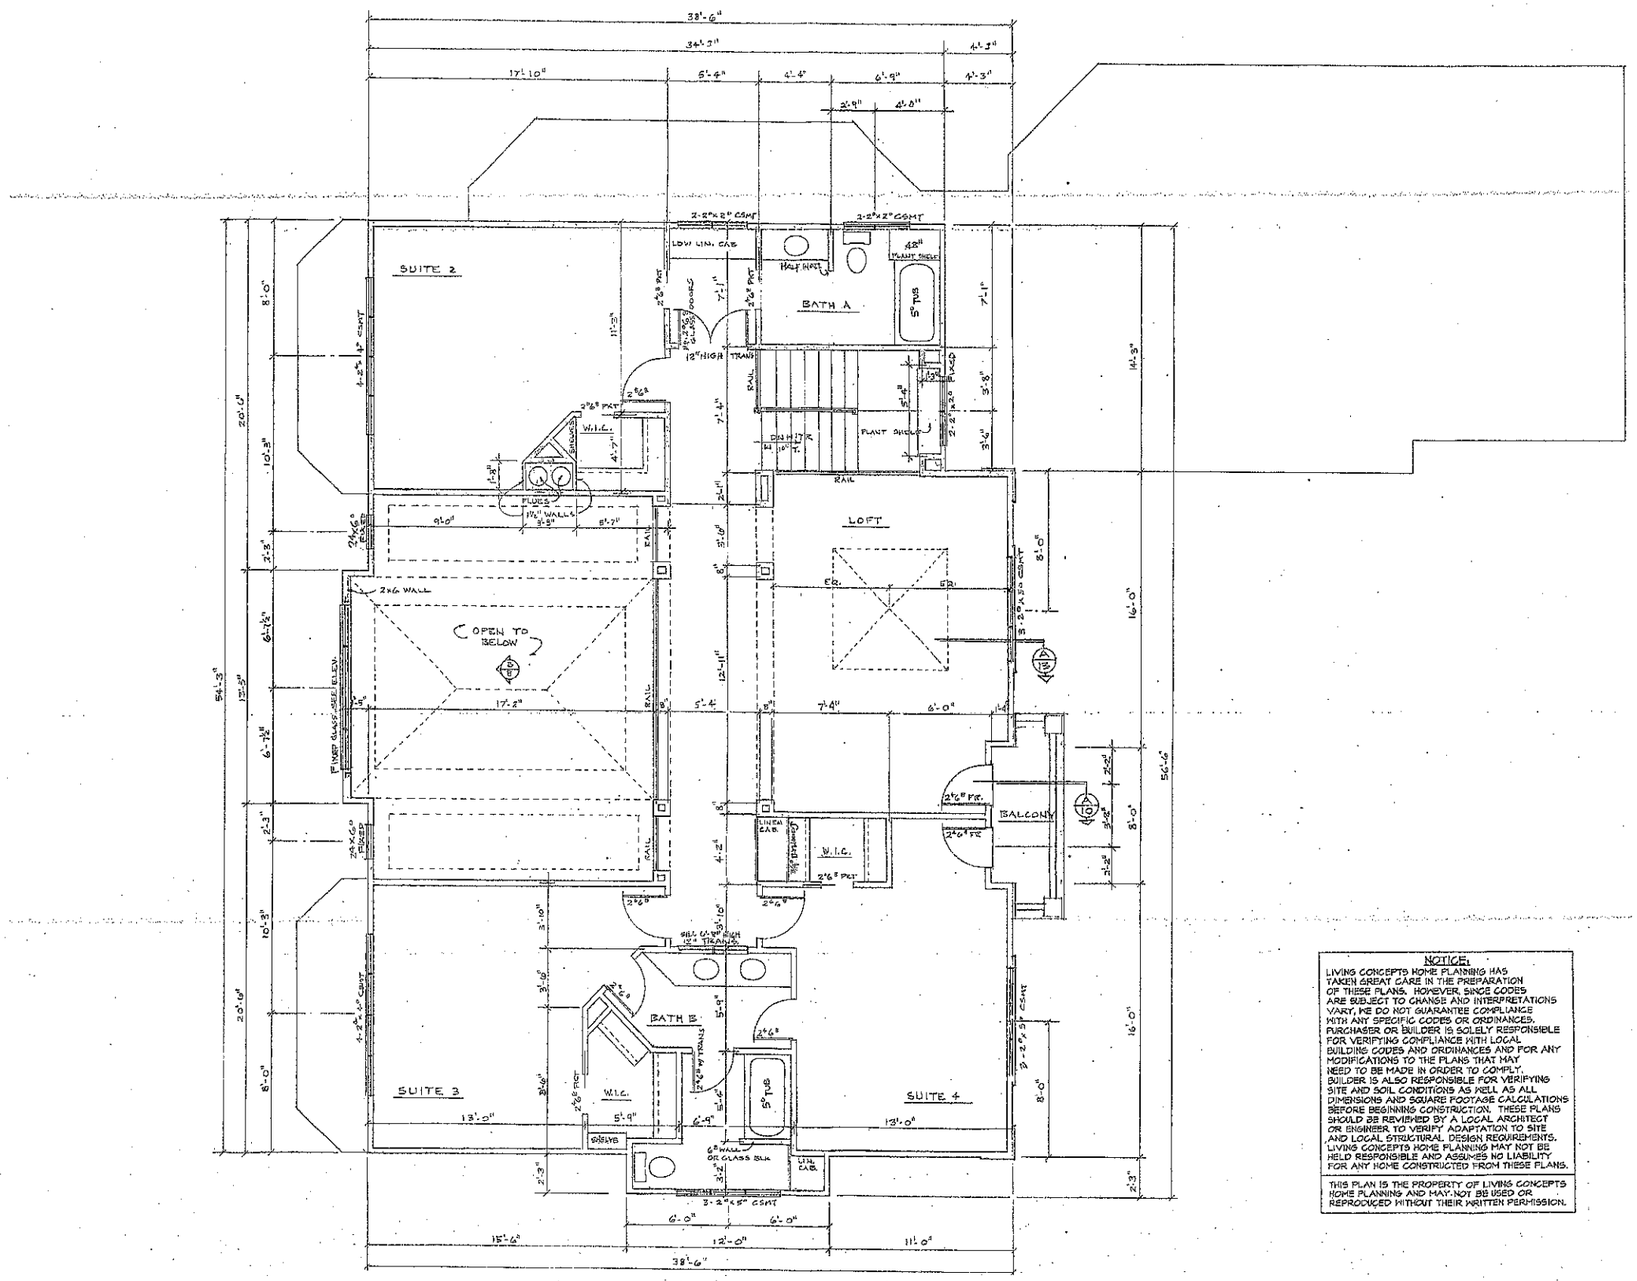

A/7 SECOND FLOOR PLAN
1/8" = 1'-0"

NOTICE

LIVING CONCEPTS HOME PLANNING HAS TAKEN GREAT CARE IN THE PREPARATION OF THESE PLANS. HOWEVER, SINCE CODES ARE SUBJECT TO CHANGE AND INTERPRETATIONS VARY, WE DO NOT GUARANTEE COMPLIANCE WITH ANY SPECIFIC CODES OR ORDINANCES. PURCHASER OR BUILDER IS SOLELY RESPONSIBLE FOR VERIFYING COMPLIANCE WITH LOCAL BUILDING CODES AND ORDINANCES AND FOR ANY MODIFICATIONS TO THE PLANS THAT MAY NEED TO BE MADE IN ORDER TO COMPLY. BUILDER IS ALSO RESPONSIBLE FOR VERIFYING SITE AND SOIL CONDITIONS AS WELL AS ALL DIMENSIONS AND SQUARE FOOTAGE CALCULATIONS BEFORE BEGINNING CONSTRUCTION. THESE PLANS SHOULD BE REVISED BY A LOCAL ARCHITECT OR ENGINEER TO VERIFY ADAPTATION TO SITE AND LOCAL STRUCTURAL DESIGN REQUIREMENTS. LIVING CONCEPTS HOME PLANNING MAY NOT BE HELD RESPONSIBLE AND ASSUMES NO LIABILITY FOR ANY HOME CONSTRUCTED FROM THESE PLANS.

THIS PLAN IS THE PROPERTY OF LIVING CONCEPTS HOME PLANNING AND MAY NOT BE USED OR REPRODUCED WITHOUT THEIR WRITTEN PERMISSION.

Copyright 1997 Building Graphics Inc., Used by permission by Living Concepts

Windmere F-4125

Living Concepts HOME PLANNING


COMM. NO. | JOB NO. | DRAWN BY: | CHECKED BY:
D.D.

REVISIONS:

DATE :

SHEET NO. 7 OF 14

Windmere F-4125

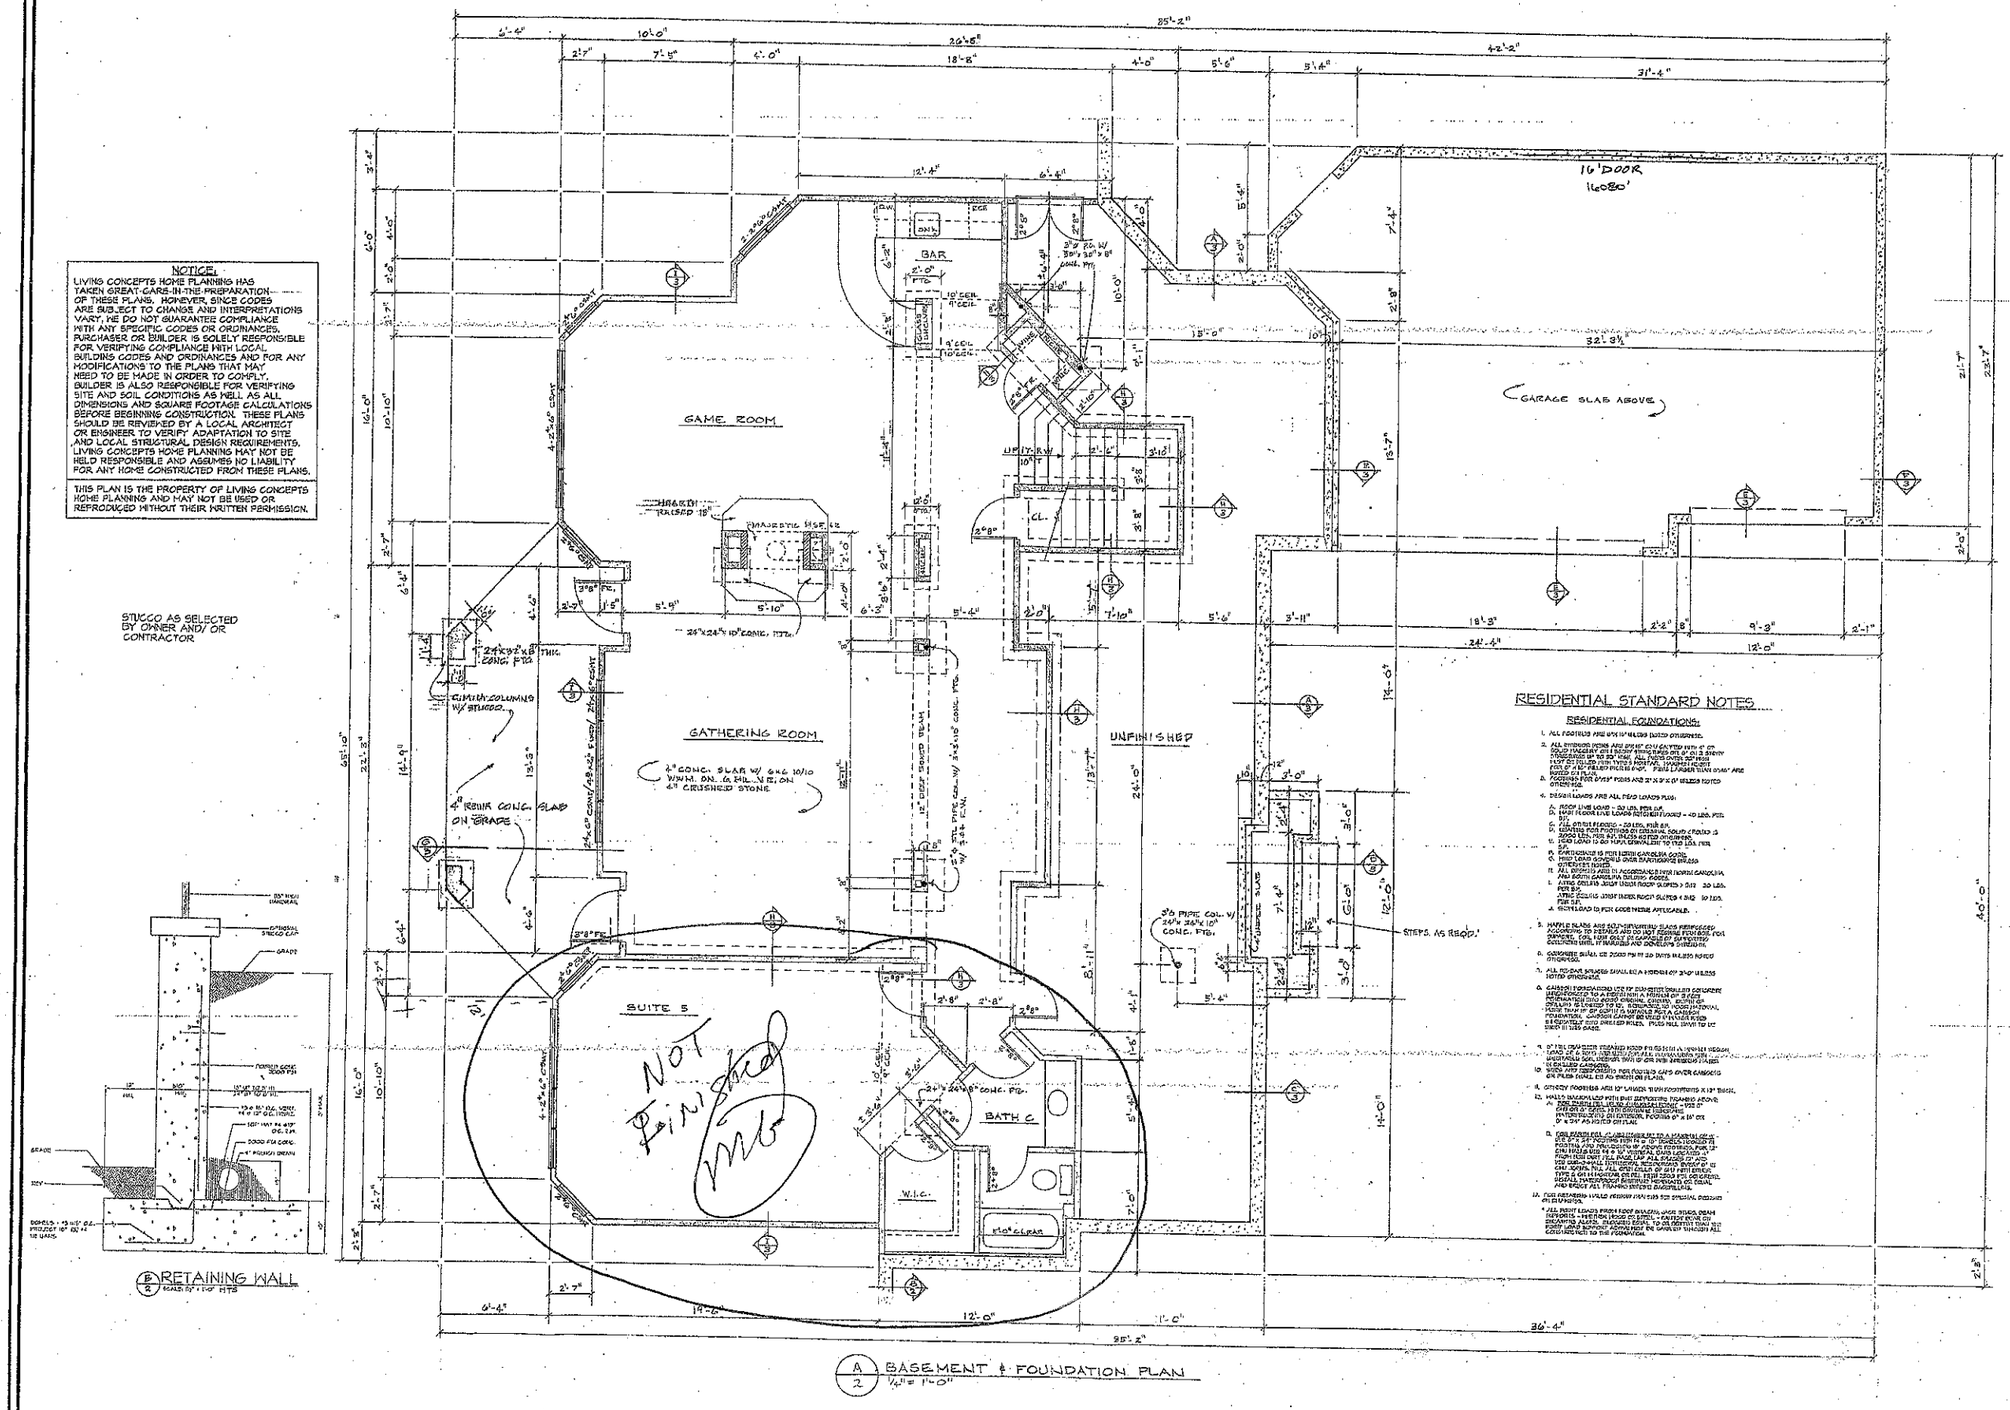

NOTICE:
LIVING CONCEPTS HOME PLANNING HAS TAKEN GREAT CARE IN THE PREPARATION OF THESE PLANS. HOWEVER, SINCE CODES ARE SUBJECT TO CHANGE AND INTERPRETATIONS VARY, WE DO NOT GUARANTEE COMPLIANCE WITH ANY SPECIFIC CODES OR ORDINANCES. PURCHASER OR BUILDER IS SOLELY RESPONSIBLE FOR VERIFYING COMPLIANCE WITH LOCAL BUILDING CODES AND ORDINANCES AND FOR ANY MODIFICATIONS TO THE PLANS THAT MAY NEED TO BE MADE IN ORDER TO COMPLY. BUILDER IS ALSO RESPONSIBLE FOR VERIFYING SITE AND SOIL CONDITIONS AS WELL AS ALL DIMENSIONS AND SQUARE FOOTAGE CALCULATIONS BEFORE BEGINNING CONSTRUCTION. THESE PLANS SHOULD BE REVIEWED BY A LOCAL ARCHITECT OR ENGINEER TO VERIFY ADAPTATION TO SITE AND LOCAL STRUCTURAL DESIGN REQUIREMENTS. LIVING CONCEPTS HOME PLANNING MAY NOT BE HELD RESPONSIBLE AND ASSUMES NO LIABILITY FOR ANY HOME CONSTRUCTED FROM THESE PLANS.

THIS PLAN IS THE PROPERTY OF LIVING CONCEPTS HOME PLANNING AND MAY NOT BE USED OR REPRODUCED WITHOUT THEIR WRITTEN PERMISSION.

RESIDENTIAL STANDARD NOTES

RESIDENTIAL EXCEPTIONS:

1. ALL FOOTINGS ARE 6'0" W UNLESS NOTED OTHERWISE.
2. ALL EXTERIOR WALLS ARE 2X6 @ 16" O.C. UNLESS NOTED OTHERWISE.
3. DESIGN LOADS ARE ALL FIELD VERIFIED:
   A. ROOF LIVE LOAD = 30 LBS. PER SQ. FT.
   B. ALL FLOOR LIVE LOADS (EXCEPT GARAGE) = 40 LBS. PER SQ. FT.
   C. ALL ATTIC AREAS = 20 LBS. PER SQ. FT.
   D. LOADING FOR PORTION OF GARAGE SLAB, SUPPORTING SOLID CONCRETE IS 2000 LBS. PER SQ. INCHES NOTED OTHERWISE.
   E. FLOOR LIVING LOAD OF 60 PSF FOR GARAGE SLAB NOT TO EXCEED 1/360 OF SPAN.
   F. ENVIRONMENT IS PER NORTH CAROLINA CODE.
   G. WIND LOADS SHOULD BE UNDER THE RANGE OF 90 MPH WITH EXPOSURE B.
   H. ALL DESIGNS ARE IN ACCORDANCE WITH NORTH CAROLINA AND SOUTH CAROLINA BUILDING CODES.
   I. ATTIC ACCESS SHALL BE MINIMUM (WHEN SLOPES > 3:12) 30 LBS. PER SQ. FT.
   ATTIC CEILING JOIST UNDER ROOF SLOPES < 3:12 50 LBS. PER SQ. FT.
   J. SEISMIC LOAD IS PER CODE WHERE APPLICABLE.



Living Concepts HOME PLANNING
704 / 542-3317
FAX 704 / 542-1499
9108 GABRIEL BOOKSTYE PARK
CHARLOTTE, N.C. 28215

COMM'A NO.	JOB NO.	DRAWN BY:	CHECKED BY:
D.D.			

REVISIONS:

DATE :

SHEET NO. 2

Copyright 1997 Building Graphics Inc., Used by permission by Living Concepts