IREDELL COUNTY HEALTH DEPARTMENT

Statesville Office (704) 878-5305 Mooresville Office (704) 660-3625 PERMIT # 215336

IMPROVEMENT PERMIT / AUTHORIZATION TO CONSTRUCT / OPERATION PERMIT / EXISTING SYSTEM

PIN # 4639533965

APPLICANT: Superior Pools APPLICANT ADDRESS: 20315 Knox Rd.

SITE ADDRESS: 150 Northington Woods Dr. - Mooresville PHONE: 704-505-2251 ALT. PHONE: 704-396-2665

SITE DIRECTIONS: Perth Rd to Fernhill Rd to Northington Woods Dr.


SUBDIVISION: Northington Woods SECTION: N/A LOT # 11 LOT AREA: 1.46 acres DESIGN FLOW: Existing L.T.A.R.: Existing

Septic Tank	Existing (gal)	STB	Date	☐ New System ☐ Repair ☐ Expansion	System Type: I II III IV V VI	☑ Residence	No. Bedrooms	Ex	Water Supply ☑ Private
Pump Tank	Existing (gal)	PT	Date	System Description:	Existing	☐ Business	No. Persons	Ex	☐ Public
Pump Make		Model	Serial #	Repair System Description:		☐ Other	No. Employees		☐ Community
# Nitrification Fields	Ex # Lines	Ex	Linear Ft: Ex	Maintenance Agreement Required:	☐ YES ☑ NO	☐ Slab	☐ Crawl Space		
Trench Width	Ex Max. Trench Bottom Depth	Ex	Gravel Depth Ex		☐ GRAVITY ☑ PRESSURE	☑ Basement w/plumbing			☐ Basement w/o plumbing


Comments / Conditions:

Maintain a minimum of 15' between pool area and all components of septic tank system.

INITIAL SITE SKETCH

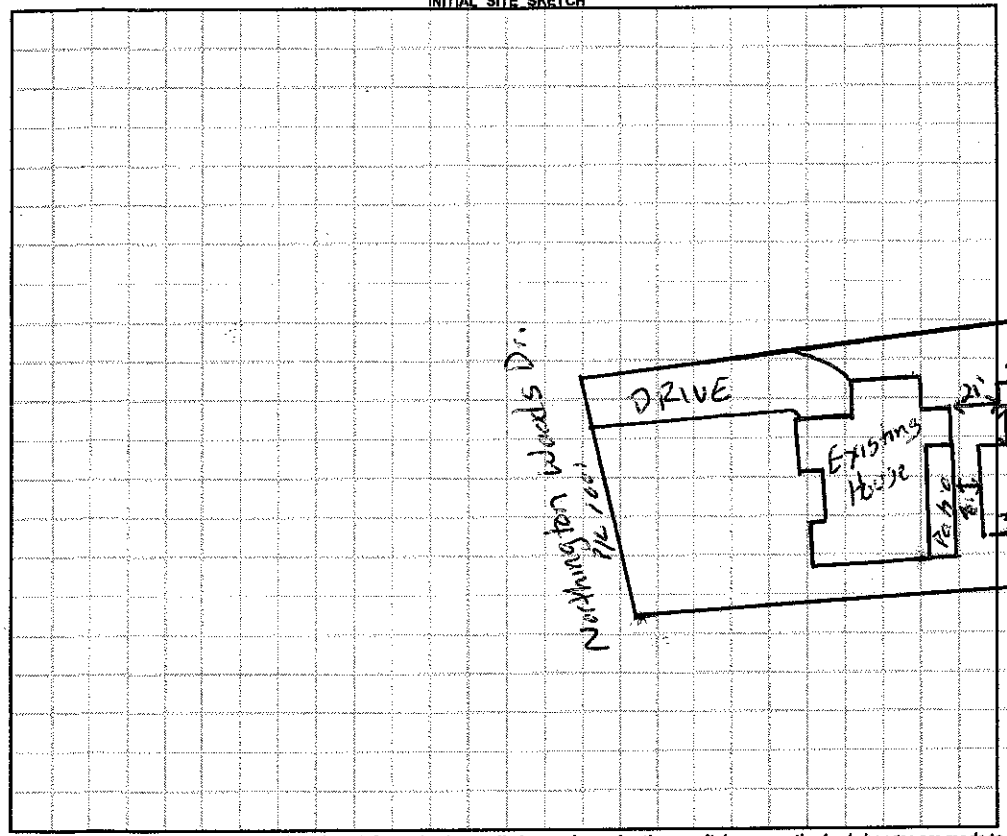

AS BUILT SKETCH

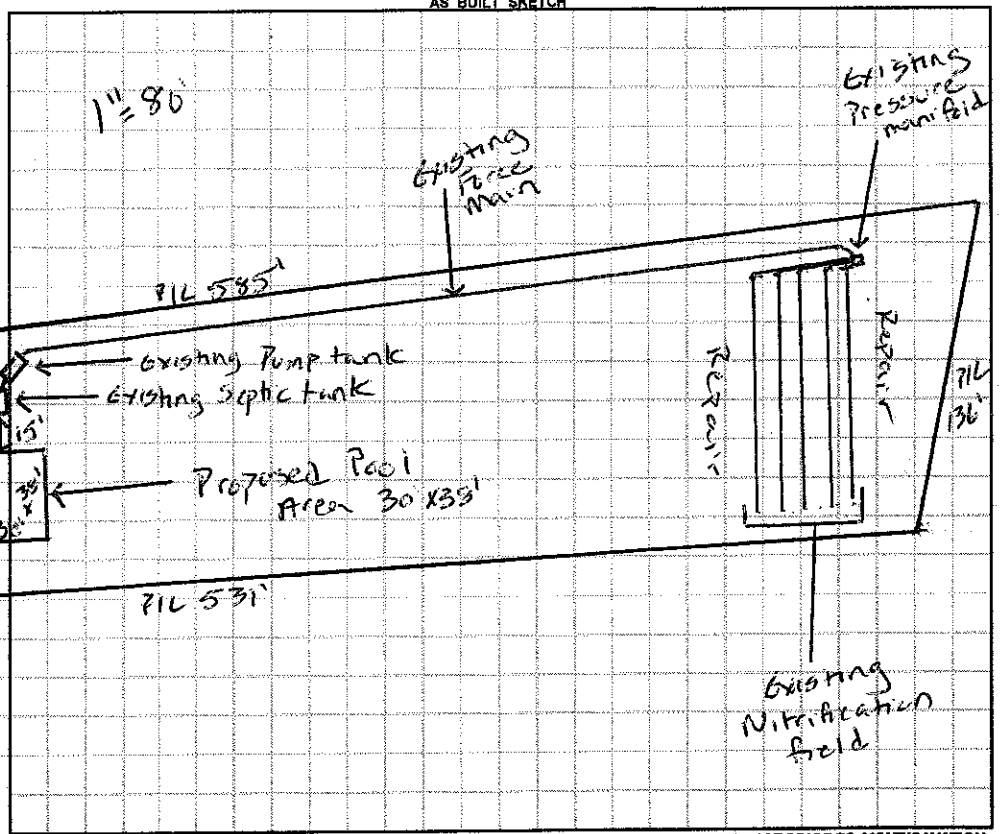

Permit can be suspended or revoked if any false information is supplied toward securing the permit / any unauthorized changes are made to the site / any unauthorized changes are made in the installation of the system. **CONTACT A LOCATOR SERVICE PRIOR TO ANY EXCAVATION**

☐ **IMPROVEMENT PERMIT** *with plat valid without expiration.* ☐ **IMPROVEMENT PERMIT** *with site plan valid for 60 mos.* ☐ **AUTHORIZATION TO CONSTRUCT** *valid for period equal to IMPROVEMENT PERMIT--not to exceed 60 mo.*

Owner / Applicant Signature: [signature] Date: 1-20-16 Installed by:

IMPROVEMENT PERMIT by: Date: OPERATION PERMIT by: Date:

AUTHORIZATION TO CONSTRUCT by: Date: Existing System Inspected by: Justin Henderson Date: 1-11-16

Health Dept. Copy - WHITE Applicant (Final Approval) - YELLOW Applicant (Conditional Approval) - PINK