IREDELL COUNTY HEALTH DEPARTMENT

STATESVILLE 704-878-5305 330.00 Paid MOORESVILLE 704-664-5281

IMPROVEMENT PERMIT / AUTHORIZATION TO CONSTRUCT / OPERATION PERMIT / EXISTING SYSTEM INSPECTION

PERMIT# 092357 PIN# 4639734475 (pt) 4639535333 DATE 10-11-02

OWNER OR CONTRACTOR Roger Hand (Titan Builders) PHONE: Business 820-0550 Home Cell 201-6705

ADDRESS 6876 Lowesville Ln Stanley NC 28164 Fax 895-4860

LOCATION Perth Rd North to Fern Hill Trl. Wildwood Cove on left at end

SUBDIVISION Wildwood Cove BLOCK / SECTION ____ LOT 10 LOT AREA 26,016 ft² SITE CLASS PS DESIGN FLOW 180gpd L.T.A.R. .3

Septic Tank: 1000 Gallons; STB ~~3127~~ Date ____

Pump Tank: ____ Gallons; PT ____ Date ____

Pump Make: ____ Model ____ Serial No. ____

Nitrification Field: No Fields 1 Square Feet 810' Linear Feet 270'

No Lines 6@45' Trench Width 36"-24" Max Trench Bottom Depth 30" Gravel Depth N/A

☒ New System ☐ Repair System Type: I, II, III, IV, V, VI

System Description: Gravity Panel Block

Repair System Description: Pres. Panel

Maintenance Agreement Required: ☐ Yes ☒ No Not Initially

☒ House/Mod. Home ☐ Mobile Home ☐ Business ☐ Other Detached garage w/plumbing

No. Bedrooms 4 No. Bathrooms 4.5 No. Employees ____


☐ Slab ☒ Crawl Space ☐ Basement w/plumbing ☐ Basement w/o plumbing

Water Supply: ☒ Individual ☐ Public ☐ Community

Comments:/Conditions: Keep Septic System at least 10' from PL, 5' from building foundation & at least 50' feet to any well.

Comments:/Conditions: Builder wants to use self contained pump tank for bath in garage. Okay to use "Quik Jon, Hilo's, Power Flush" or equivalent.

INITIAL SITE SKETCH Scale 1:50

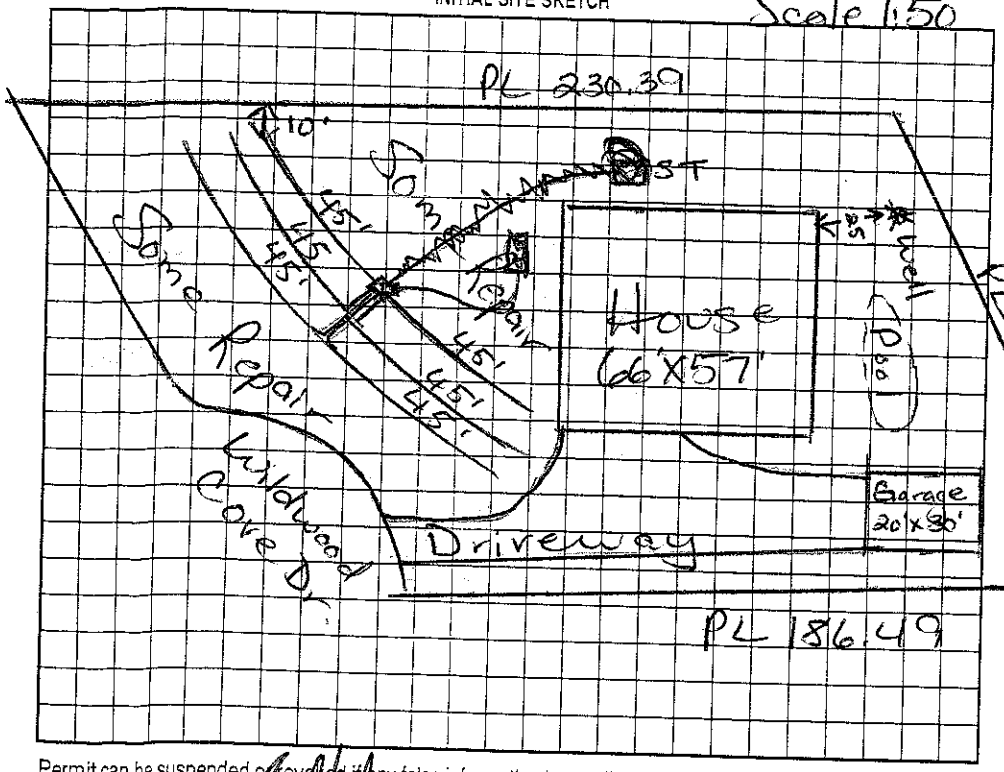

AS BUILT SKETCH

Self contained Pump tank for 1/2 bath only to discharge into house plumbing at least 10ft upslope of Septic tank

Permit can be suspended or revoked if any false information is supplied toward securing the permit/any unauthorized changes are made to the site/any unauthorized changes are made in the installation of the system. Improvement Permit with plat valid without expiration. Improvement Permit with site plan valid for sixty months. Authorization to Construct is valid for a period equal to that of Improvement Permit – not to exceed sixty months.

Signed: ____ date 10/17/2002 Installed by: D+M

Improvement Permit by: Maria H. Dotson RS date 10/11/02 Operation Permit by: Wesley Sparks RS date 12/23/02

Authorization to Construct by: Maria H. Dotson RS date 10/11/02 Existing System Inspection by: ____ date ____

HEALTH DEPT. COPY: WHITE OWNER COPY (FINAL): YELLOW OWNER COPY (INITIAL): PINK