# IREDELL COUNTY HEALTH DEPARTMENT

STATESVILLE 704-878-5305 MOORESVILLE 704-664-5281

## IMPROVEMENT PERMIT / AUTHORIZATION TO CONSTRUCT / OPERATION PERMIT / EXISTING SYSTEM INSPECTION

PERMIT# D92 391 PIN# ~~4639 13 44 75~~ (pt) Dare 4639536192,000 DATE 1-20-04

OWNER OR CONTRACTOR White House Builders PHONE: Business 704 309-4301 Home

ADDRESS P.O. Box 188 Mt. Mourne, NC. 28123

LOCATION Perth Rd North Rt. Fern Hill Tl. Wildwood Cove Dr on right near end

SUBDIVISION Wildwood Cove BLOCK / SECTION LOT 13/13A LOT AREA SITE CLASS. PS DESIGN FLOW 600gpd L.T.A.R. .3

Septic Tank: 1500gal Gallons: STB 338 Date 4-19-04
Pump Tank: 1500gal Gallons: PT 421 Date 4-06-04
Pump Make: Myers Model ME 150 Serial No.
Nitrification Field: No Fields 1 Square Feet 1500' Linear Feet 500'
No Lines 5@100' Trench Width 36" Max Trench Bottom Depth 36" Gravel Depth N/A

☒ New System ☐ Repair System Type: I, II, (III) IV, V, VI
System Description: Pump-PM-25% Reduction
Repair System Description: LP-Innovative (Panel)
Maintenance Agreement Required: ☐ Yes ☒ No Not Initially


☒ House/Mod. Home No. Bedrooms 5
☐ Mobile Home No. Bathrooms 4
☐ Business No. Employees
☐ Other
☐ Slab ☐ Crawl Space ☒ Basement w/plumbing ☐ Basement wo/plumbing

Water Supply: ☒ Individual ☐ Public ☐ Community


Comments:/Conditions: Keep Septic System at least 10' from PL & 50' from lake.

Comments:/Conditions: Tanks Checked 5/24/04
Checked lines 9/23/04
Pressure, elect. & alarm 10/4/04

INITIAL SITE SKETCH

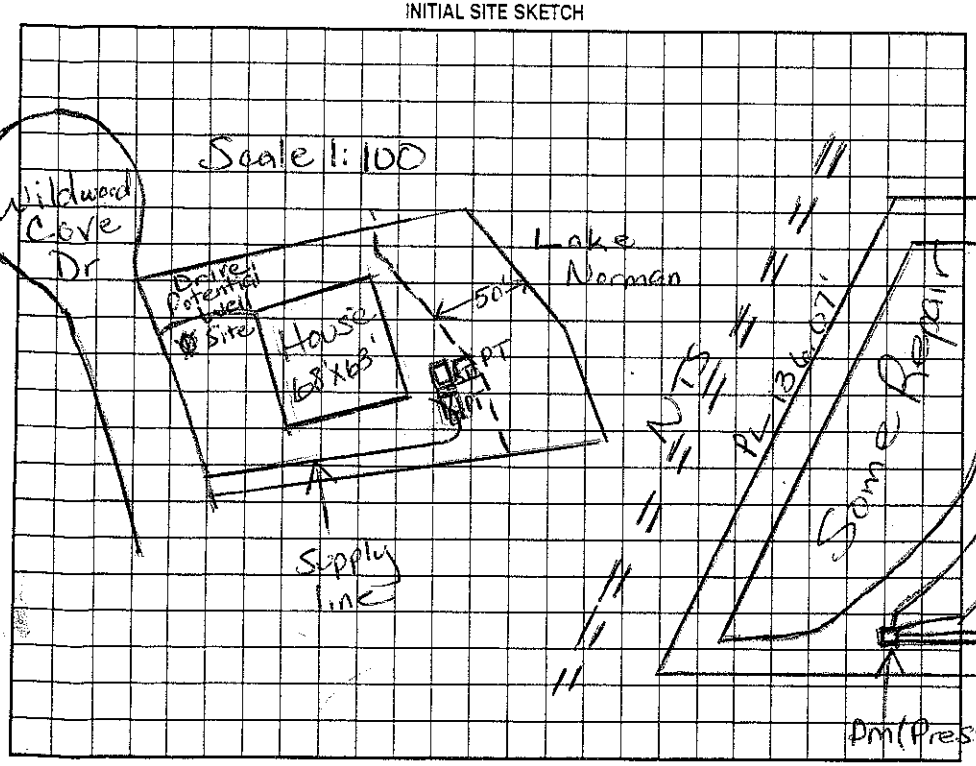


AS BUILT SKETCH

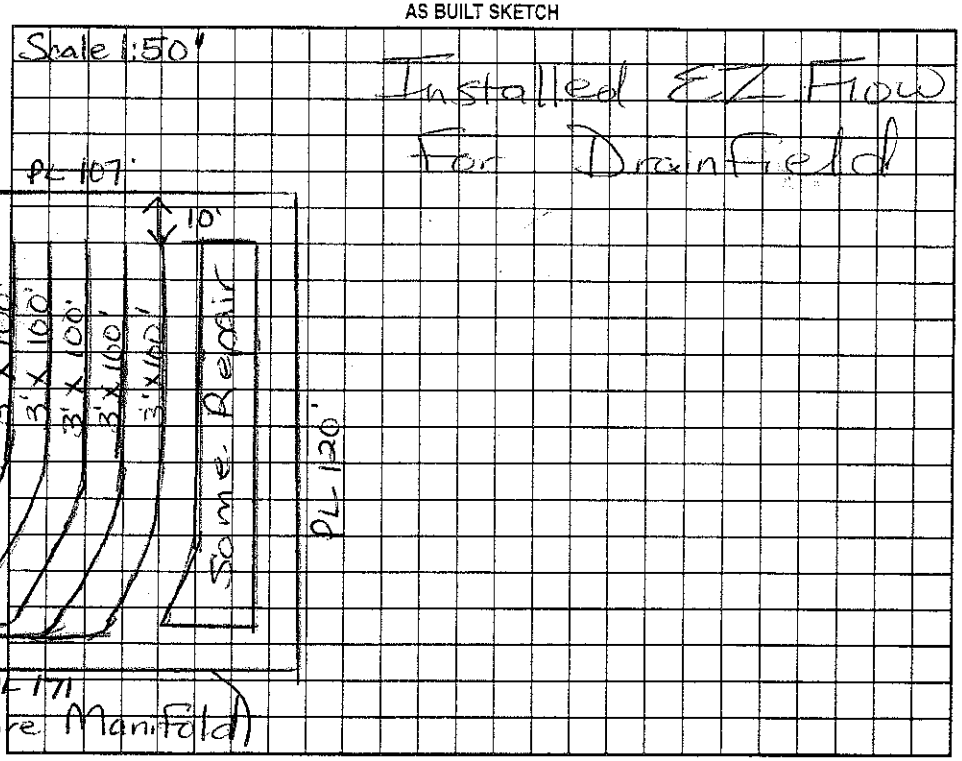


Permit can be suspended or revoked if any false information is supplied toward securing the permit/any unauthorized changes are made to the site/any unauthorized changes are made in the installation of the system. Improvement Permit with plat valid without expiration. Improvement Permit with site plan valid for sixty months. Authorization to Construct is valid for a period equal to that of Improvement Permit – not to exceed sixty months.

Signed: date 1/21/04

Improvement Permit by: Maria H. Dotson RS date 1/21/04

Authorization to Construct by: Maria H. Dotson RS date 1/22/04

Installed by: R & H date

Operation Permit by: Maria H. Dotson RS date 10/4/04

Existing System Inspection by: date

HEALTH DEPT. COPY: WHITE OWNER COPY (FINAL): YELLOW OWNER COPY (INITIAL): PINK