COPY

IREDELL COUNTY HEALTH DEPARTMENT

STATESVILLE 704-878-5305 MOORESVILLE 704-664-5281

IMPROVEMENT PERMIT / AUTHORIZATION TO CONSTRUCT / OPERATION PERMIT / EXISTING SYSTEM INSPECTION

PERMIT # 1638666 PIN # 4639-53-7775 DATE 11-30-16

OWNER or APPLICANT MICHAEL & GINA CONSTANTINE PHONE: Business 704-799-4688 Home:

OWNER or APPLICANT ADDRESS 172 NORTHINGTON WOODS DR. MOORESVILLE NC

LOCATION / DIRECTIONS PERTH

SUBDIVISION NORTHINGTON WOODS BLOCK / SECTION LOT # 15 LOT AREA DESIGN FLOW 480 L.T.A.R. .25

Septic Tank Ex 1000 Gallons: STB 1012 Date 10-11-05

Pump Tank Ex 1000 Gallons: PT 17 Date 4-4-06

Pump Make GOULDS Model WE0-5114 Serial #

Nitrification Field No Fields ____ No Lines ____ Linear Feet

Trench Width ____ Max. Trench Bottom Depth EXIST TANK Gravel Depth ____

☐ New System ☐ Repair ☐ Expansion System Type I II III (IV) V VI

System Description: LP- PANEL BLOCK

Repair System Description: SAME

Maintenance Agreement Required ☒ YES ☐ NO

☐ GRAVITY ☒ PRESSURE

☒ Residence No. Bedrooms ____

☐ Business No. Persons ____

☒ Other No. Employees ____

☐ Slab ☐ Crawl Space

☒ Basement w/plumbing ☐ Basement w/o plumbing

Water Supply: ☒ Private ☐ Public ☐ Community

Comments / Conditions (1) ENVIRONMENTAL HEALTH TO INSPECT AFTER DECK IS COMPLETE TO INSURE MIN 5' TO TANKS


CALL REN ALDRIDGE @ 704-660-3632 TO SCHEDULE

Comments / Conditions


POOL ADDITION / SCREEN IN PORCH

DECK ADDITION

INITIAL SITE SKETCH

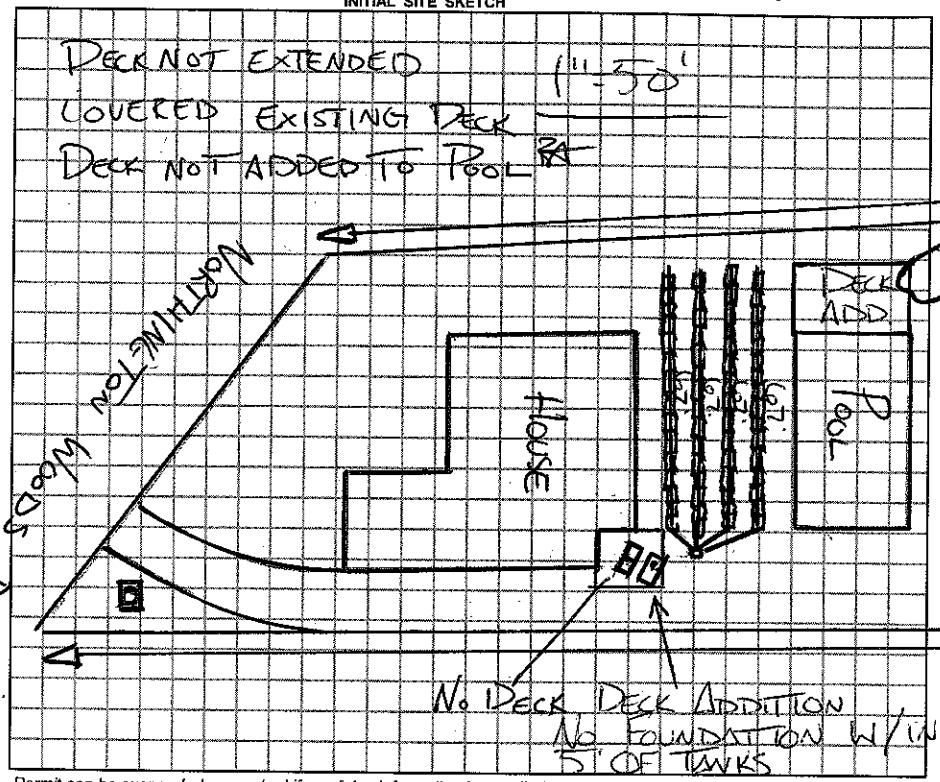

AS BUILT SKETCH

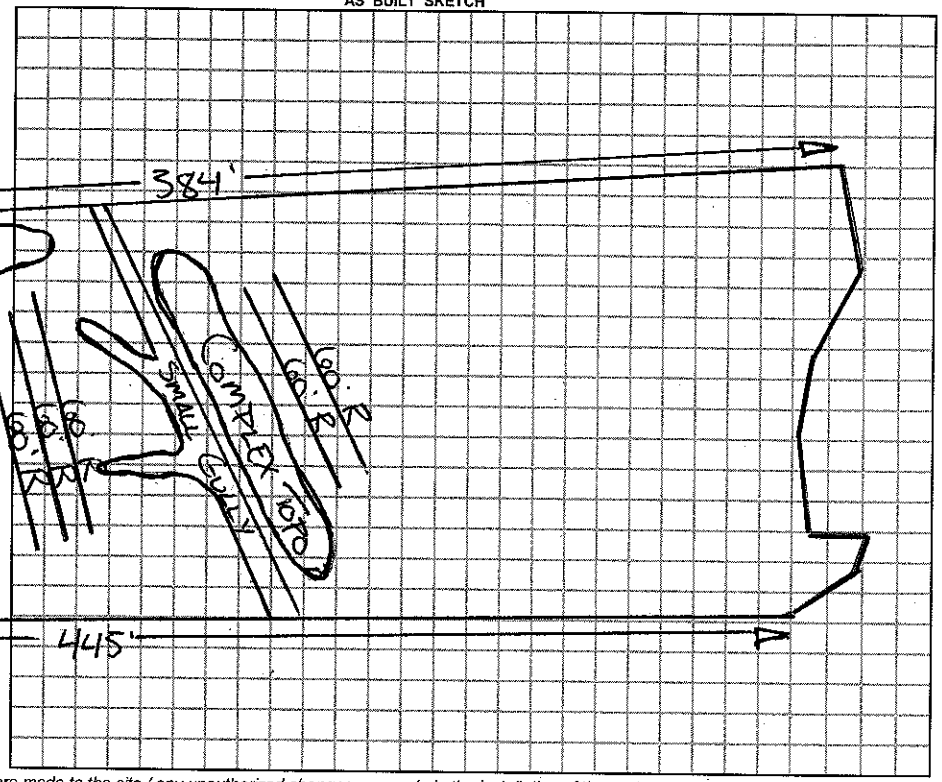

Permit can be suspended or revoked if any false information is supplied toward securing the permit / any unauthorized changes are made to the site / any unauthorized changes are made in the installation of the system.

☐ *IMPROVEMENT PERMIT w / plat valid without expiration* ☐ *IMPROVEMENT PERMIT w / site plan valid for 60 mos.* ☒ *AUTHORIZATION TO CONSTRUCT valid for period equal to IMPROVEMENT PERMIT-not to exceed 60 mo.*

Owner / Applicant Signature: Date 1-21-11

Improvement Permit by: REHS Date 11-30-10

Authorization to Construct by: REHS Date 11-30-10

YOU SHOULD CONTACT A LOCATOR SERVICE PRIOR TO ANY EXCAVATION.

Installed by:

Operation Permit by: REHS Date: 5-5-11

Existing System Inspected by: Date:

WHITE COPY Environmental Health YELLOW COPY (Final) Owner / Applicant PINK COPY (Initial) Owner / Applicant