IREDELL COUNTY HEALTH DEPARTMENT

STATESVILLE 704-878-5305 MOORESVILLE 704-664-5281

IMPROVEMENT PERMIT / AUTHORIZATION TO CONSTRUCT / OPERATION PERMIT / EXISTING SYSTEM INSPECTION

PERMIT# 122544 PIN# ~~4639-64-0340.000~~ 4639538674.000

OWNER OR APPLICANT Anaheim Homes DATE 5-9-07

ADDRESS PO Box 610 Cornelius NC 28031 PHONE: Business 704-461-8800 Home

LOCATION Perth Rd N TL Fern Hill TL Northingtonwoods Dr on right near end

SUBDIVISION Northington Woods BLOCK / SECTION LOT 16 LOT AREA 1.954 Ac SITE CLASS. PS DESIGN FLOW 480 gpd L.T.A.R. .3 gpd/ft²

Septic Tank: 1000 Gallons; STB 1012 Date 3-13-07

Pump Tank: 1000 Gallons; PT 17 Date 3-4-7

Pump Make: Goulds Model WE05T1HH Serial No. DD75300

Nitrification Field: No Fields 1 Square Feet Linear Feet 400

No Lines 7@50' Trench Width 36" Max Trench Bottom Depth 36"

☒ New System ☐ Repair ☐ Expansion System Type: I II (III) IV V VI

System Description: 2590 reduction pm

Repair System Description: LP PPAPS

Maintenance Agreement Required: ☐ Yes ☒ No

☒ House/Mod. Home ☐ Mobile Home ☐ Business ☐ Other

No. Bedrooms 4 No. Persons 8 No. Employees

Water Supply: ☒ Individual ☐ Public ☐ Community


Gravel Depth NA ☐ Gravity ☒ Pressure ☐ Slab ☐ Crawl Space ☒ Basement w/plumbing ☐ Basement wo/plumbing

Comments:/Conditions: Keep drainlines 5' either side of gas pipe. Straight pipe 10' through-connected by lower endcaps. Use whacker packer to compact soil in 10' span. Use traffic rated tanks if depth is an issue.


Comments:/Conditions:
- yellow poly-ill used
- 2 wide 45 used 5-23-07 jh
- ~~pressure head 5'~~
- 10' between lines

1" = 50'

INITIAL SITE SKETCH

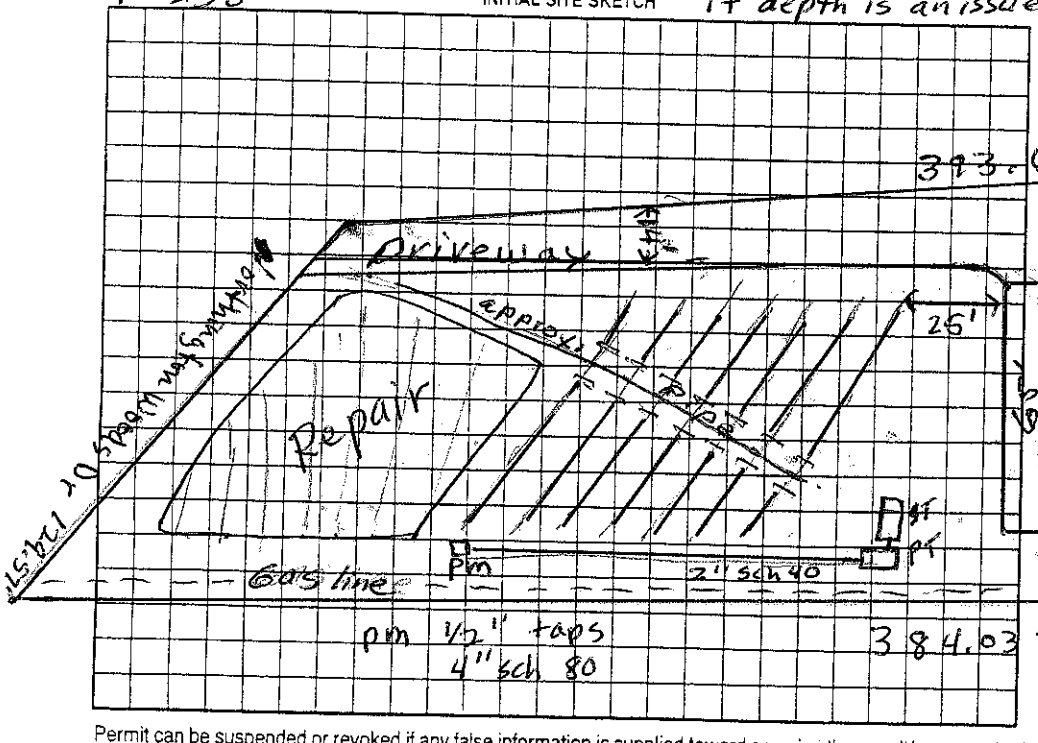

AS BUILT SKETCH

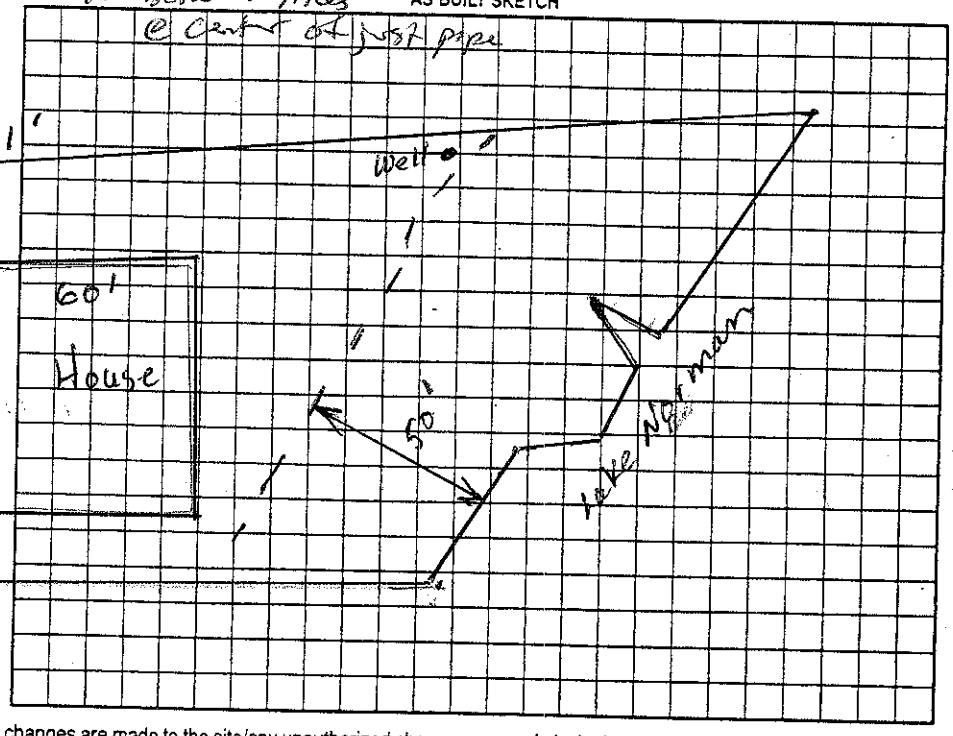

Permit can be suspended or revoked if any false information is supplied toward securing the permit/any unauthorized changes are made to the site/any unauthorized changes are made in the installation of the system. Improvement Permit with plat valid without expiration. ☐ Improvement Permit with site plan valid for sixty months ☒ Authorization to Construct is valid for a period equal to that of Improvement Permit – not to exceed sixty months.

Signed: [signature] date 5-10-07

Improvement Permit by: Judy Melville date 5-9-07

Authorization to Construct by: Judy Melville date 5-9-07

Installed by: Tommy Fagg

Operation Permit by: [signature] RS. date 8/10/07

Existing System Inspection by: date

HEALTH DEPT. COPY: WHITE OWNER COPY (FINAL): YELLOW OWNER COPY (INITIAL): PINK