IREDELL COUNTY HEALTH DEPARTMENT

STATESVILLE 704-878-5305 MOORESVILLE 704-664-5281

IMPROVEMENT PERMIT / AUTHORIZATION TO CONSTRUCT / OPERATION PERMIT / EXISTING SYSTEM INSPECTION

PERMIT# 122693 PIN# 4639640340.075 4639 54 0967 DATE 9-14-06

OWNER OR APPLICANT J&K Developers LLC PHONE: Business _____ Home _____

ADDRESS 3843 Gordon St. Terrell, NC 28682

LOCATION Perth Rd N TL Fern Hill Rd TL Northington Woods Dr ~ 200ft on left

SUBDIVISION Northington Wds BLOCK / SECTION _____ LOT 15 LOT AREA .559 Acre SITE CLASS. PS DESIGN FLOW 480gpd L.T.A.R. .25-.3

Septic Tank: 1000 Gallons: STB 1007 Date 6-23-06
Pump Tank: 1000 Gallons: PT 2774 Date 7-13-06
Pump Make: _____ Model _____ Serial No. _____
Nitrification Field: No Fields 1 Square Feet 640 Linear Feet 320'
No Lines 4 Trench Width 24" min Max Trench Bottom Depth 36"

☒ New System ☐ Repair ☐ Expansion System Type: I II III (IV) V VI
System Description: Pump-LP-Panel Blk
Repair System Description: Same
Maintenance Agreement Required: ☒ Yes ☐ No

☒ House/Mod. Home No. Bedrooms 4
☐ Mobile Home No. Persons ____
☐ Business No. Employees ____
☐ Other _____

Water Supply: ☒ Individual ☐ Public ☐ Community


Gravel Depth N/A ☐ Gravity ☒ Pressure ☐ Slab ☒ Crawl Space ☐ Basement w/plumbing ☐ Basement wo/plumbing

Comments:/Conditions: Replaces previous permit issued 2-20-06 to accomodate small pool.


Comments:/Conditions: Must keep Future pool at least 15FT from Septic System
Lines & tanks checked 8/29/06
Pres, elect & alarm 9/26/06

Scale 1:50

INITIAL SITE SKETCH

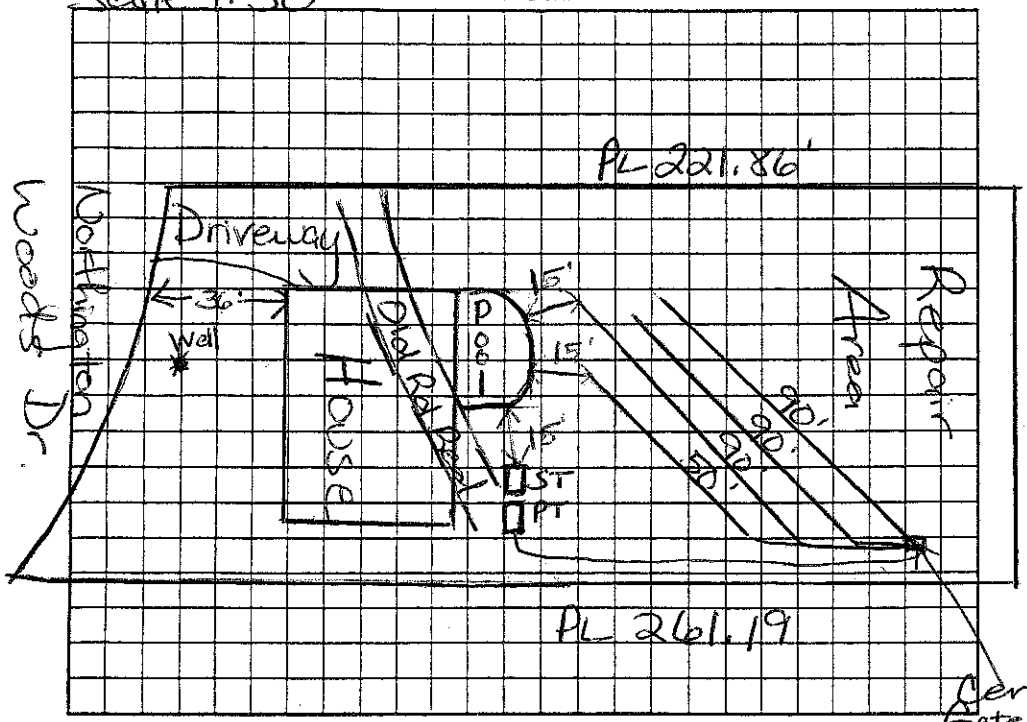

AS BUILT SKETCH

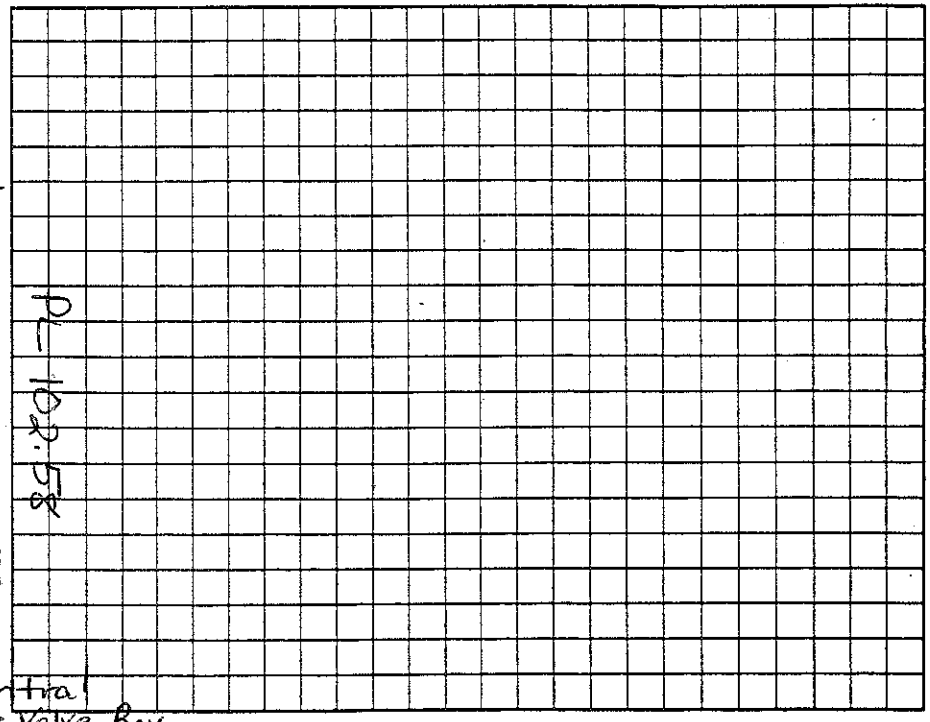

Permit can be suspended or revoked if any false information is supplied toward securing the permit/any unauthorized changes are made to the site/any unauthorized changes are made in the installation of the system. Improvement Permit with plat valid without expiration ☐ Improvement Permit with site plan valid for sixty months ☐ Authorization to Construct is valid for a period equal to that of Improvement Permit – not to exceed sixty months.

Signed: Randy Higgins date 9/20/06 Installed by: Richard Abercrombie

Improvement Permit by: Maria H. Dotson RS date 9/15/06 Operation Permit by: Maria H. Dotson RS date 10/11/06

Authorization to Construct by: Maria H. Dotson RS date 9/15/06 Existing System Inspection by: _____ date _____

HEALTH DEPT. COPY: WHITE OWNER COPY (FINAL): YELLOW OWNER COPY (INITIAL): PINK