146616 4639 54 1057

IREDELL COUNTY HEALTH DEPARTMENT

STATESVILLE 704-878-5305 MOORESVILLE 704-664-5281

IMPROVEMENT PERMIT / AUTHORIZATION TO CONSTRUCT / OPERATION PERMIT / EXISTING SYSTEM INSPECTION

PERMIT# ~~12-477~~ PIN# 4639-64-0340.009 DATE Jan 31, 05

OWNER OR CONTRACTOR Shevenden Dev Group LLC / Testa & Wirth PHONE: Business 509-6000 / 361 Home 7131 Chuck Kolb

ADDRESS 1143 D. Executive Grove Cany N.C. 27511

LOCATION feet by Rd. N. TL FERN Hill TL Northington Woods Dr. on Right

SUBDIVISION Northington Woods BLOCK / SECTION ____ LOT 9 LOT AREA 1.237 Ac SITE CLASS PS DESIGN FLOW 480gpd L.T.A.R. .53

Septic Tank: 1000 Gallons; STB 794 Date 7-9-08
Pump Tank: 1000 Gallons; PT 27 Date 10-28-08
Pump Make: Gould's Model WE07T2H Serial No. ____
Nitrification Field: No. Fields 1 Square Feet 540/810 Linear Feet 270
No Lines 5 4 Trench Width 24" min/36" max Max Trench Bottom Depth 36" Gravel Depth NA

☑ New System ☐ Repair System Type: I, II, III, IV, V, VI
System Description: LPPPBPS
Repair System Description: LPPPBPS
Maintenance Agreement Required: ☑ Yes ☐ No


☑ House/Mod. Home No. Bedrooms 4
☐ Mobile Home No. Bathrooms ____
☐ Business No. Employees ____
☐ Other ____
☐ Slab ☐ Crawl Space ☑ Basement w/plumbing ☐ Basement wo/plumbing

Water Supply: ☑ Individual ☐ Public ☐ Community


Comments:/Conditions:
11/14/07 Reviewed Floor plans, in Compliance with original permit
9/25/08 Lines checked
on 36" Max Bldg Loc

Comments:/Conditions:
Note: Okay to make Circular drive in front just leave room for well.
Use In line filter in PT

INITIAL SITE SKETCH 1"=50'

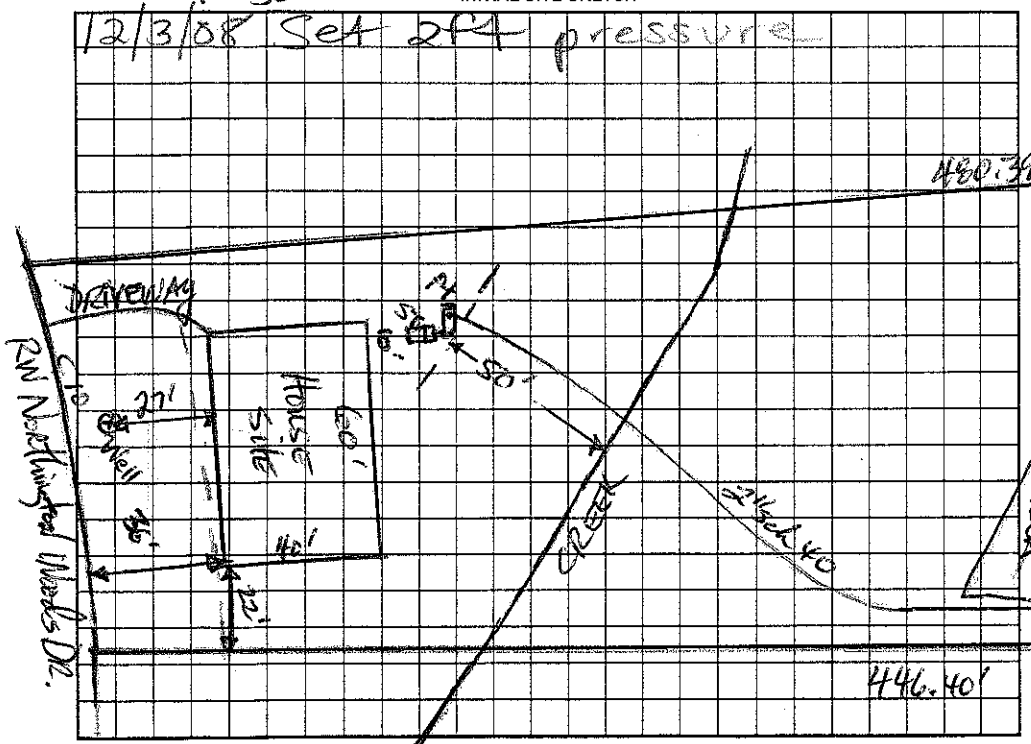

AS BUILT SKETCH

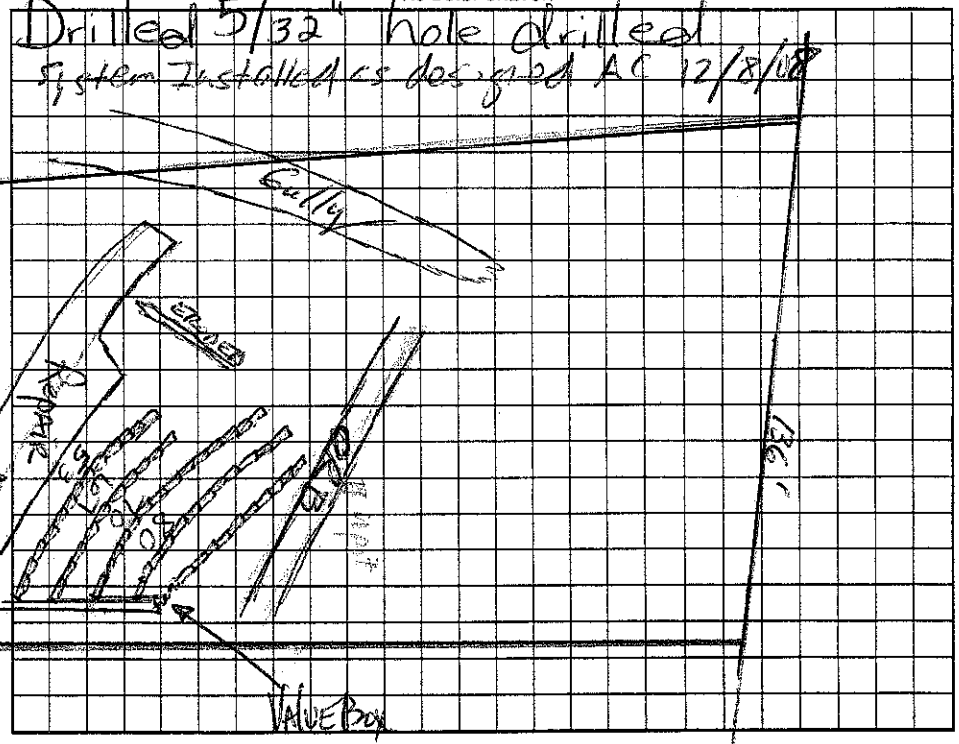

Permit can be suspended or revoked if any false information is supplied toward securing the permit/any unauthorized changes are made to the site/any unauthorized changes are made in the installation of the system. Improvement Permit with plat valid without expiration. Improvement Permit with site plan valid for sixty months. Authorization to Construct is valid for a period equal to that of Improvement Permit – not to exceed sixty months.

Signed: ____ date 5/16/05 Installed by: Richard Abernathy

Improvement Permit by: ____ date Jan 31, 05 Operation Permit by: Anthony Cohen, J R.S. date 12/8/08

Authorization to Construct by: ____ date 11/14/07 Existing System Inspection by: ____ date ____

HEALTH DEPT. COPY: WHITE OWNER COPY (FINAL): YELLOW OWNER COPY (INITIAL): PINK