IREDELL COUNTY HEALTH DEPARTMENT

IMPROVEMENT PERMIT / AUTHORIZATION TO CONSTRUCT / OPERATION PERMIT / EXISTING SYSTEM INSPECTION

STATESVILLE 704-878-5305 MOORESVILLE 704-664-5281

PERMIT# 122498

OWNER OR CONTRACTOR Shoemaker Dev. Group LLC - Touchstone Dev. PIN# 4635-64-0340.000 4639542071.000

ADDRESS 1143 D. Executive Circle, Garner N.C. 27511 PHONE: Business _____ Home _____

LOCATION TL Fern Hill Rd TL Northington Woods Dr. on Right DATE Jan 31, 05

SUBDIVISION Northington Woods BLOCK / SECTION _____ LOT 10 LOT AREA 1.33 Ac SITE CLASS. IS DESIGN FLOW 480 gpd L.T.A.R. .025-.03

Septic Tank: 1000 Gallons; STB 825 Date 8/16/04

Pump Tank: 1000 Gallons; PT 302 Date 6/20/05

Pump Make: Zoeller Model N-163 Serial No. _____

Nitrification Field: No Fields 1 Square Feet 1440 Linear Feet 480

No Lines 5 Trench Width 36" Max Trench Bottom Depth 36" Gravel Depth NA

☑ New System ☐ Repair System Type: I, II, III, IV, V, VI

System Description: Am 25% Reduction

Repair System Description: LPP PBS

Maintenance Agreement Required: ☐ Yes ☑ No

☐ Slab ☐ Crawl Space ☑ Basement w/plumbing ☐ Basement wo/plumbing

☑ House/Mod. Home ☐ Mobile Home ☐ Business ☐ Other

No. Bedrooms 4 No. Bathrooms ____ No. Employees ____


Water Supply: ☑ Individual ☐ Public ☐ Community

Comments:/Conditions:

Comments:/Conditions:

1"=50'

INITIAL SITE SKETCH

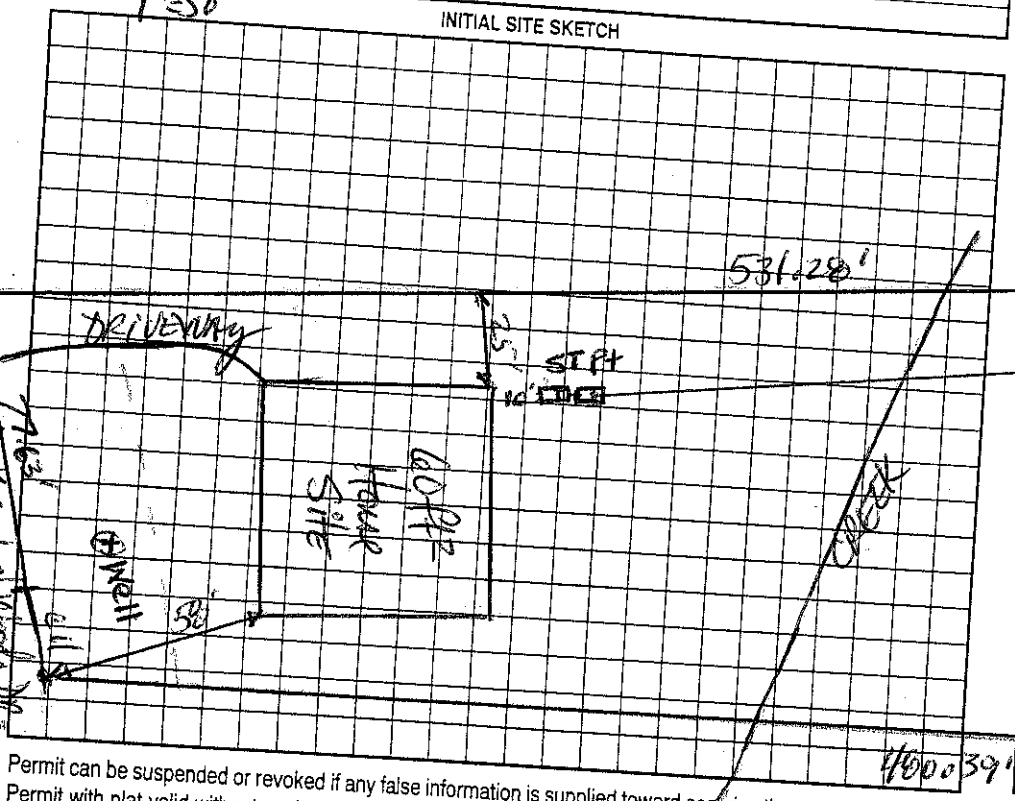

AS BUILT SKETCH



Permit can be suspended or revoked if any false information is supplied toward securing the permit/any unauthorized changes are made to the site/any unauthorized changes are made in the installation of the system. Improvement Permit with plat valid without expiration. Improvement Permit with site plan valid for sixty months. Authorization to Construct is valid for a period equal to that of Improvement Permit – not to exceed sixty months.

Signed: _____

Improvement Permit by: _____ date 5/16/05

Authorization to Construct by: _____ date Jan 31, 05

Installed by: Rowan Septic Tank

Operation Permit by: _____ date 6/13/06

Existing System Inspection by: _____ date 2/28/07

HEALTH DEPT. COPY: WHITE OWNER COPY (FINAL): YELLOW OWNER COPY (INITIAL): PINK