4:00 - 4:30

IREDELL COUNTY HEALTH DEPARTMENT

STATESVILLE 704-878-5305 MOORESVILLE 704-664-5281

IMPROVEMENT PERMIT / AUTHORIZATION TO CONSTRUCT / OPERATION PERMIT / EXISTING SYSTEM INSPECTION

PERMIT# 122656 PIN# 4639640340.071 4639542661 DATE 8-1-07

OWNER OR APPLICANT J&K Developers PHONE: Business 336 469-2180 Home 828 478-9099

ADDRESS 3843 Gordon St Terrell NC 28682

LOCATION Perth Rd N TL Fern Hill Rd TL Northington Woods approx 600ft on left

SUBDIVISION Northington Wds BLOCK / SECTION ____ LOT 71 LOT AREA .707 Acre SITE CLASS. PS DESIGN FLOW 480gpd L.T.A.R. .3+

Septic Tank: 1000 Gallons: STB 312 Date 4-30-07
Pump Tank: 1000 Gallons: PT 323 Date 4-9-07
Pump Make: Gould Model PE-5IM Serial No. ____
Nitrification Field: No Fields 1 Square Feet 540 Linear Feet 270
No Lines 6 Trench Width 24" min. Max Trench Bottom Depth 36"

☒ New System ☐ Repair ☐ Expansion System Type: I II III (IV) V VI
System Description: Pump-LP-Panel Block
Repair System Description: Same
Maintenance Agreement Required: ☒ Yes ☐ No

☒ House/Mod. Home No. Bedrooms 4
☐ Mobile Home No. Persons ____
☐ Business No. Employees ____
☐ Other ____


Water Supply: ☒ Individual ☐ Public ☐ Community

Gravel Depth N/A ☐ Gravity ☐ Pressure ☐ Slab ☐ Crawl Space ☐ Basement w/plumbing ☐ Basement wo/plumbing


Comments/Conditions: 100' setback to well
Must keep Pool site at least 15ft from tanks & "Repair Area"

Comments/Conditions: Note: Keep System out of Old Road Bed (Drainfield)
8/20/07 Checked tanks, lines & pumps.
8/21/07 Elect & alarm Checked

Scale 1:50 INITIAL SITE SKETCH

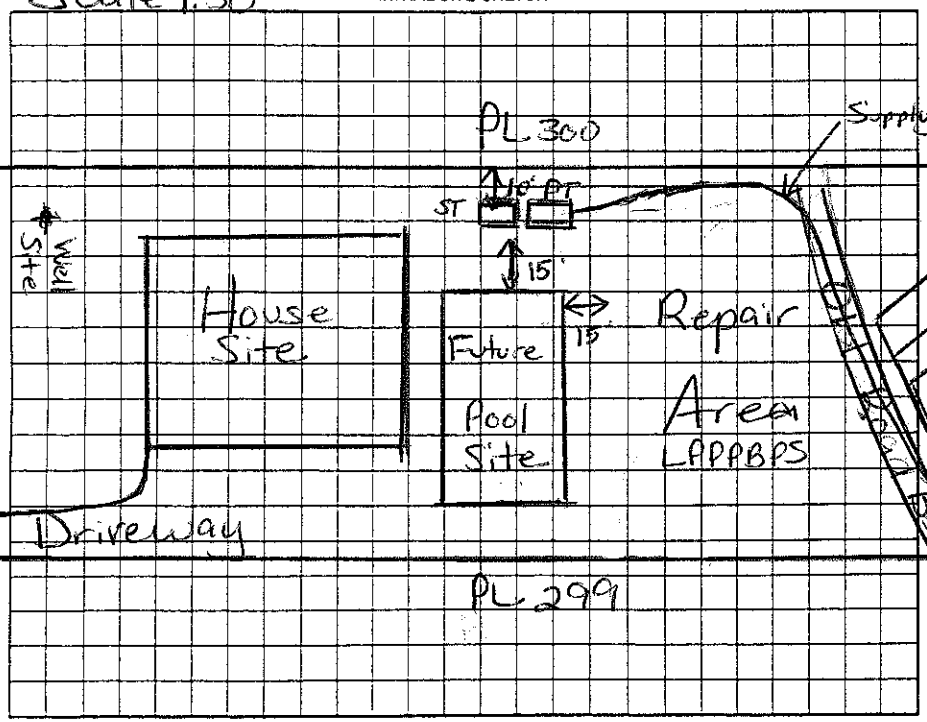

AS BUILT SKETCH Installed and Drawn

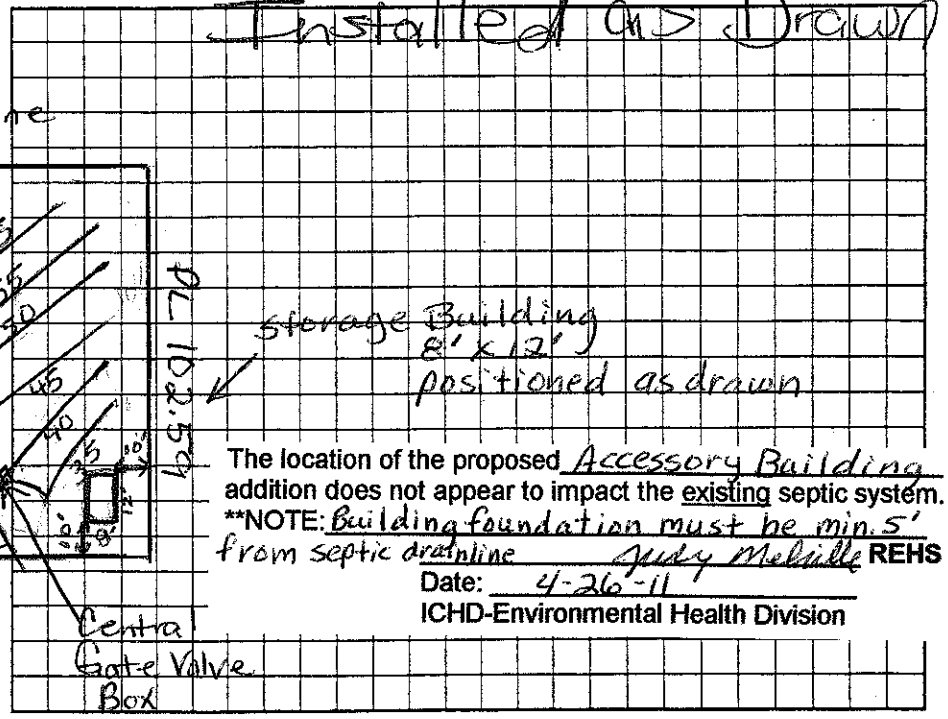

The location of the proposed Accessory Building addition does not appear to impact the existing septic system.
**NOTE: Building foundation must be min. 5' from septic drainline Judy Melville REHS
Date: 4-26-11
ICHD-Environmental Health Division

Permit can be suspended or revoked if any false information is supplied toward securing the permit/any unauthorized changes are made to the site/any unauthorized changes are made in the installation of the system. Improvement Permit with plat valid without expiration ☐ Improvement Permit with site plan valid for sixty months ☐ Authorization to Construct is valid for a period equal to that of Improvement Permit – not to exceed sixty months.

Signed: Grady Higgins date 8-2-07
Improvement Permit by: Maint. Hlth. Dotson RS date 8/1/07
Authorization to Construct by: Maint. Hlth. Dotson RS date 8/1/07

Installed by: Richard Abernathy RS
Operation Permit by: Maint. Hlth. Dotson RS date 8/23/07
Existing System Inspection by: ____ date ____

HEALTH DEPT. COPY: WHITE OWNER COPY (FINAL): YELLOW OWNER COPY (INITIAL): PINK