IREDELL COUNTY HEALTH DEPARTMENT

STATESVILLE 704-878-5305 MOORESVILLE 704-664-5281 3130

IMPROVEMENT PERMIT / AUTHORIZATION TO CONSTRUCT / OPERATION PERMIT / ~~EXISTING SYSTEM~~ INSPECTION

PERMIT# 122654 pd PIN# 4639-64-0340.070 658-5514 Victoria 4639-54-3534 DATE April 12, 2005

OWNER OR CONTRACTOR Shoemaker Dev Corp LLC / JAVIER CHAVEZ PHONE: Business Dev Home

ADDRESS 1143 S. Executive Circle Cary, N.C. 27511

LOCATION Rowan Rd N. / TL Ferry Hill TL Northington Woods Dr. approx 700' on left.

SUBDIVISION Northington Woods BLOCK / SECTION LOT 70 LOT AREA .713 Ac SITE CLASS RS DESIGN FLOW 480 gpd L.T.A.R. .25-.3

Septic Tank: 1000 Gallons; STB 825 Date 2-28-08
Pump Tank: 1000 Gallons; PT 302 Date 10-2-07
Pump Make: Zoeller Model N52-B Serial No.
Nitrification Field: No Fields 1 Square Feet 125 Linear Feet 425
No Lines 5@85' Trench Width 36" Max Trench Bottom Depth 30"

☑ New System ☐ Repair System Type: I, II, III, IV, V, VI
System Description: Pm 25% Reduction
Repair System Description: LPPPBPS
Maintenance Agreement Required: ☐ Yes ☑ No initially

☑ House/Mod. Home No. Bedrooms 2+
☐ Mobile Home No. Bathrooms
☐ Business No. Employees
☐ Other


Water Supply: ☑ Individual ☐ Public ☐ Community

Gravel Depth NA ☐ Slab ☑ Crawl Space ☐ Basement w/plumbing ☐ Basement wo/plumbing

Comments:/Conditions:
Do not cut house site, Backfill against rear foundation and create shallow surface swale to a maximum of 10' behind home.

Comments:/Conditions: 4/23/08 Installed Quick Up & Checked Tanks & Pressure
Drainfield > 15ft from House

INITIAL SITE SKETCH 1"=50'

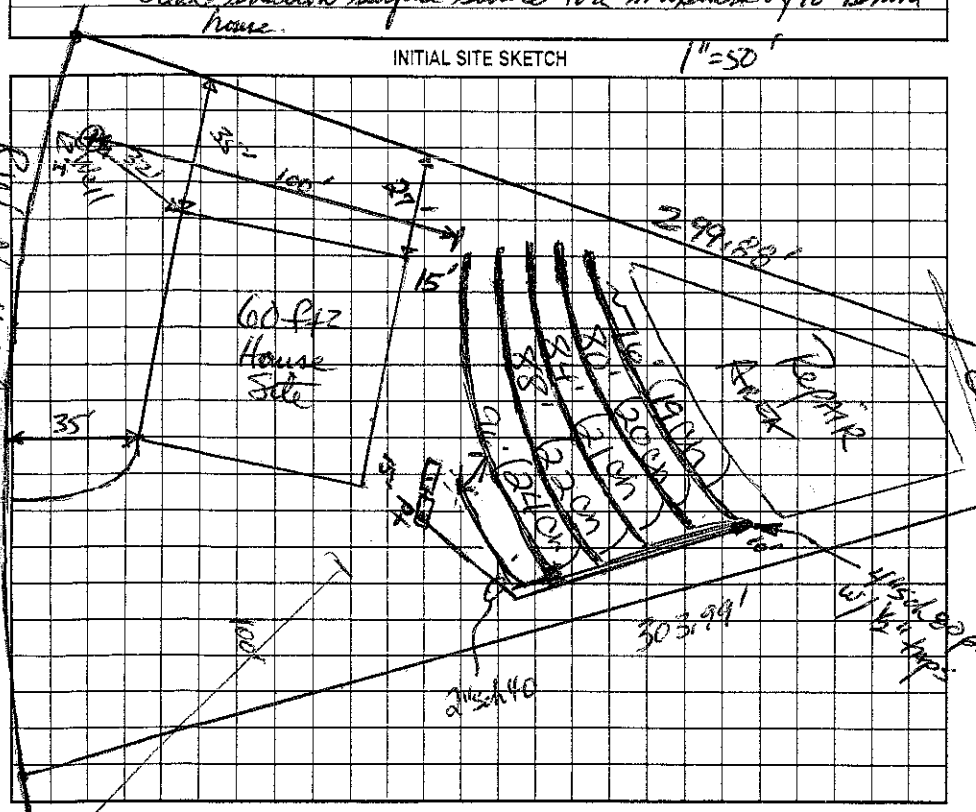

AS BUILT SKETCH

The proposed / existing SHED addition does not appear to impact the existing septic system.
**NOTE: MAY NEED TO BE REMOVED IF SYSTEM REPAIR IS REQUIRED
R.S.
Date: APPROVED JUN 25 2014
ICHD-Environmental Health Division

Permit can be suspended or revoked if any false information is supplied toward securing the permit/any unauthorized changes are made to the site/any unauthorized changes are made in the installation of the system. Improvement Permit with plat valid without expiration. Improvement Permit with site plan valid for sixty months. Authorization to Construct is valid for a period equal to that of Improvement Permit - not to exceed sixty months.

Signed: [signature] date 5-16-05 Installed by: Rowan Septic RS

Improvement Permit by: [signature] date 4-12-05 Operation Permit by: Maria A Dotson date 7/25/08

Authorization to Construct by: Wesley Sparks R.S. date 12/19/07 Existing System Inspection by: date

HEALTH DEPT. COPY: WHITE OWNER COPY (FINAL): YELLOW OWNER COPY (INITIAL): PINK