IREDELL COUNTY HEALTH DEPARTMENT

STATESVILLE 704-878-5305 MOORESVILLE 704-664-5281 3:30

IMPROVEMENT PERMIT / AUTHORIZATION TO CONSTRUCT / OPERATION PERMIT / EXISTING SYSTEM INSPECTION

PERMIT# 122654 PIN# 4639-64-0340.070 658.5514 Victoria 4639-54-3534 DATE April 12, 2005

OWNER OR CONTRACTOR Shavender Dev Group LLC / JAVIER CHAVEZ PHONE: Business Dev Home

ADDRESS 1143 B Executive Circle Cary, N.C. 27511

LOCATION Perth Rd N. / TL Fern Hill TL Northington Woods Dr. Approx 700' on left.

SUBDIVISION Northington Woods BLOCK / SECTION LOT 70 LOT AREA .713 Ac SITE CLASS. PS DESIGN FLOW 480 gpd L.T.A.R. .25-.3

Septic Tank: 1000 Gallons; STB 825 Date 2-28-08

Pump Tank: 1000 Gallons; PT 302 Date 10-2-07

Pump Make: Zoeller Model N152-B Serial No.

Nitrification Field: No Fields 1 Square Feet 1275 Linear Feet 425

No Lines 5@85± Trench Width 36" Max Trench Bottom Depth 30" Gravel Depth NA

☑ New System ☐ Repair System Type: I, II, III, IV, V, VI

System Description: pm 25% Reduction

Repair System Description LPP BPS

Maintenance Agreement Required: ☐ Yes ☑ No initially

☑ House/Mod. Home No. Bedrooms 4

☐ Mobile Home No. Bathrooms

☐ Business No. Employees

☐ Other

☐ Slab ☑ Crawl Space ☐ Basement w/plumbing ☐ Basement wo/plumbing


Water Supply: ☑ Individual ☐ Public ☐ Community

Comments:/Conditions:

Do not cut house site. Backfill against rear foundation and create shallow surface swale to a maximum of 10' behind house.

Comments:/Conditions: 4/23/08 Installed Quick 4 & checked Tanks & pressure Drainfield > 15 ft from House

INITIAL SITE SKETCH 1" = 50'

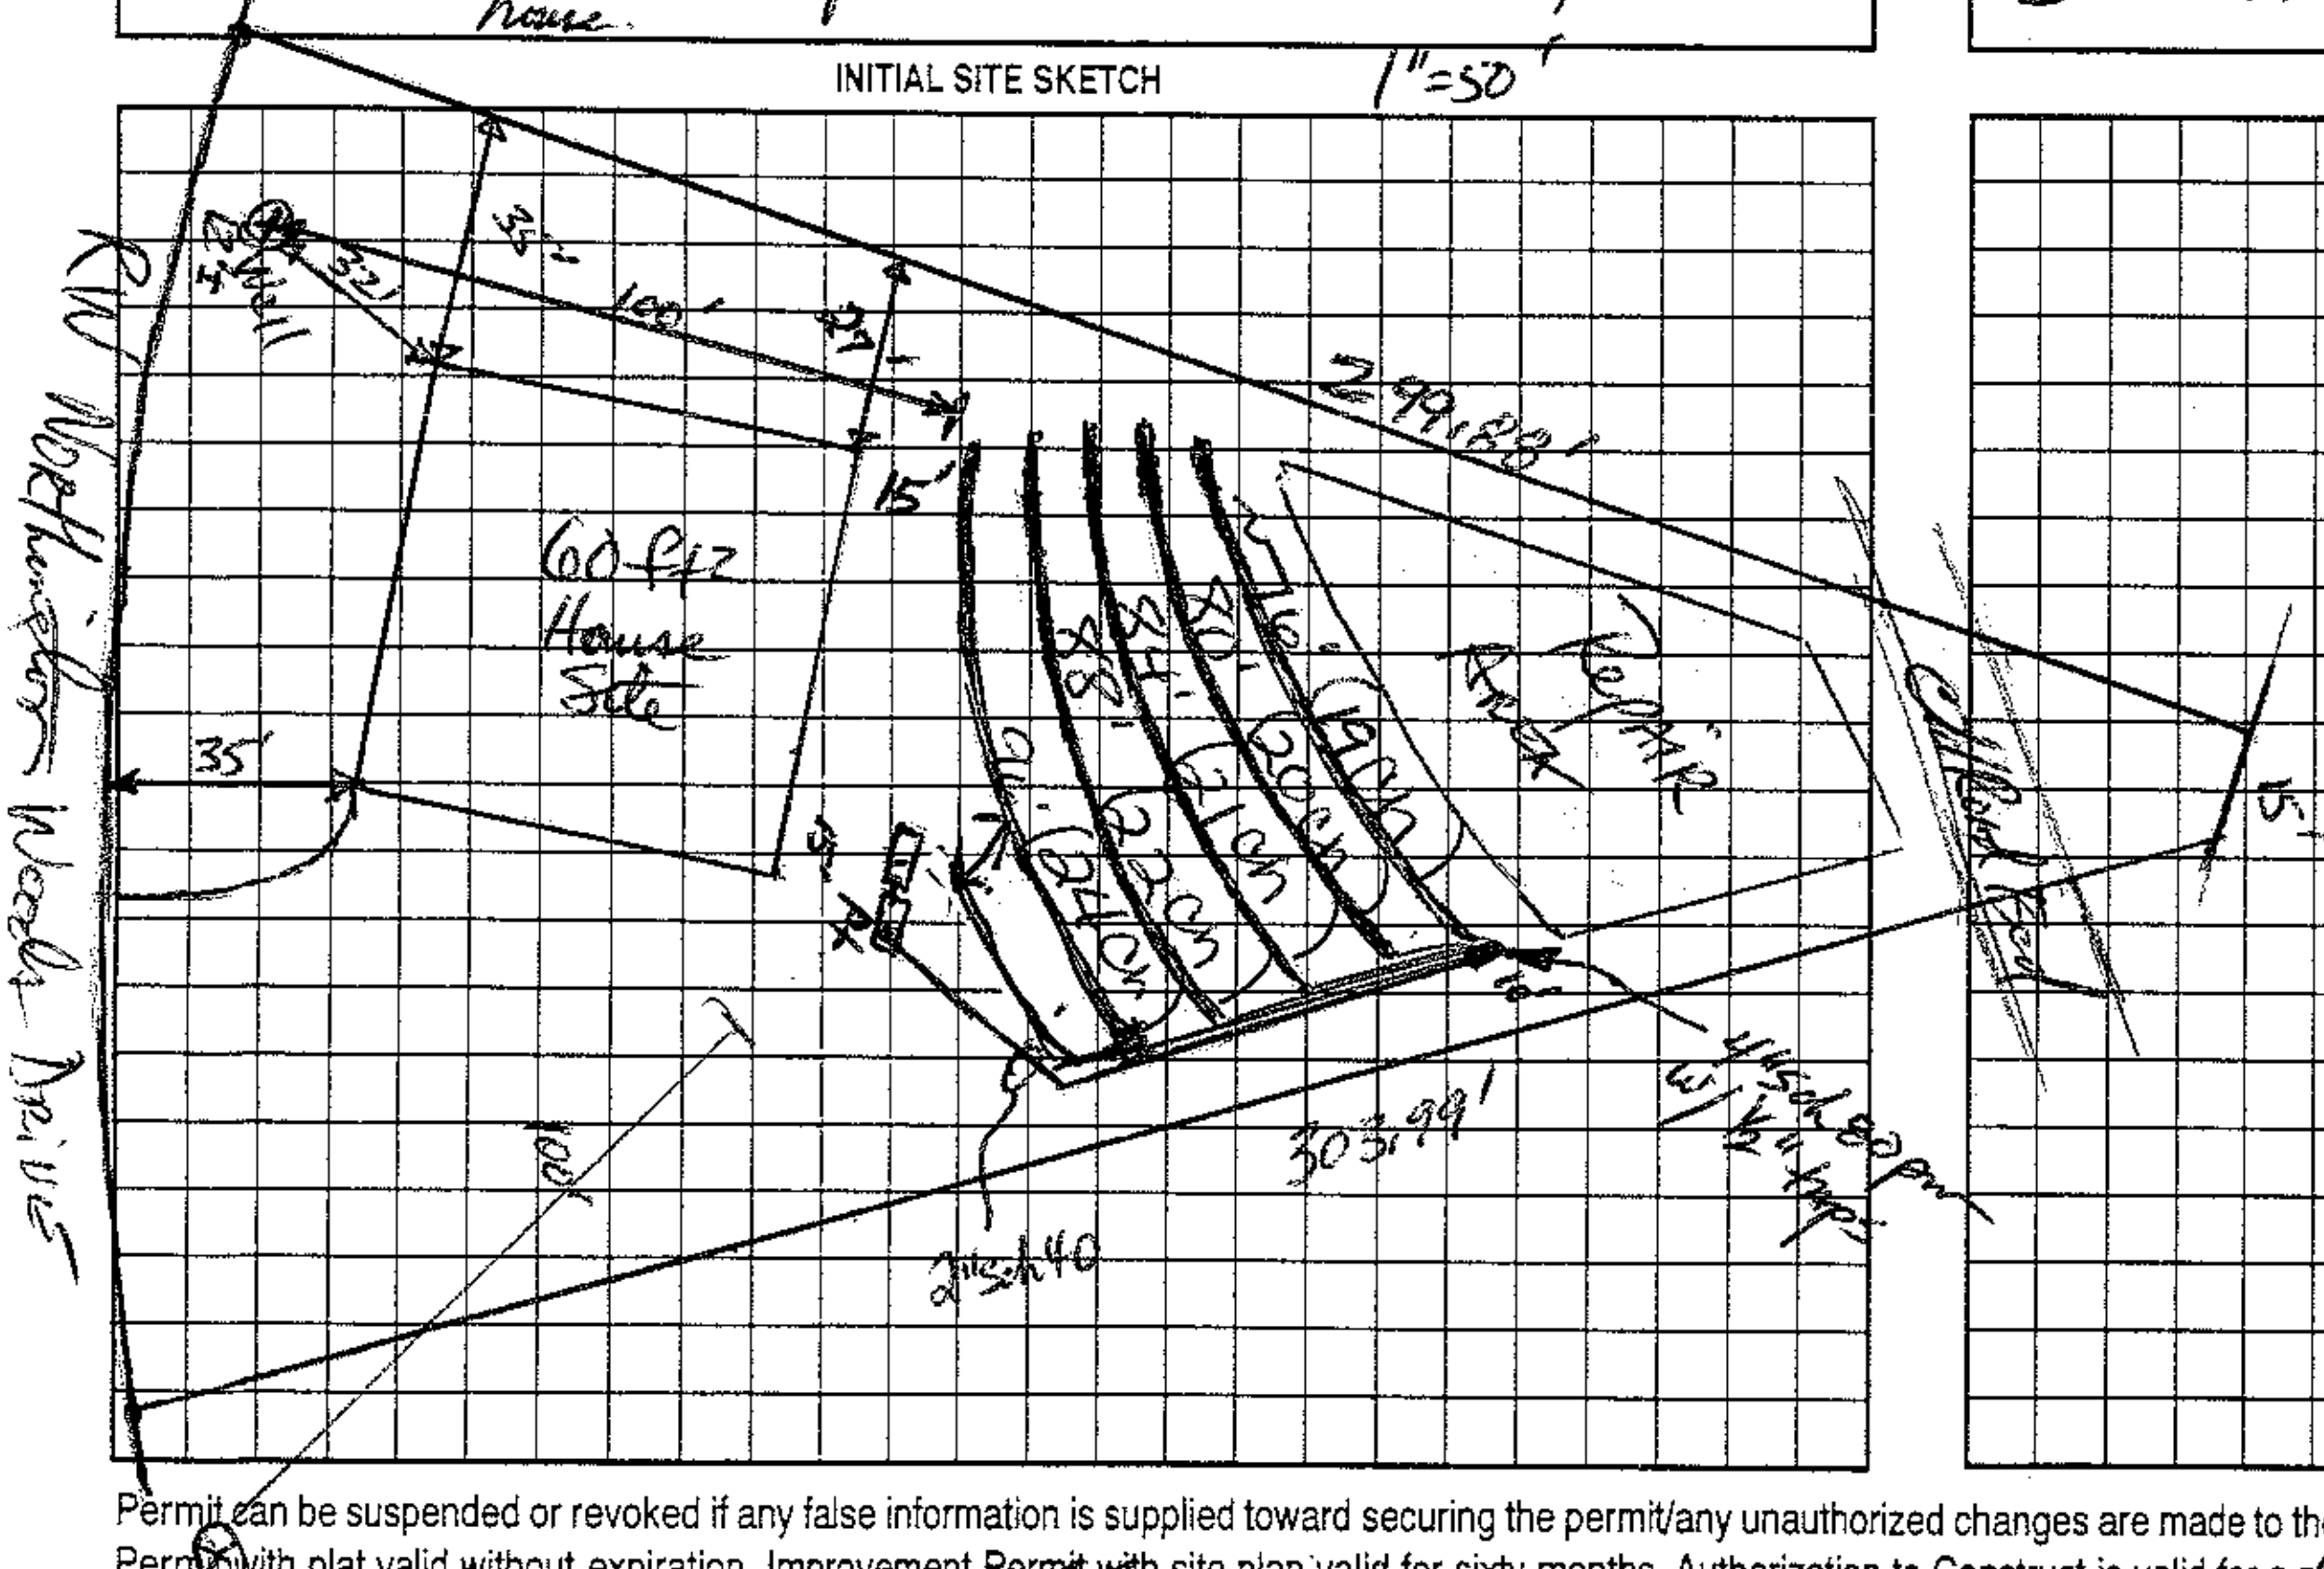

AS BUILT SKETCH

Permit can be suspended or revoked if any false information is supplied toward securing the permit/any unauthorized changes are made to the site/any unauthorized changes are made in the installation of the system. Improvement Permit with plat valid without expiration. Improvement Permit with site plan valid for sixty months. Authorization to Construct is valid for a period equal to that of Improvement Permit - not to exceed sixty months.

Signed: [signature] date 5-16-05

Improvement Permit by: [signature] date 4-12-05

Authorization to Construct by: Wesley Sparks R.S. date 12/19/07

Installed by: Rowan Septics

Operation Permit by: [signature] date 7/25/08

Existing System Inspection by: date

HEALTH DEPT. COPY: WHITE OWNER COPY (FINAL): YELLOW OWNER COPY (INITIAL): PINK